


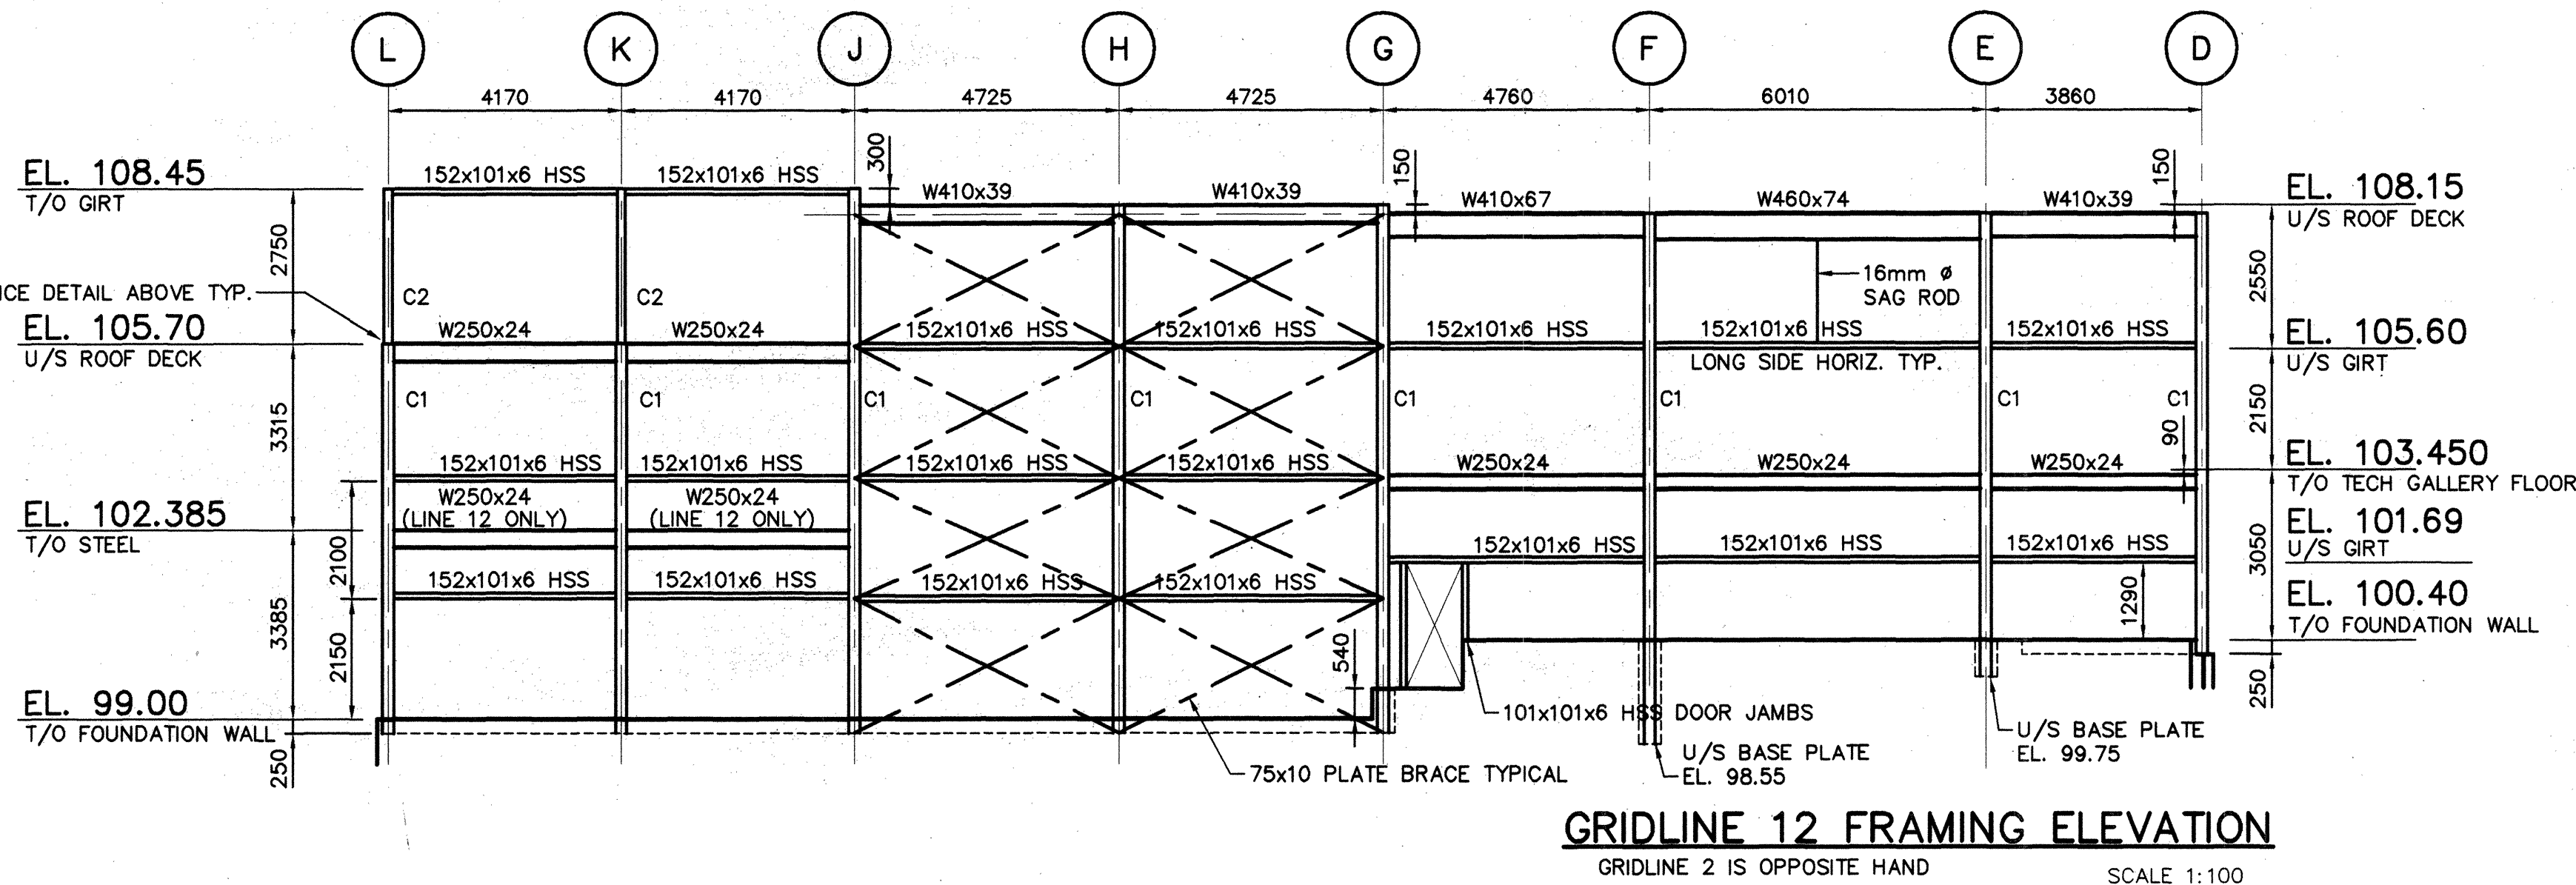
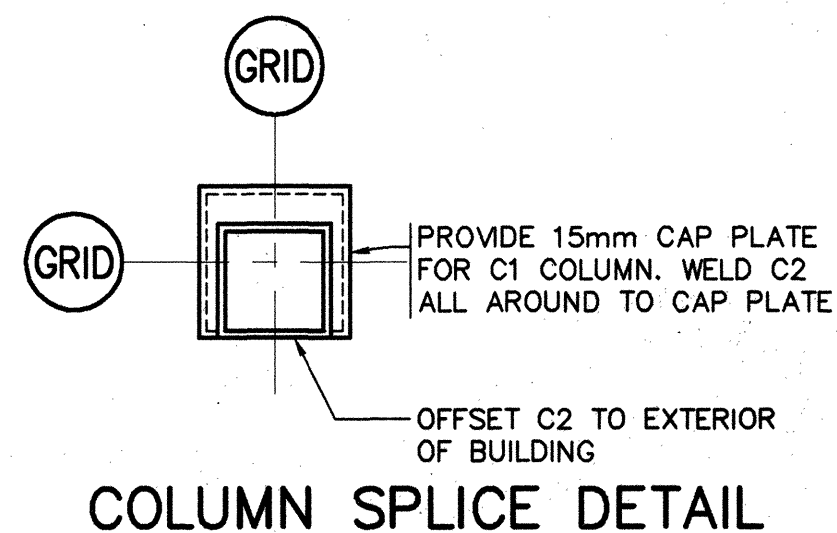
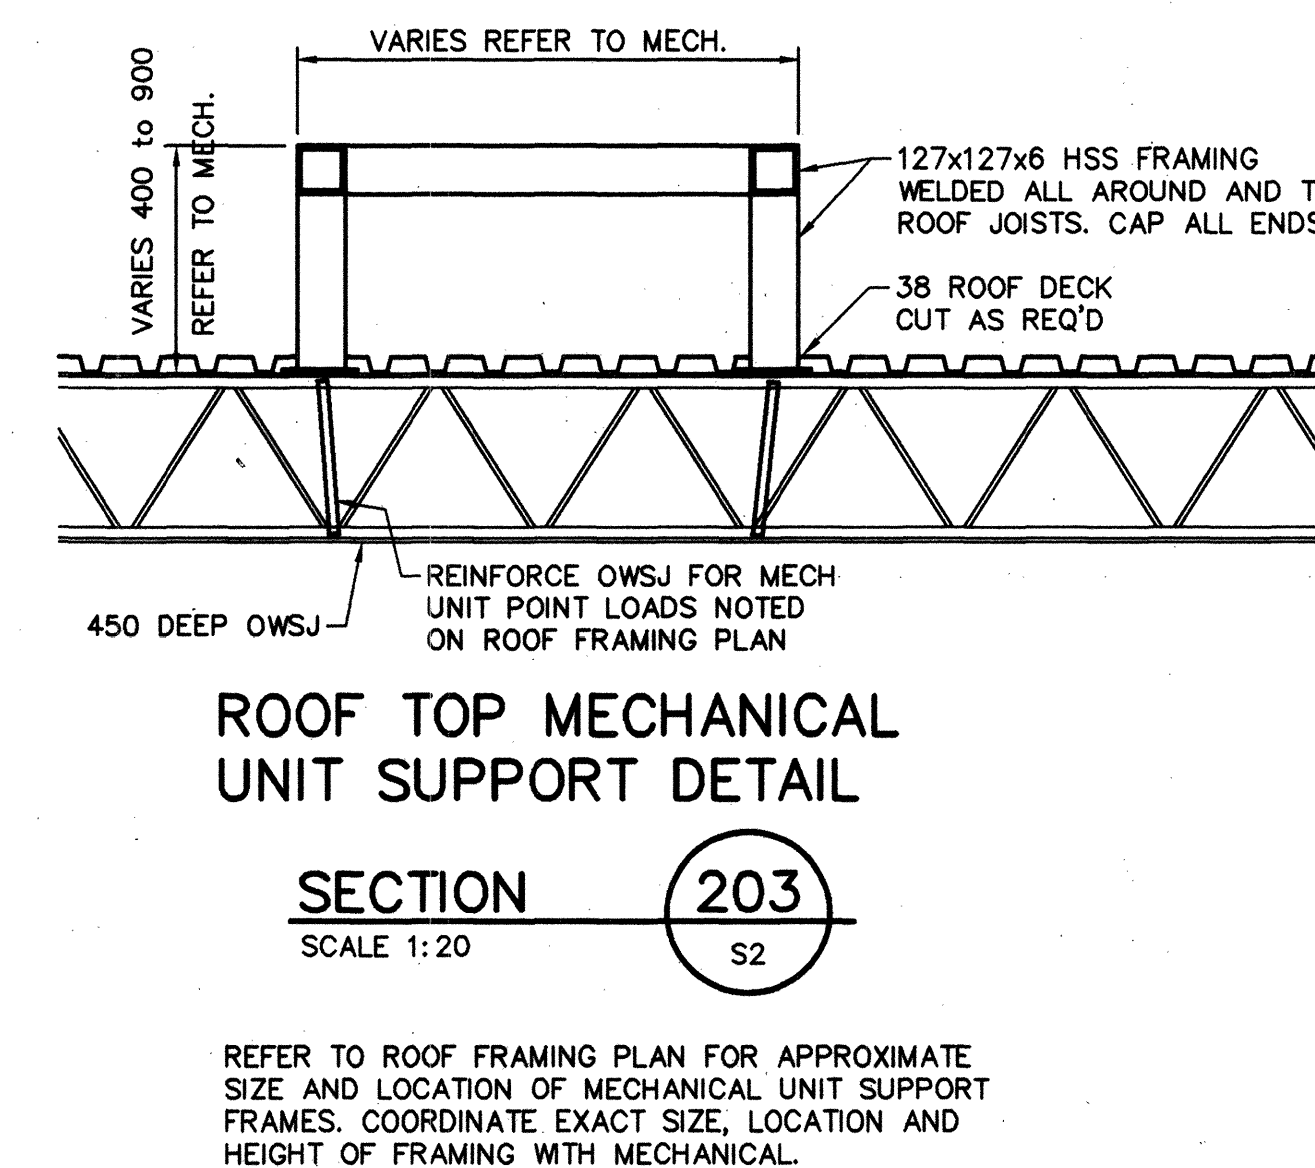
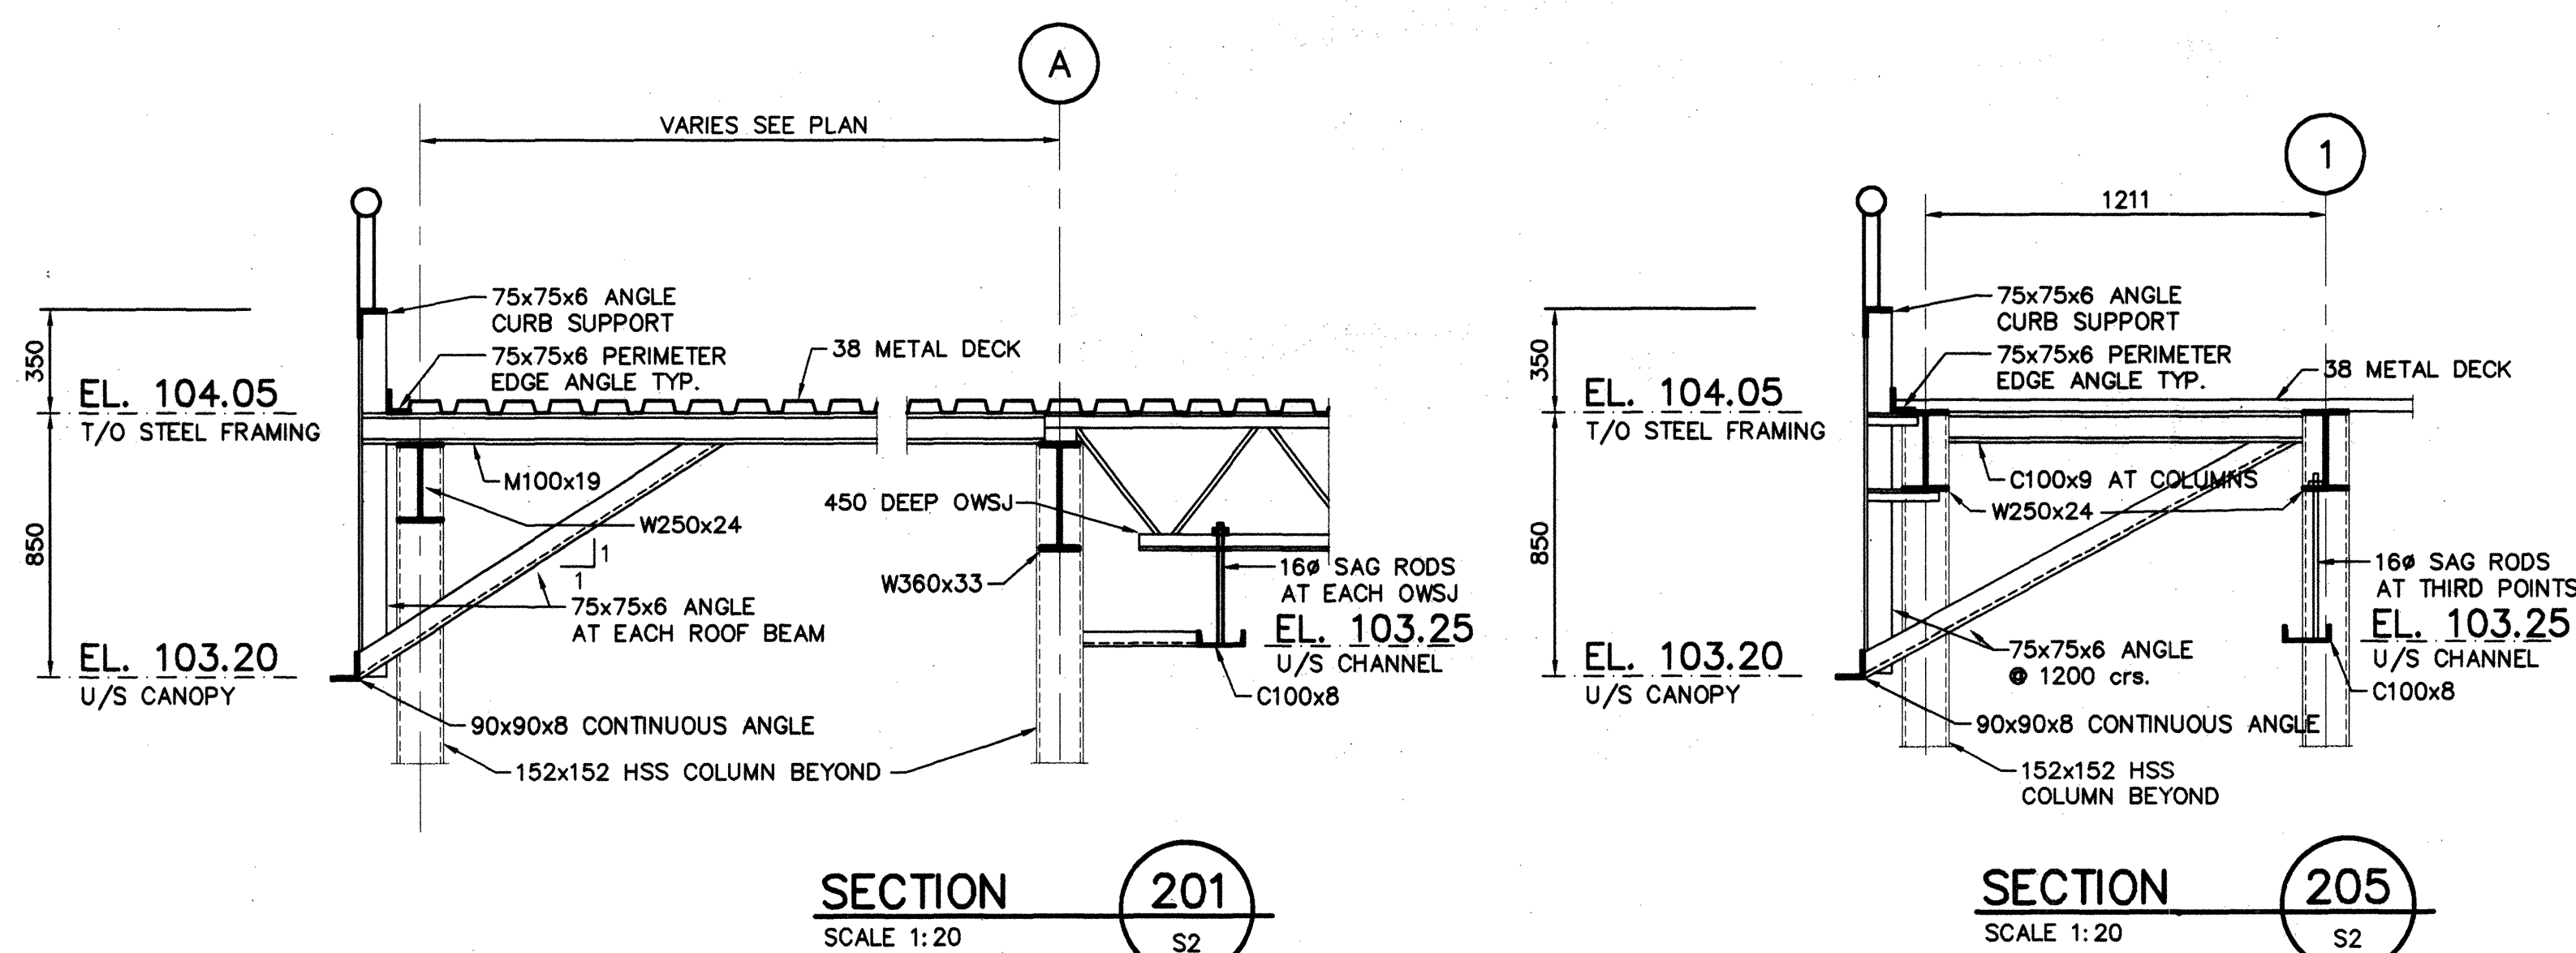


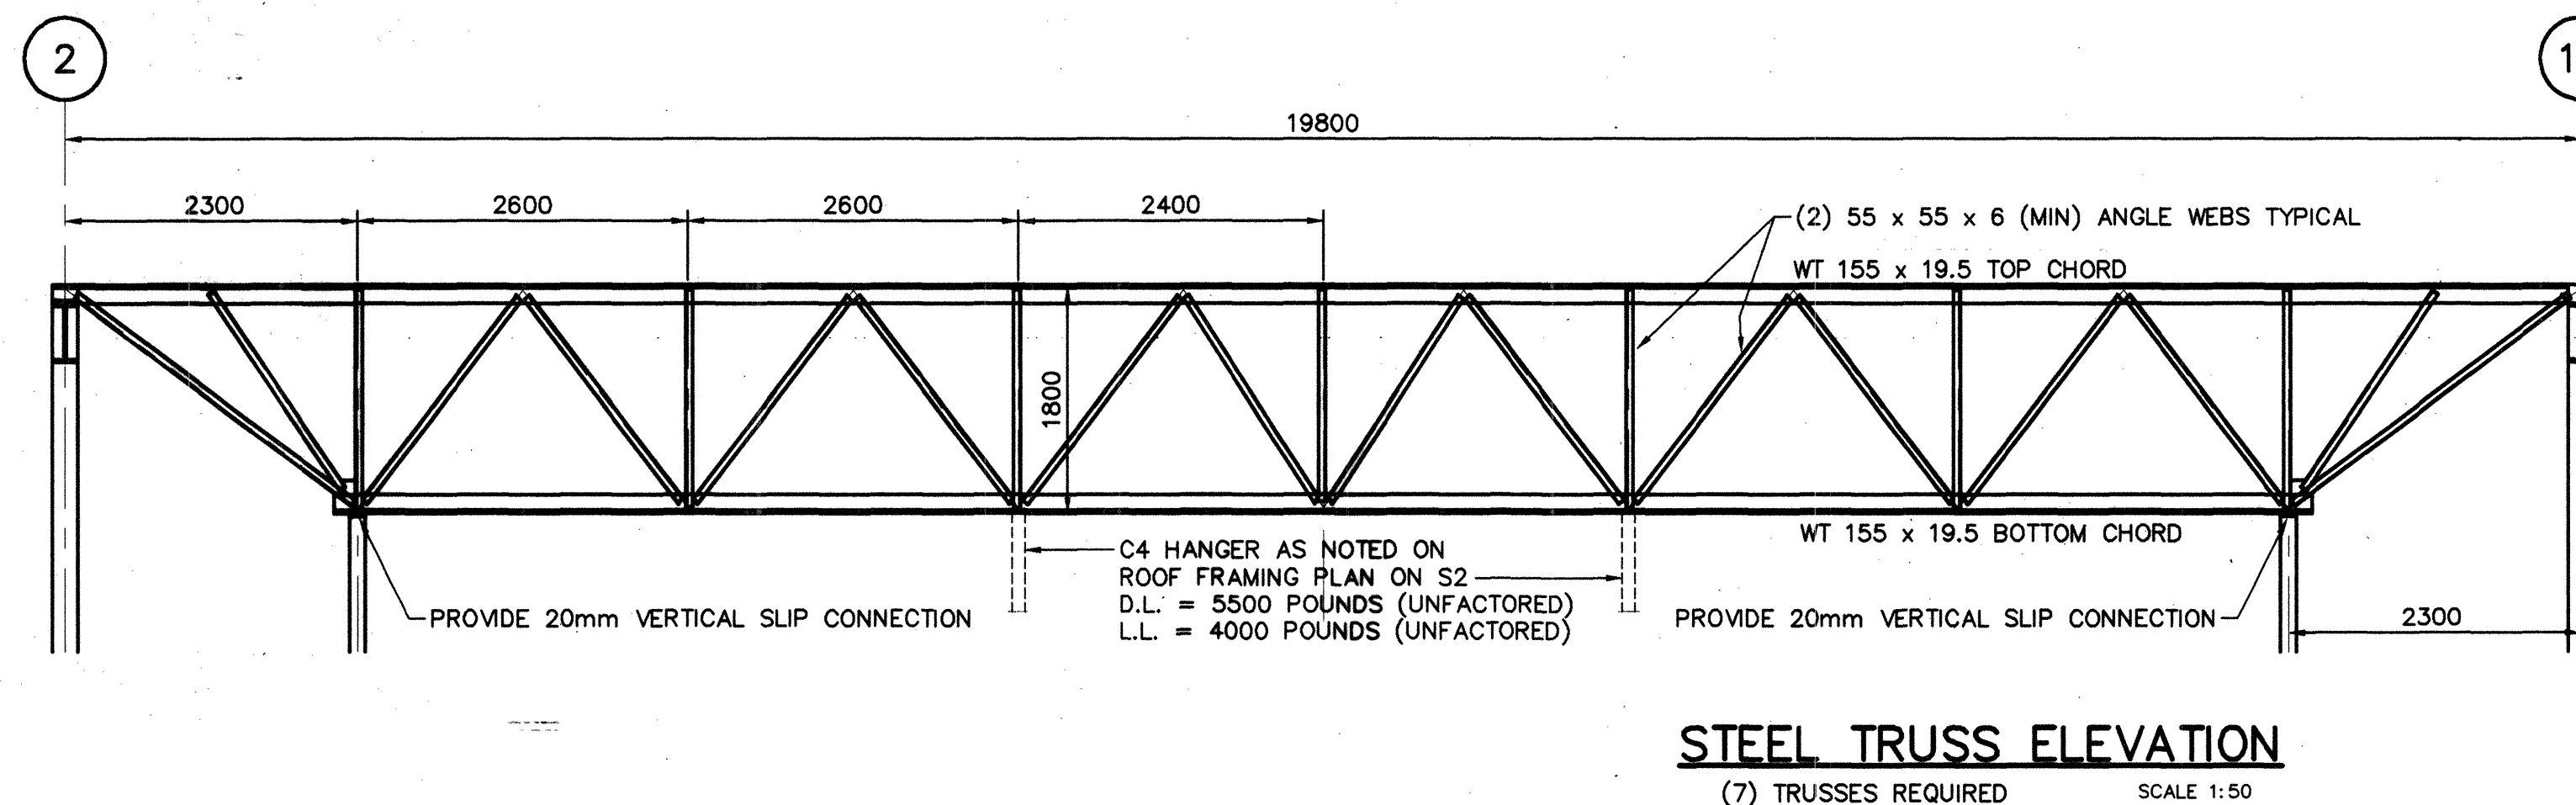

MARK	SIZE
C1	203x203x10 HSS
C2	152x152x8 HSS
C3	127x127x6 HSS
C4	76x76x6 HSS

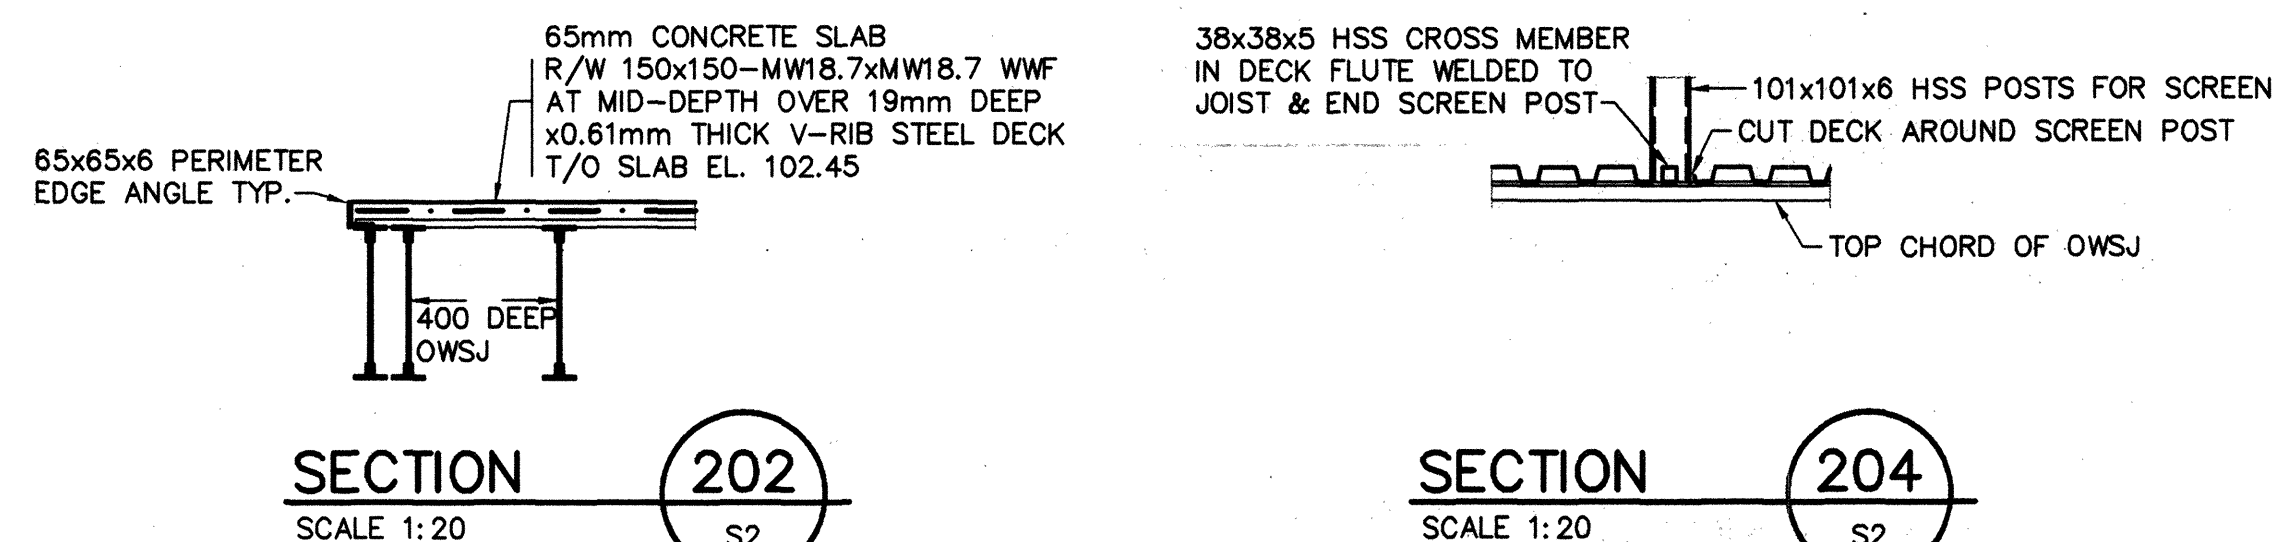

NO.	REVISION	DATE
1	ISSUED FOR TENDER	15/5/95
NO.	ISSUE	DATE

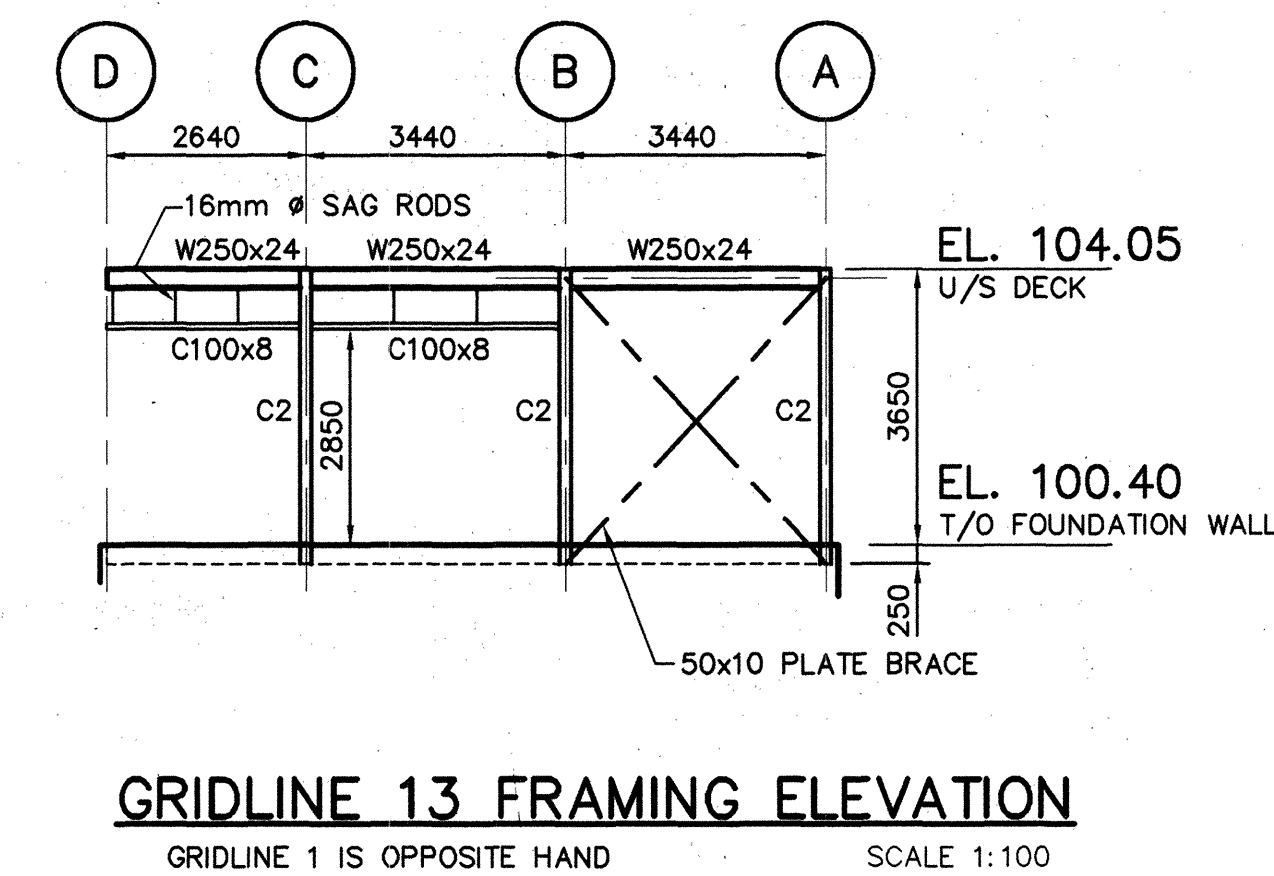

RECORD DRAWING
PRODUCED FROM INFORMATION PROVIDED BY CONTRACTOR
date: MARCH 1, 1996 Tmc
J.L. RICHARDS & ASSOCIATES LIMITED

J.L. Richards & Associates Limited
Consulting Engineers, Architects & Planners
864 LADY ELLEN PLACE, OTTAWA, CANADA K1Z 5K2

Lett/Smith Architects - Design Consultants

PROJECT: CITY OF KANATA
THE
RON MASLIN
PLAYHOUSE
Kanata, Ontario

DRAWING: STEEL FRAMING ELEVATIONS
AND SECTIONS

DESIGN: JDK	REVISION NO.:
DRAWN: TM	DRAWING NO.:
CHECKED: JJK	S4 of 5
DATE: MAY 1995	JOB NO.:
SCALE: AS NOTED	14456