

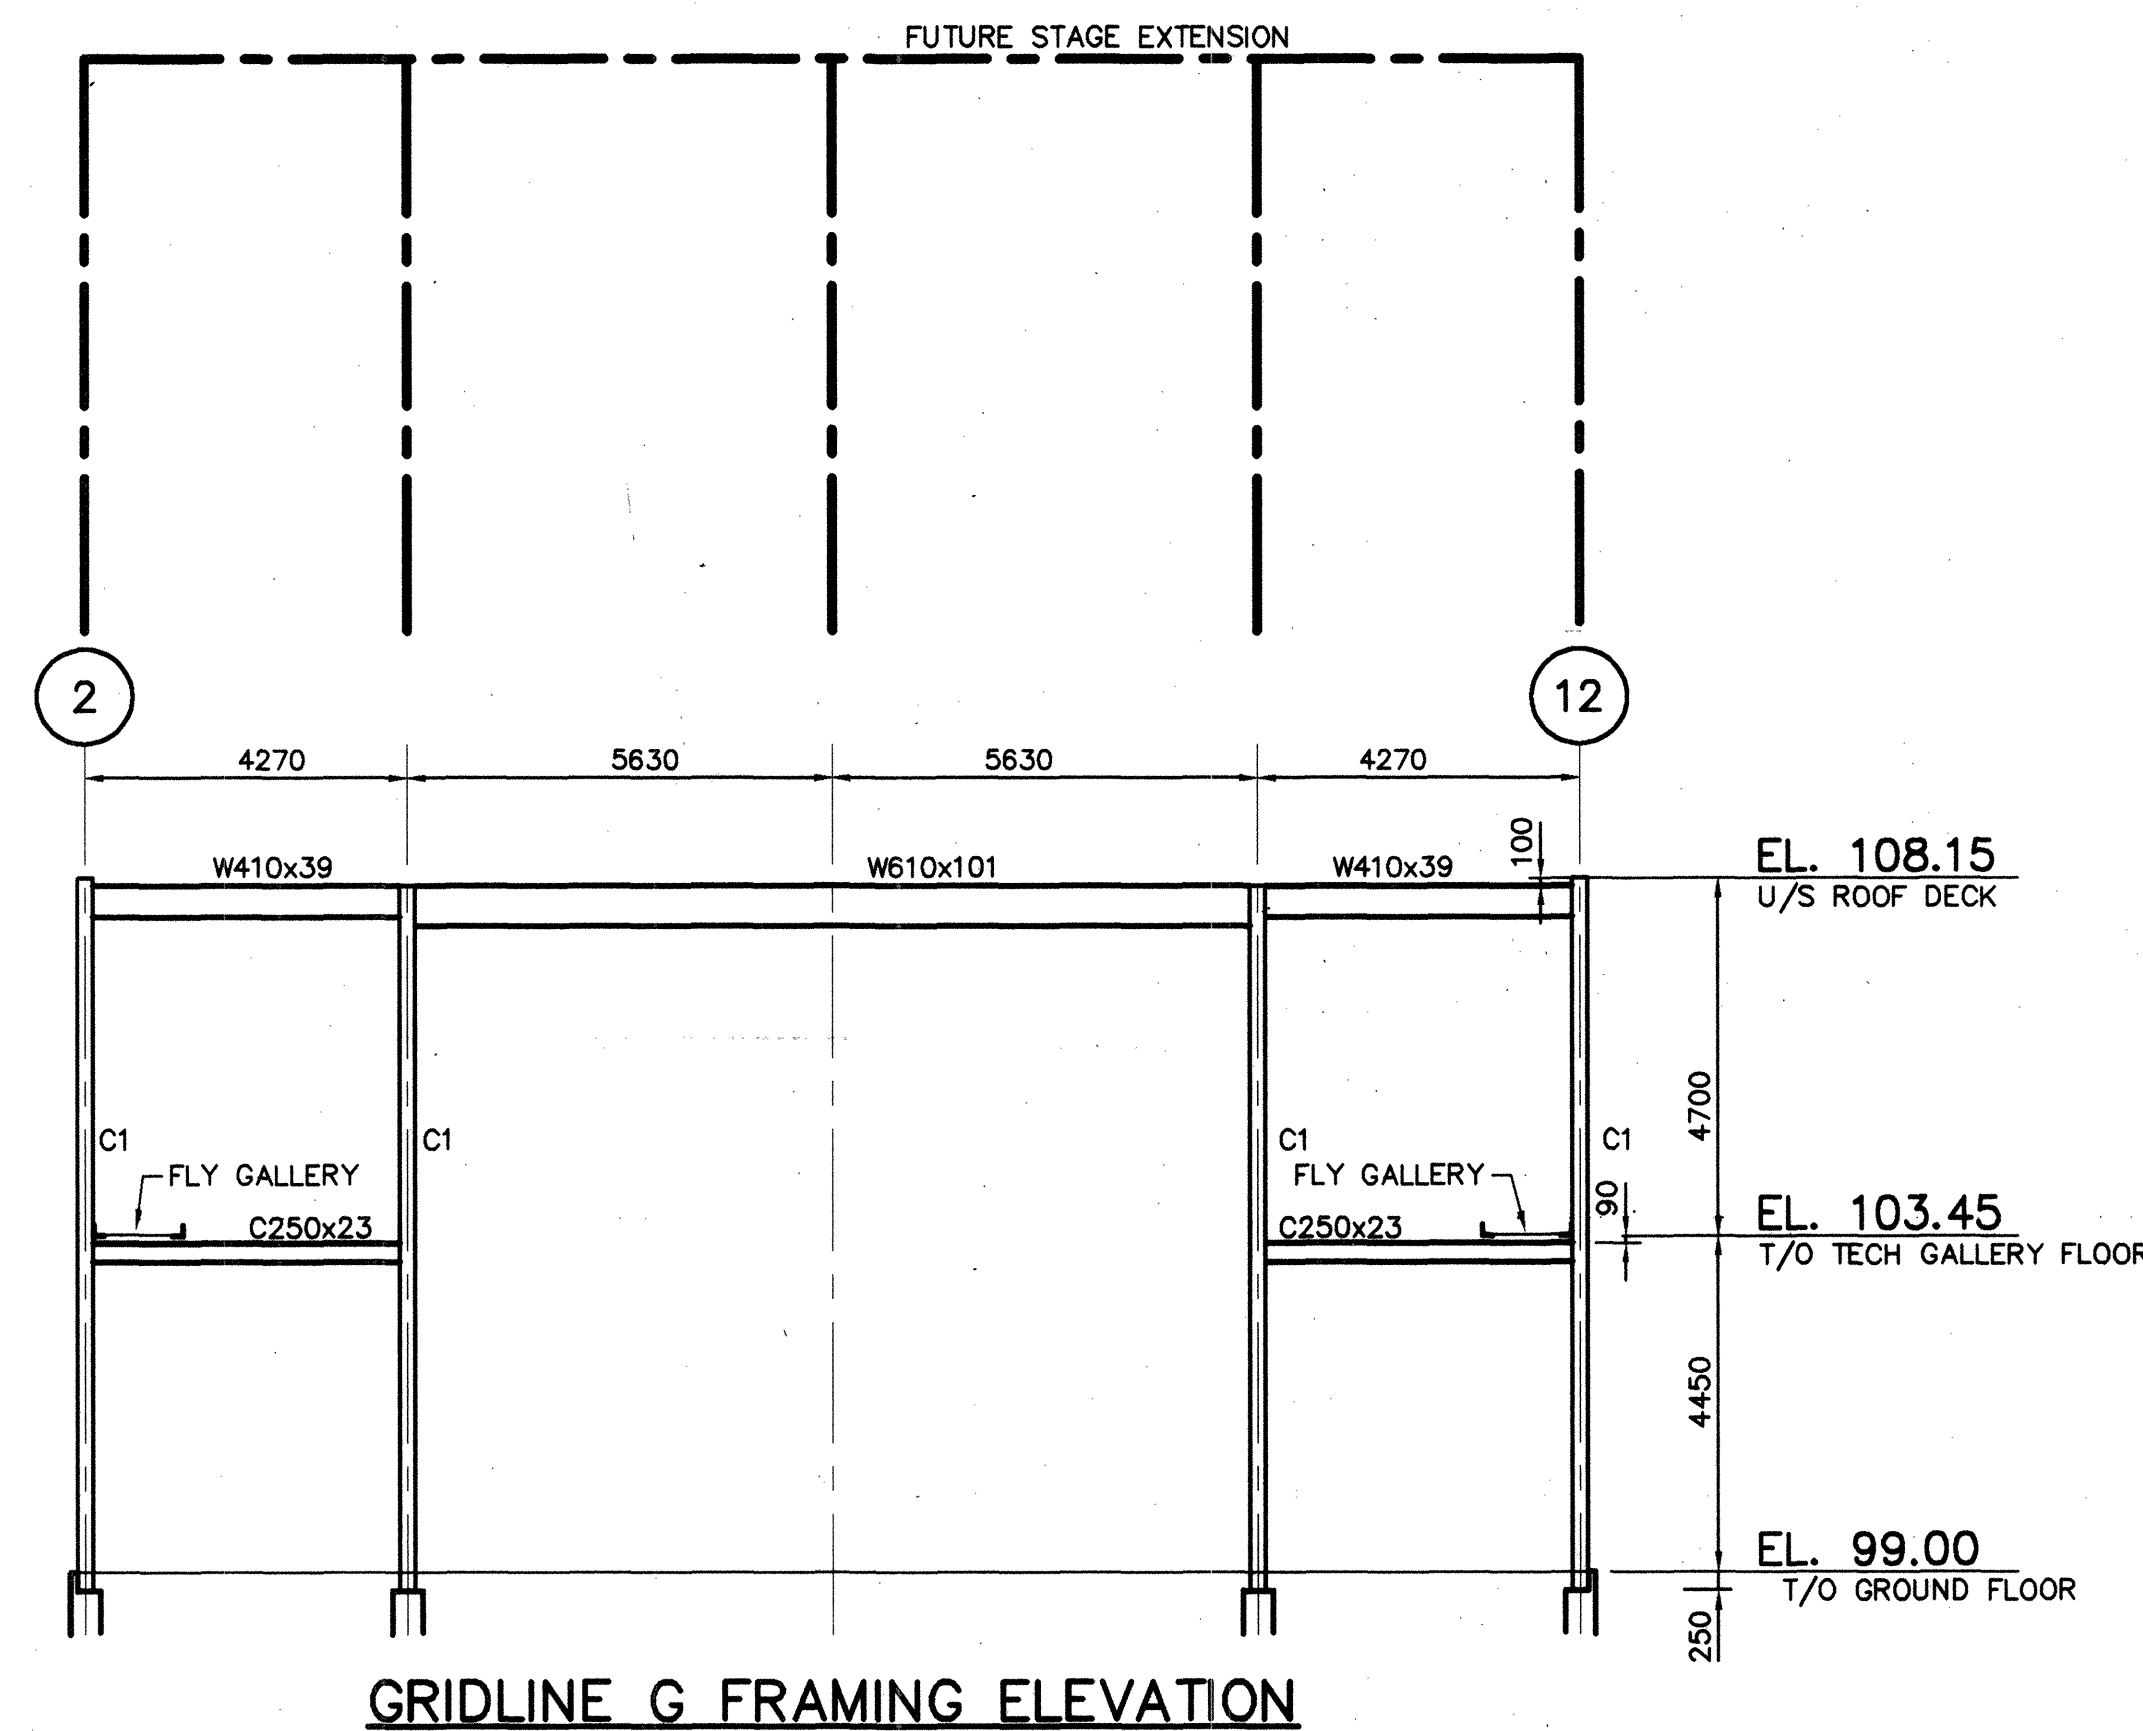
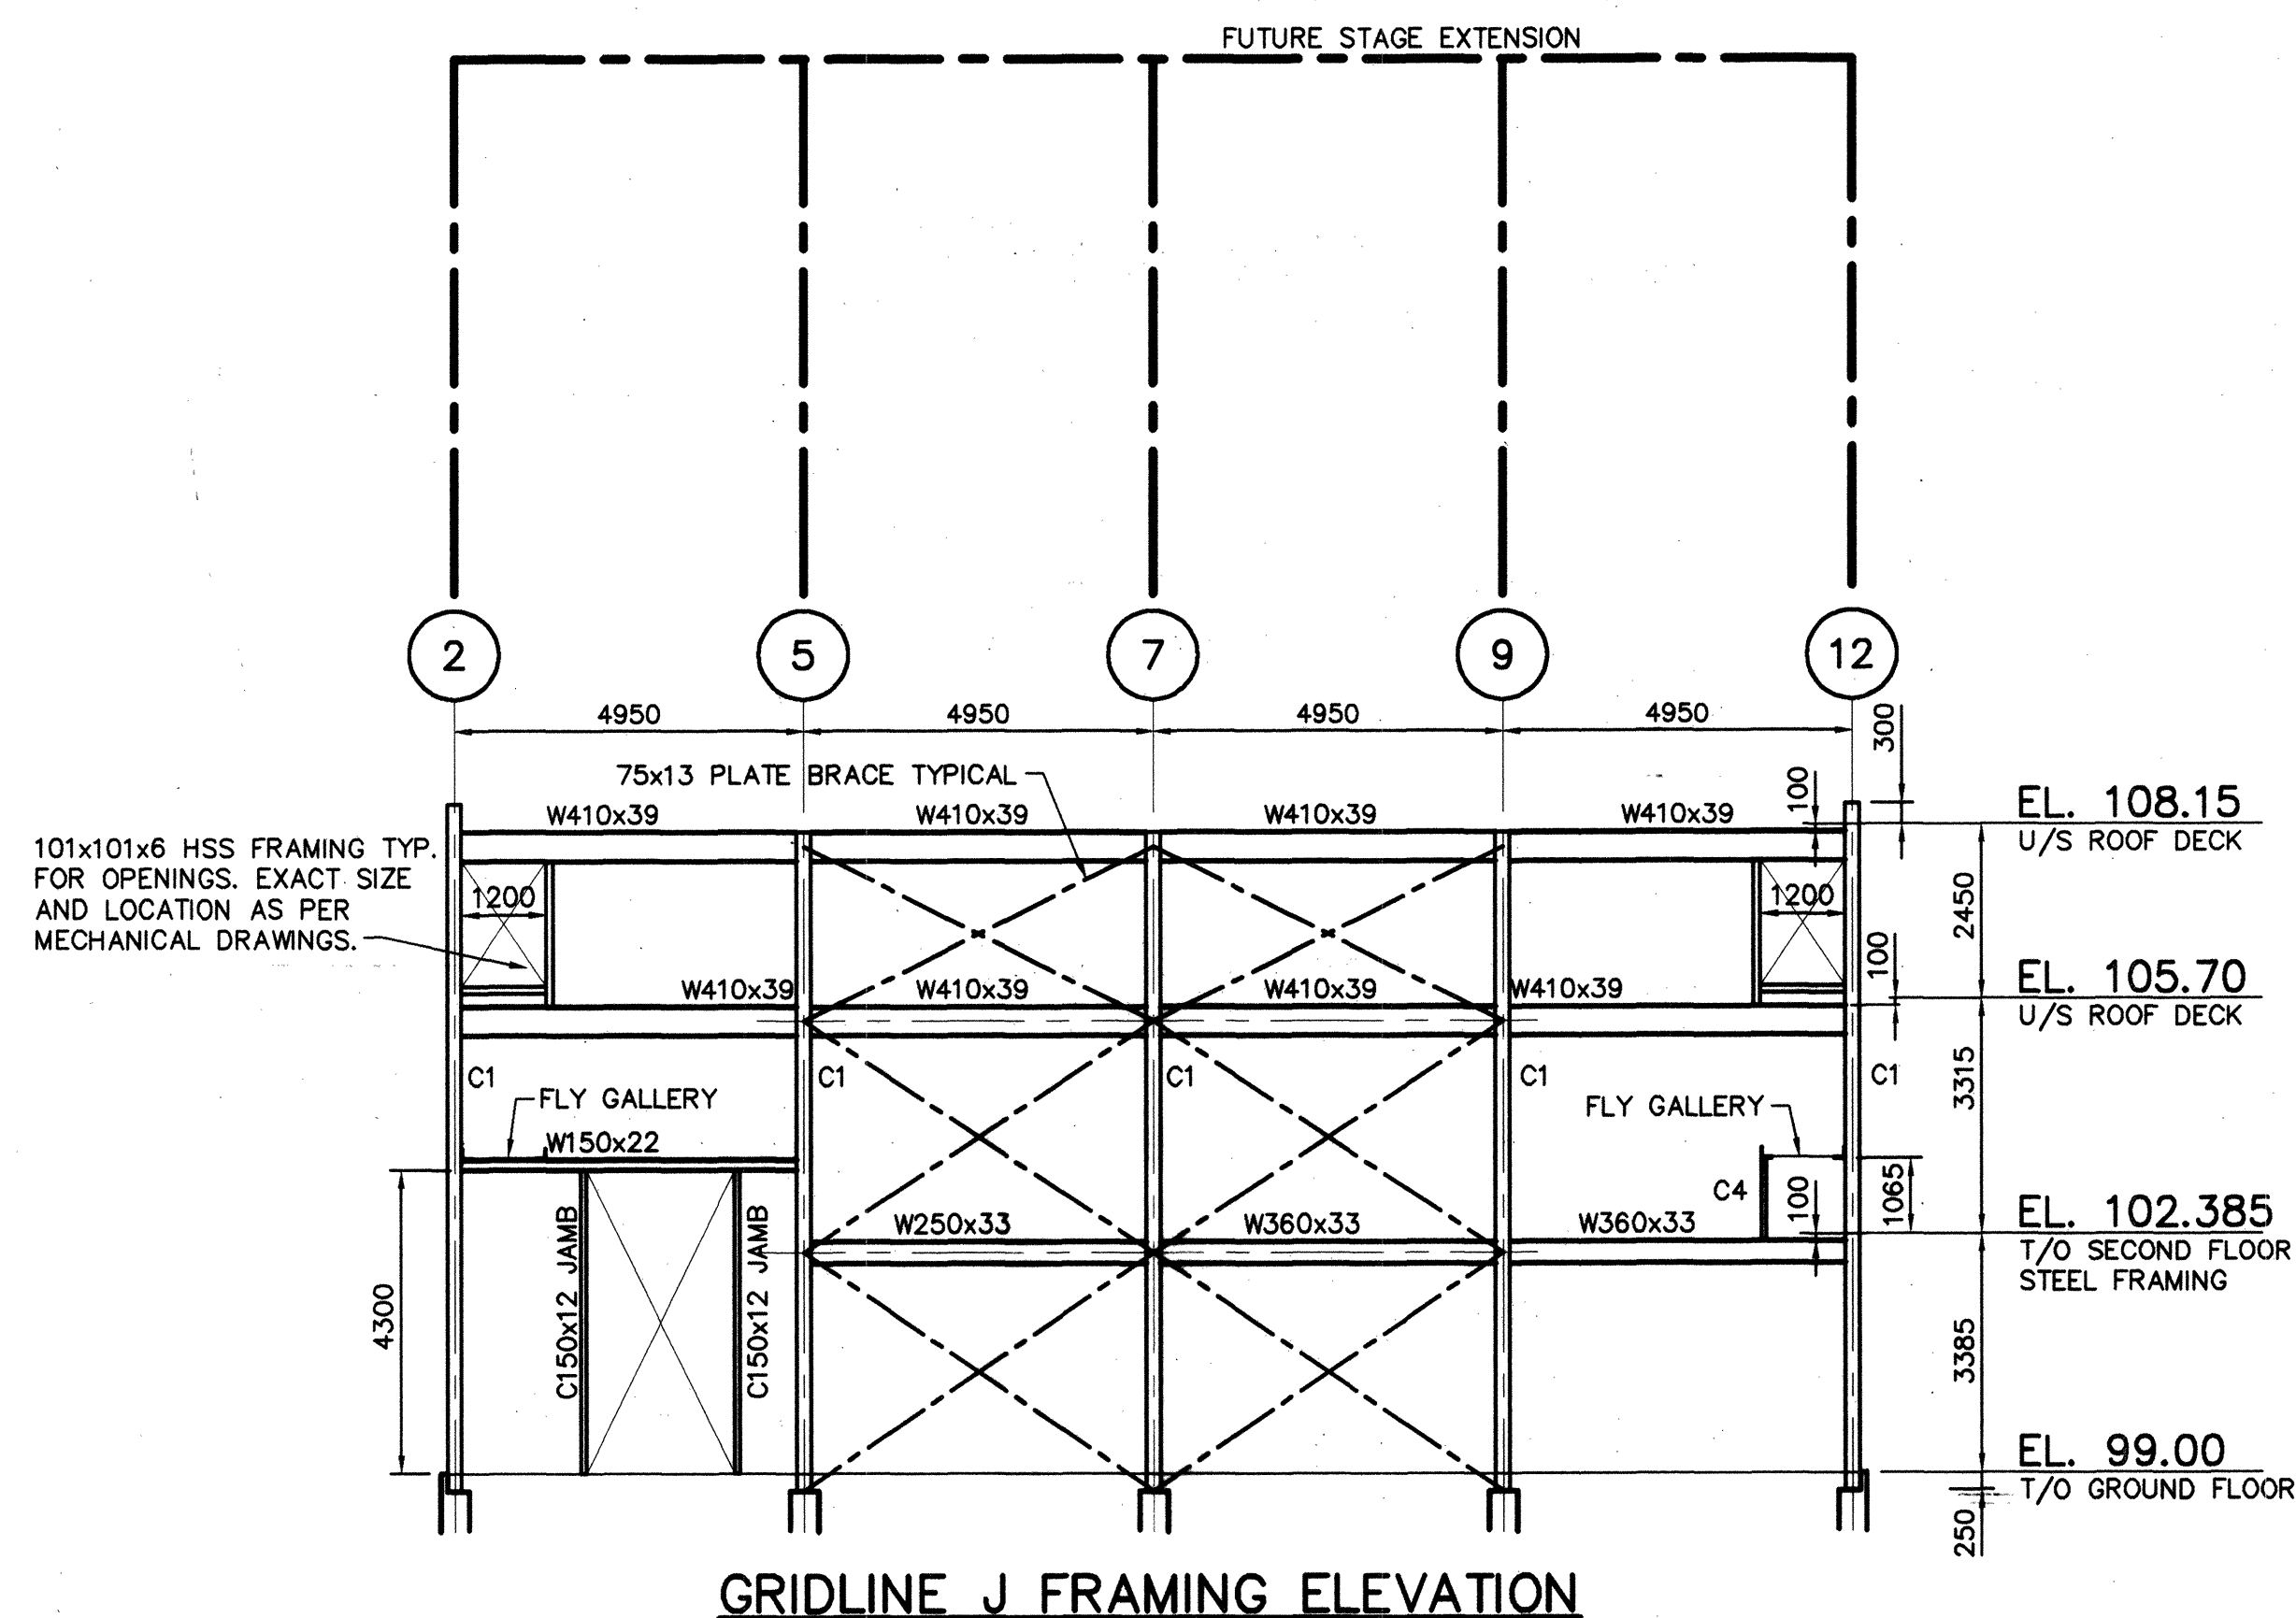
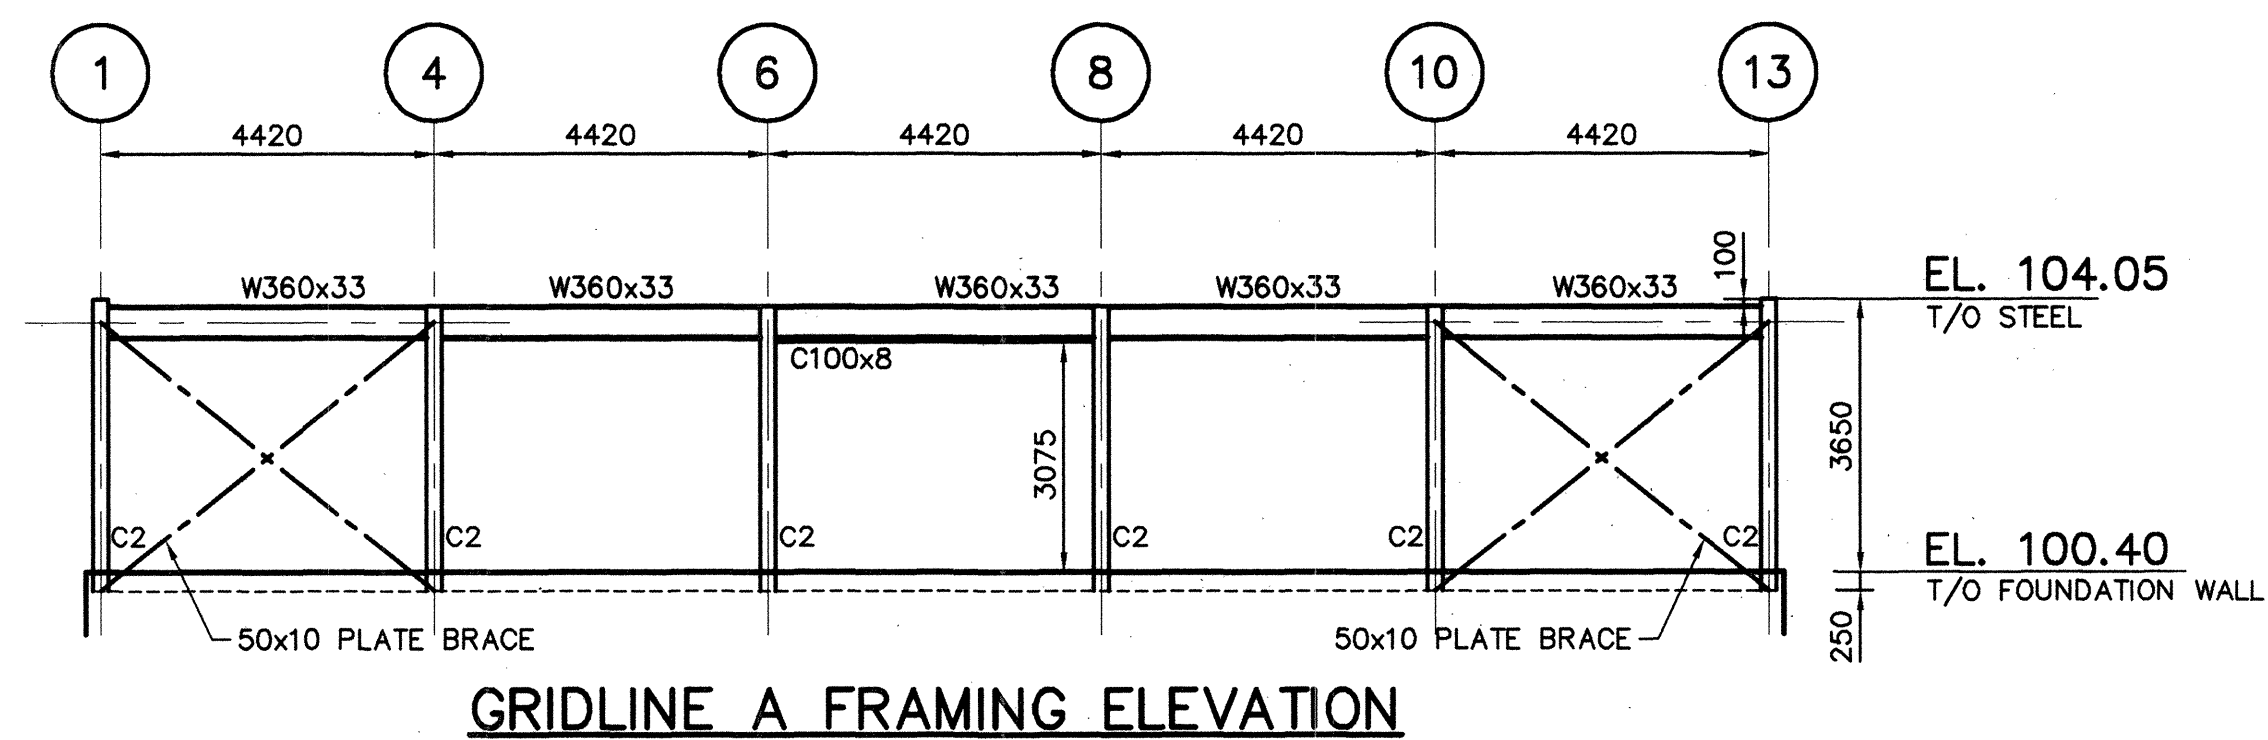
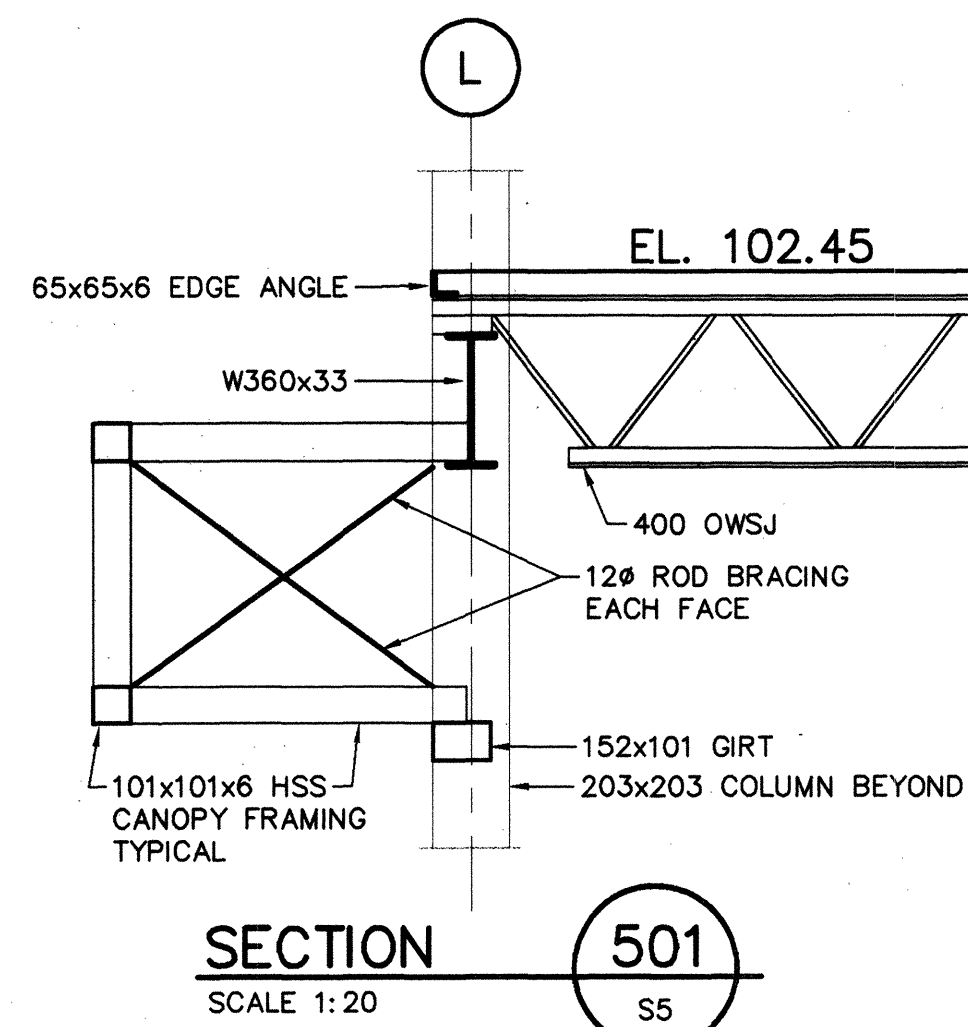


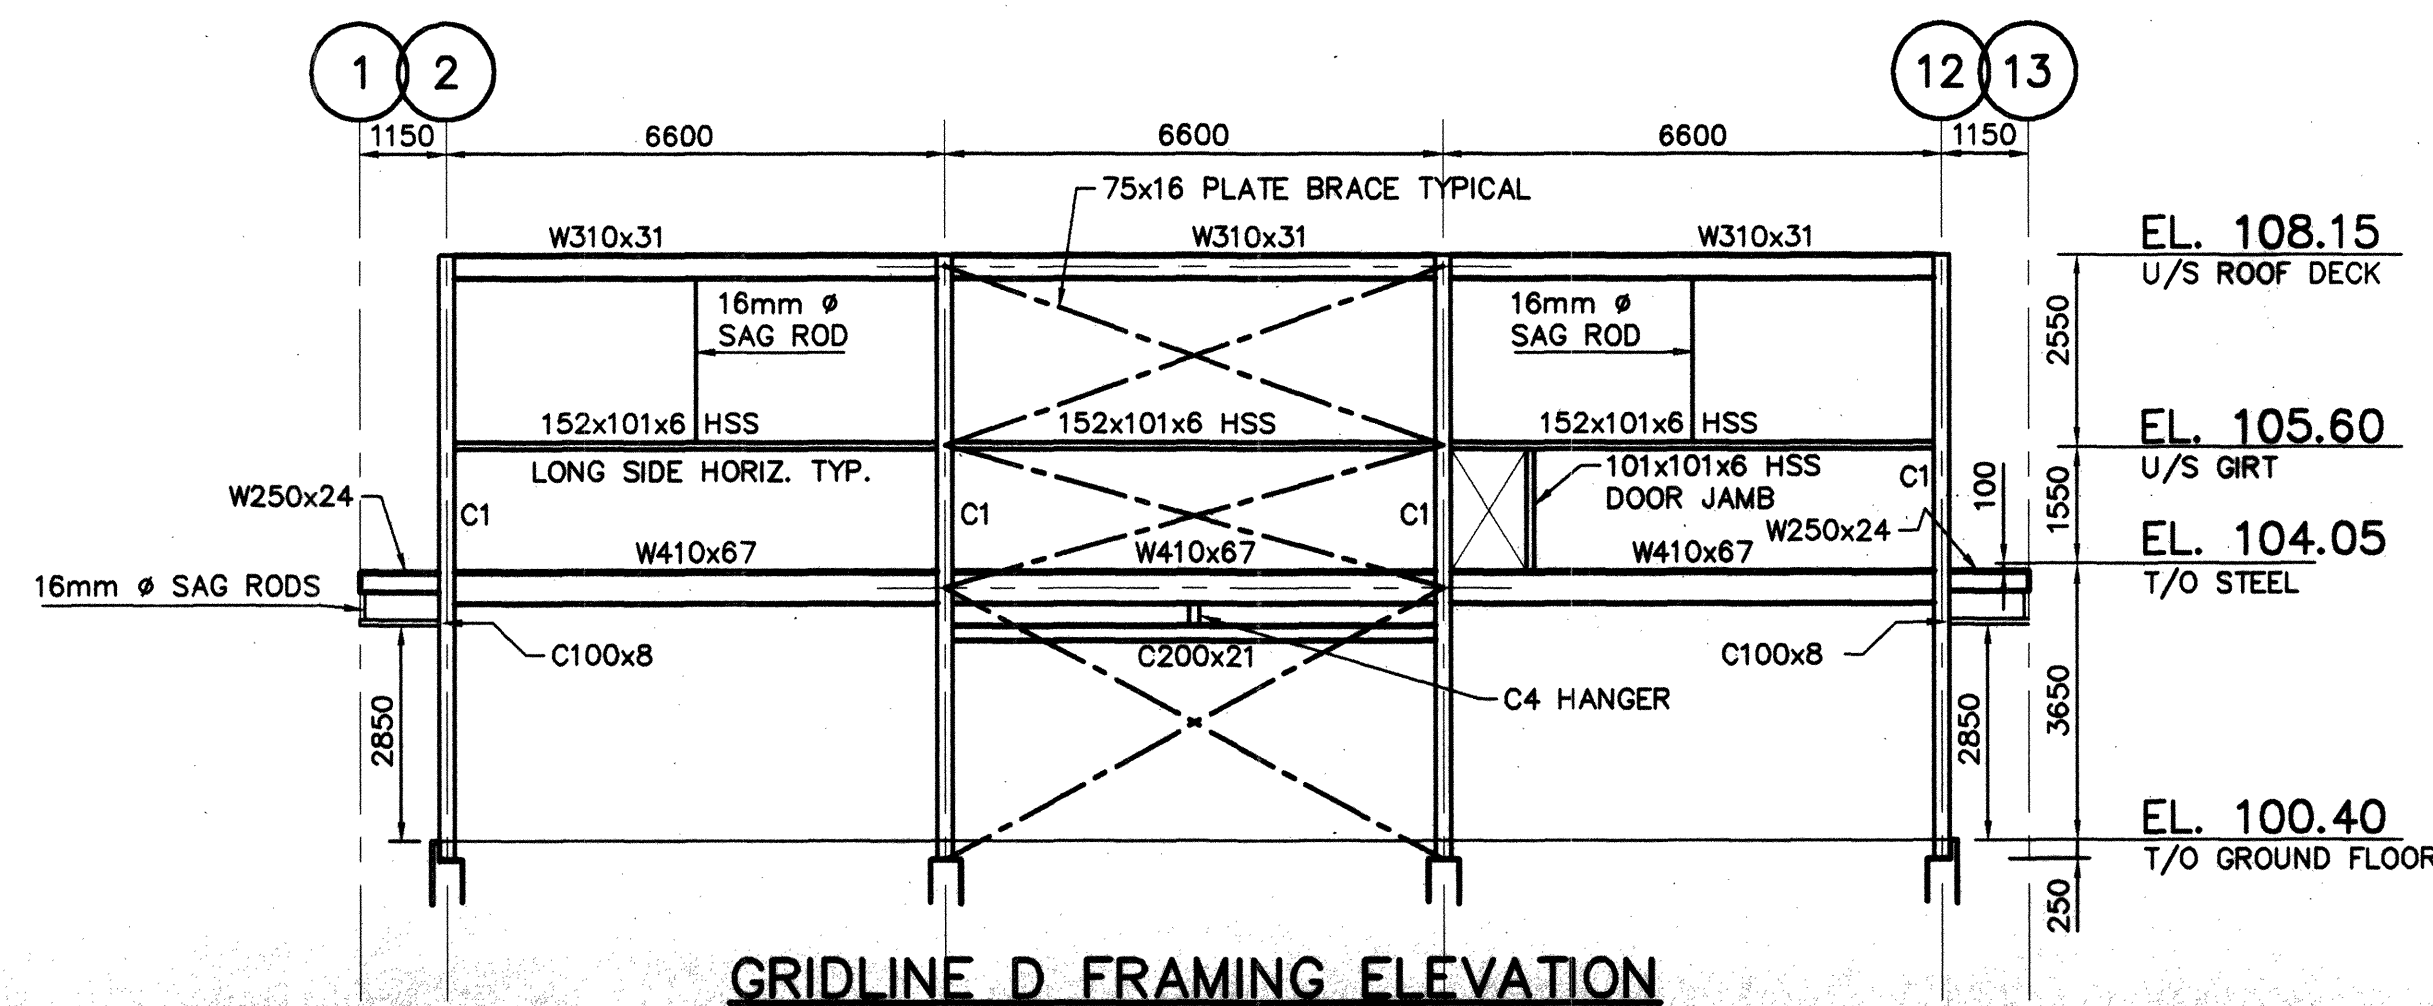

COLUMN SCHEDULE	
MARK	SIZE
C1	203x203x10 HSS
C2	152x152x8 HSS
C3	127x127x6 HSS
C4	76x76x6 HSS

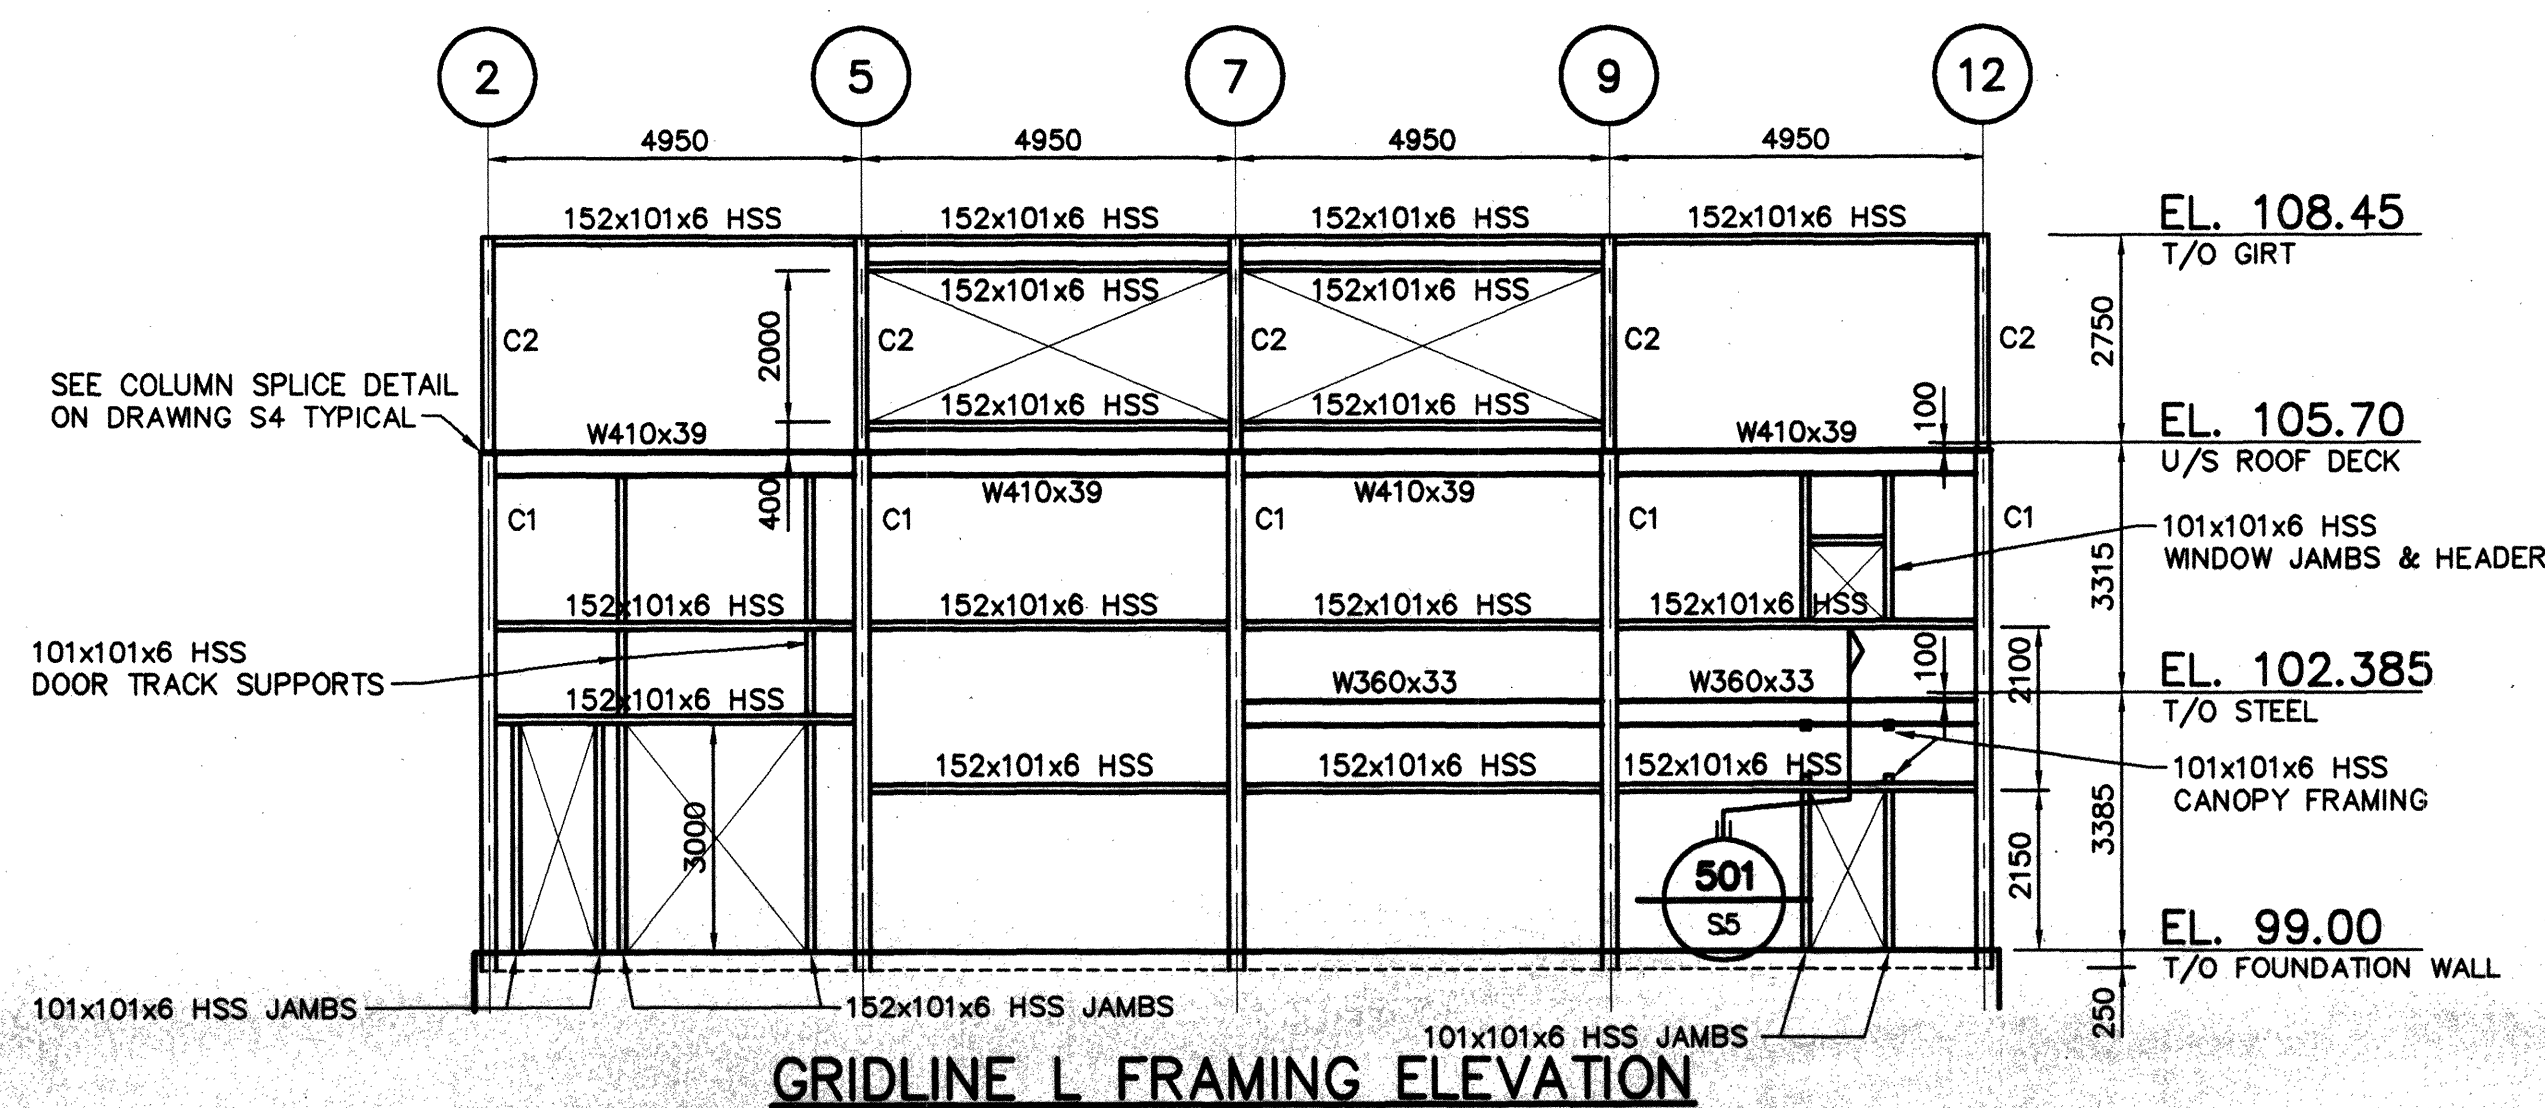

RECORD DRAWING
PRODUCED FROM INFORMATION PROVIDED BY CONTRACTOR
date: MARCH 1, 1996 TMC
J.L. RICHARDS & ASSOCIATES LIMITED

J.L. Richards & Associates Limited
Consulting Engineers, Architects & Planners
864 LADY ELLEN PLACE, OTTAWA, CANADA K1Z 5M2
Let/Smith Architects - Design Consultants

PROJECT: **CITY OF KANATA
THE
RON MASLIN
PLAYHOUSE
Kanata, Ontario**

**STEEL FRAMING
ELEVATIONS**

DESIGN: JDK	REVISION NO.:
DRAWN: TM	DRAWING NO.:
CHECKED: JJK	S5 of 5
DATE: MAY 1995	JOB NO.: 14456
SCALE: 1 : 100	

