

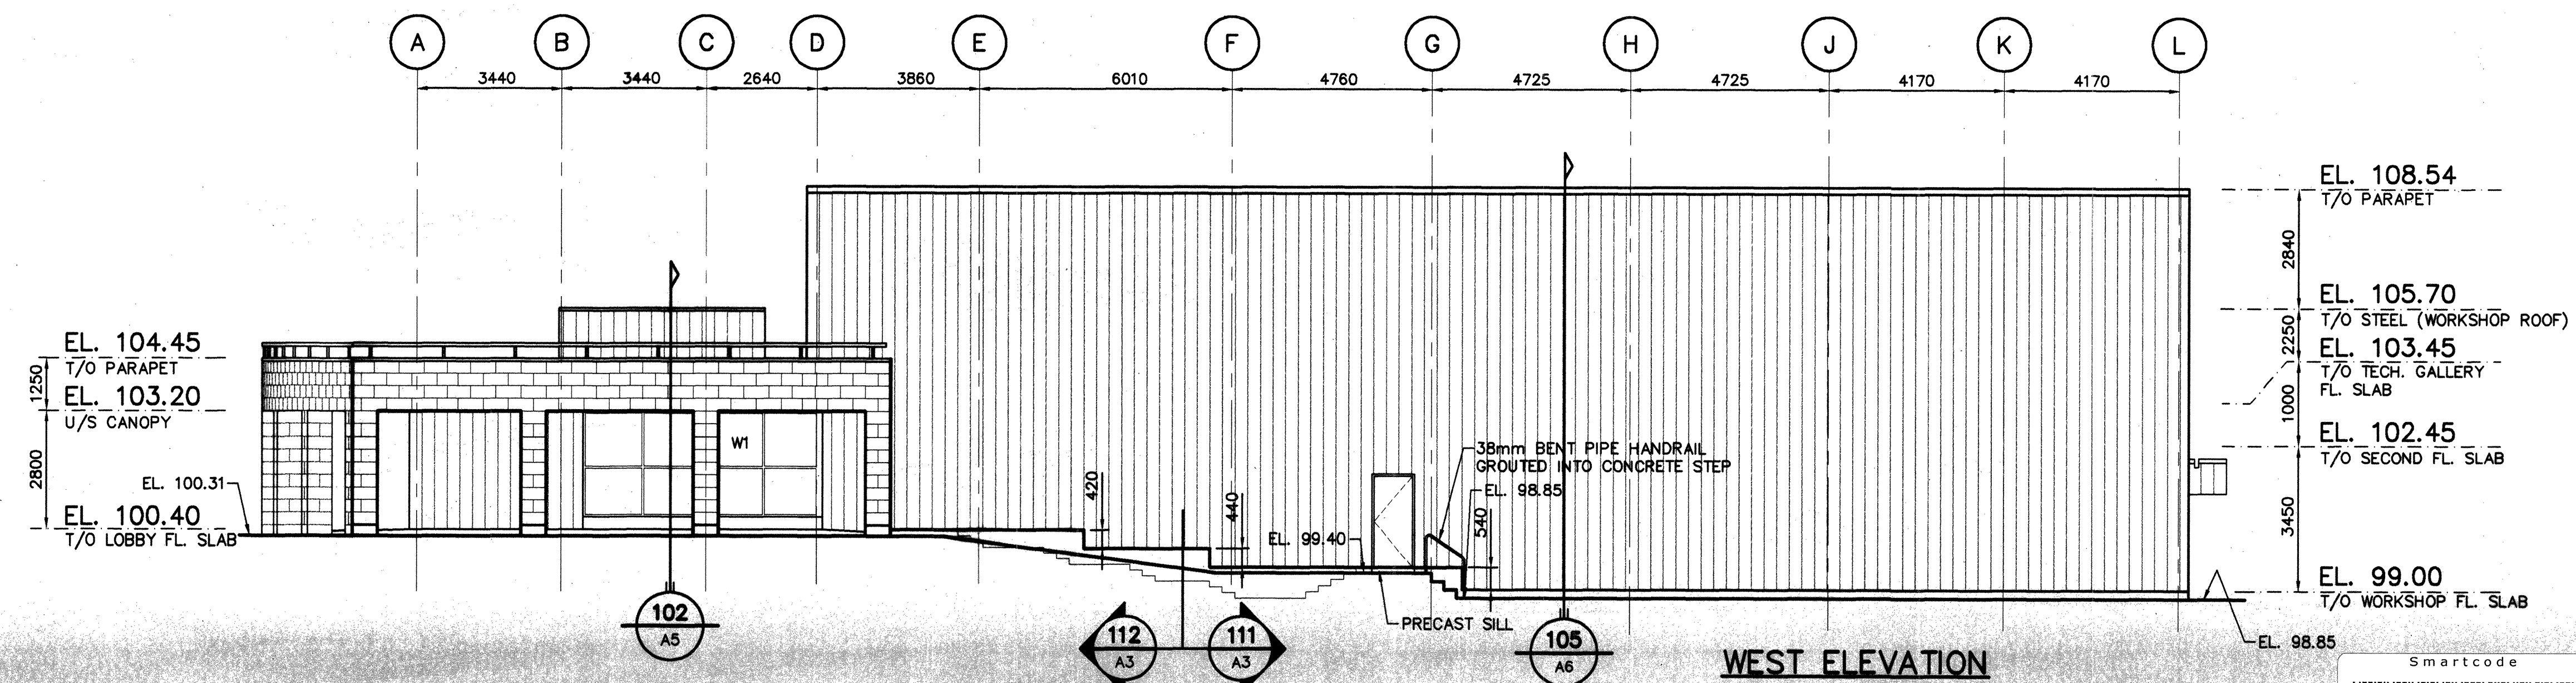
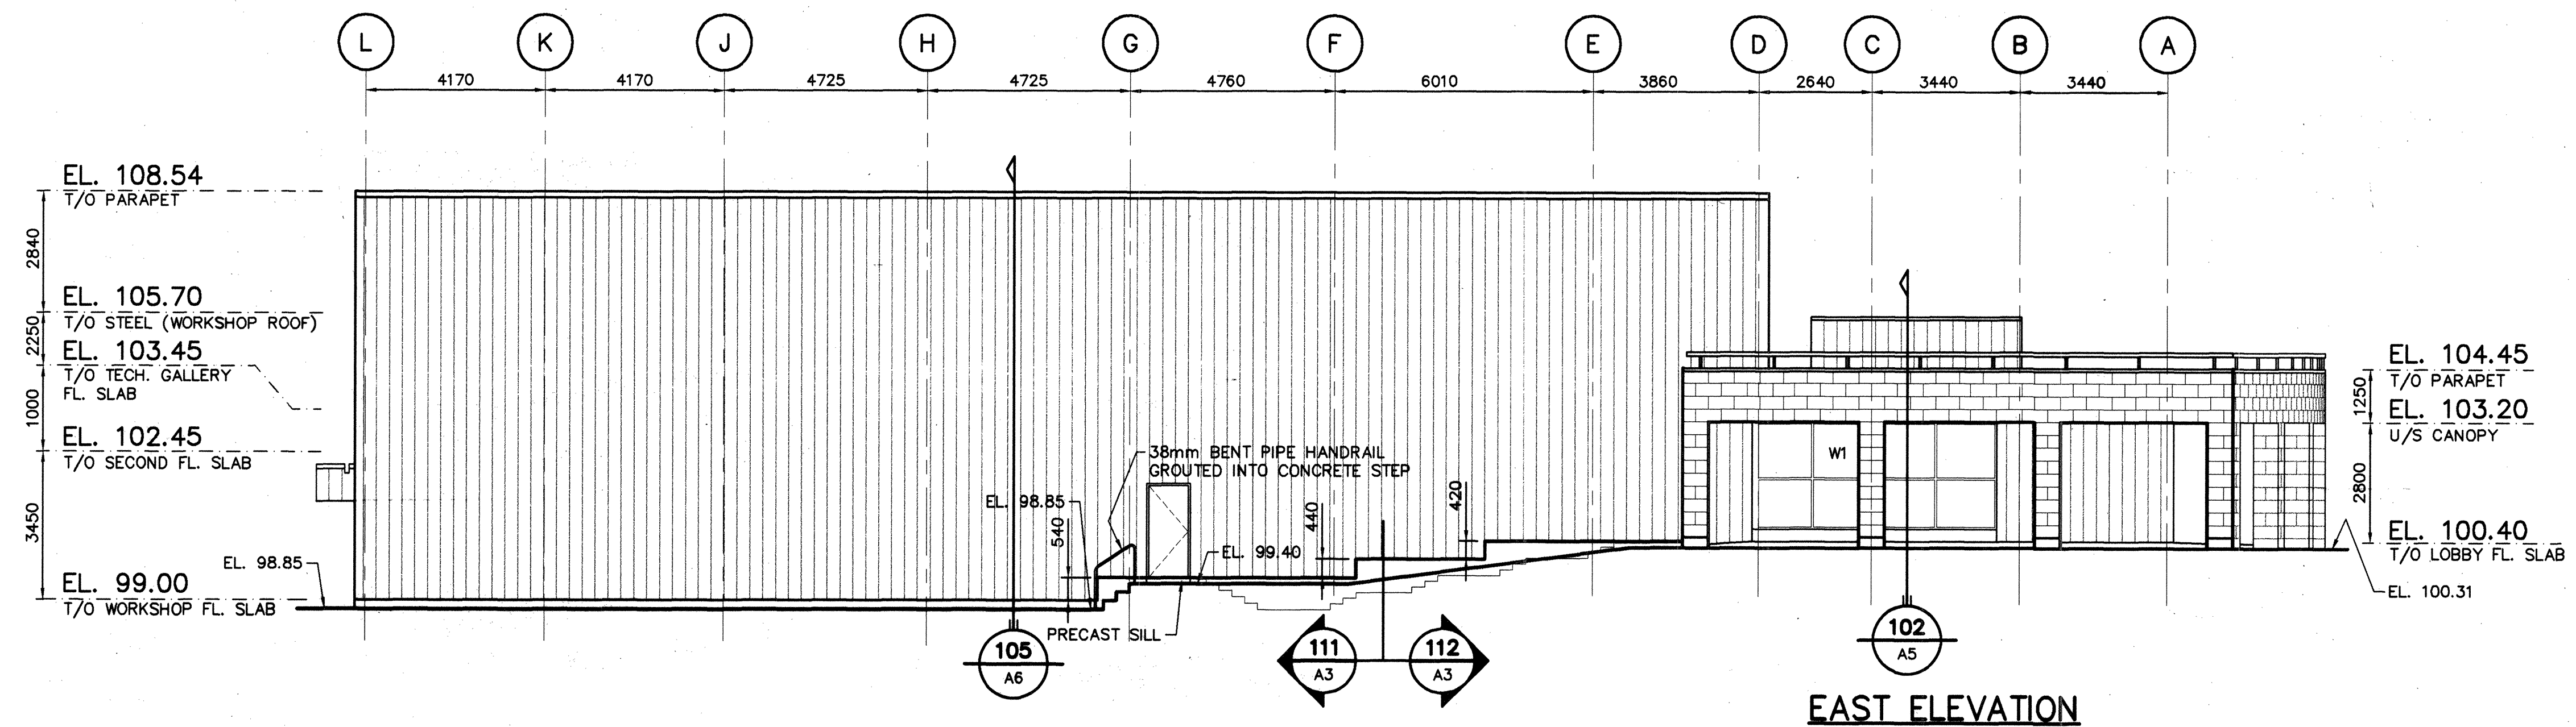
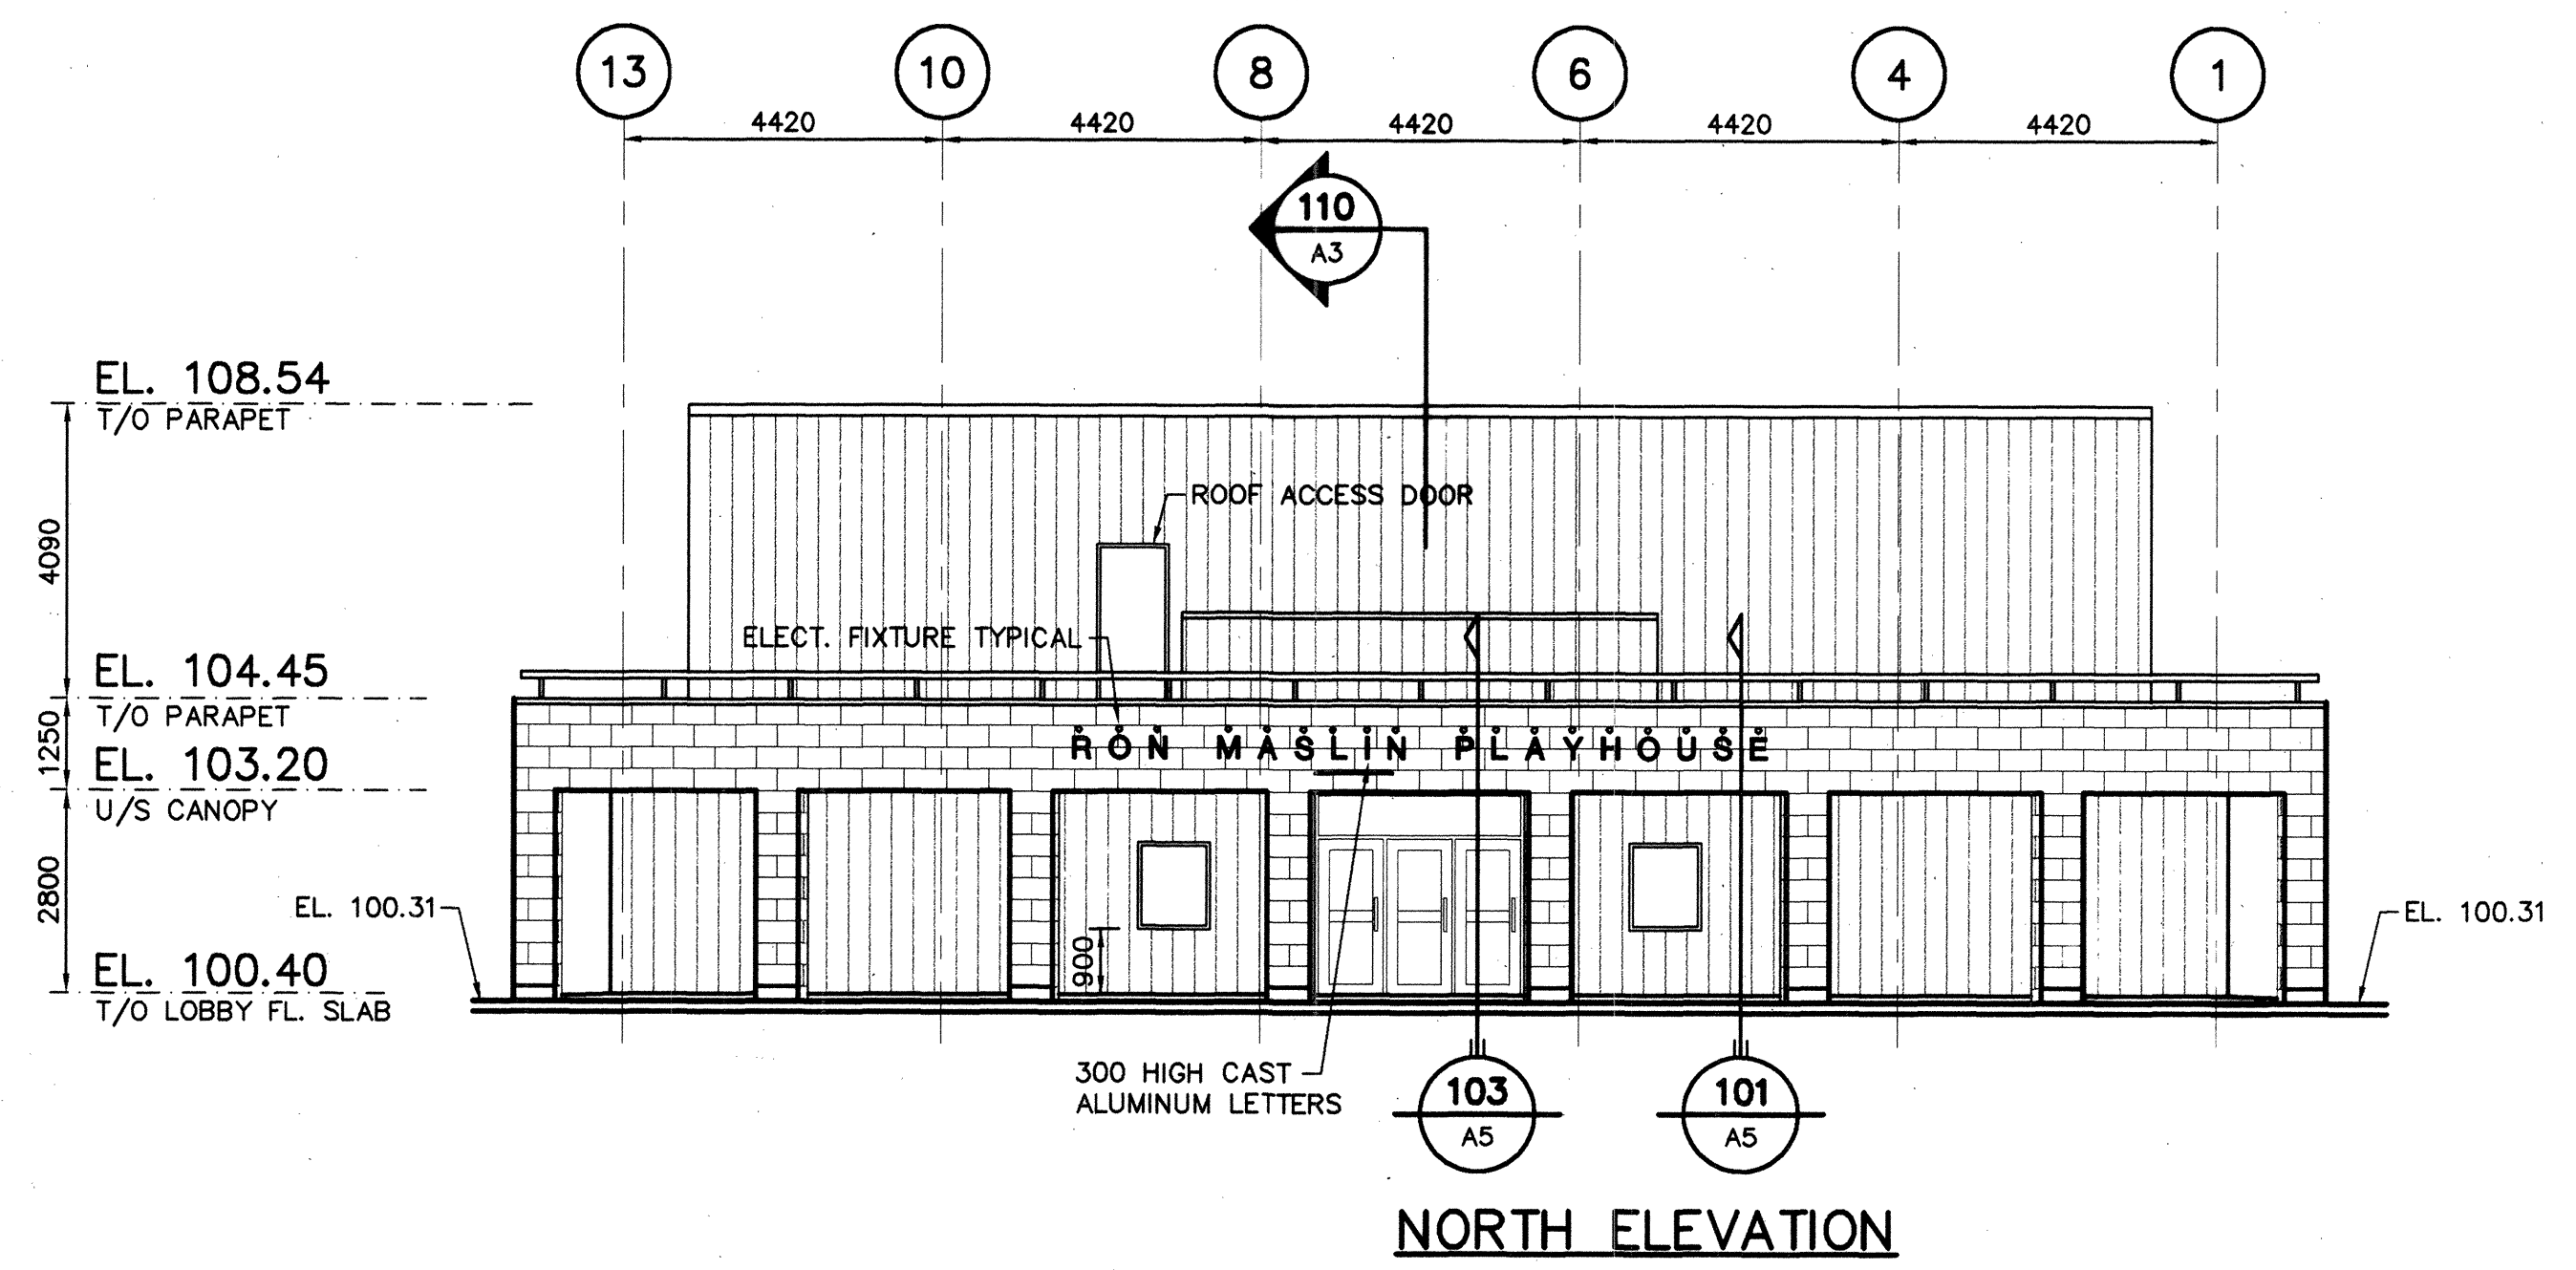


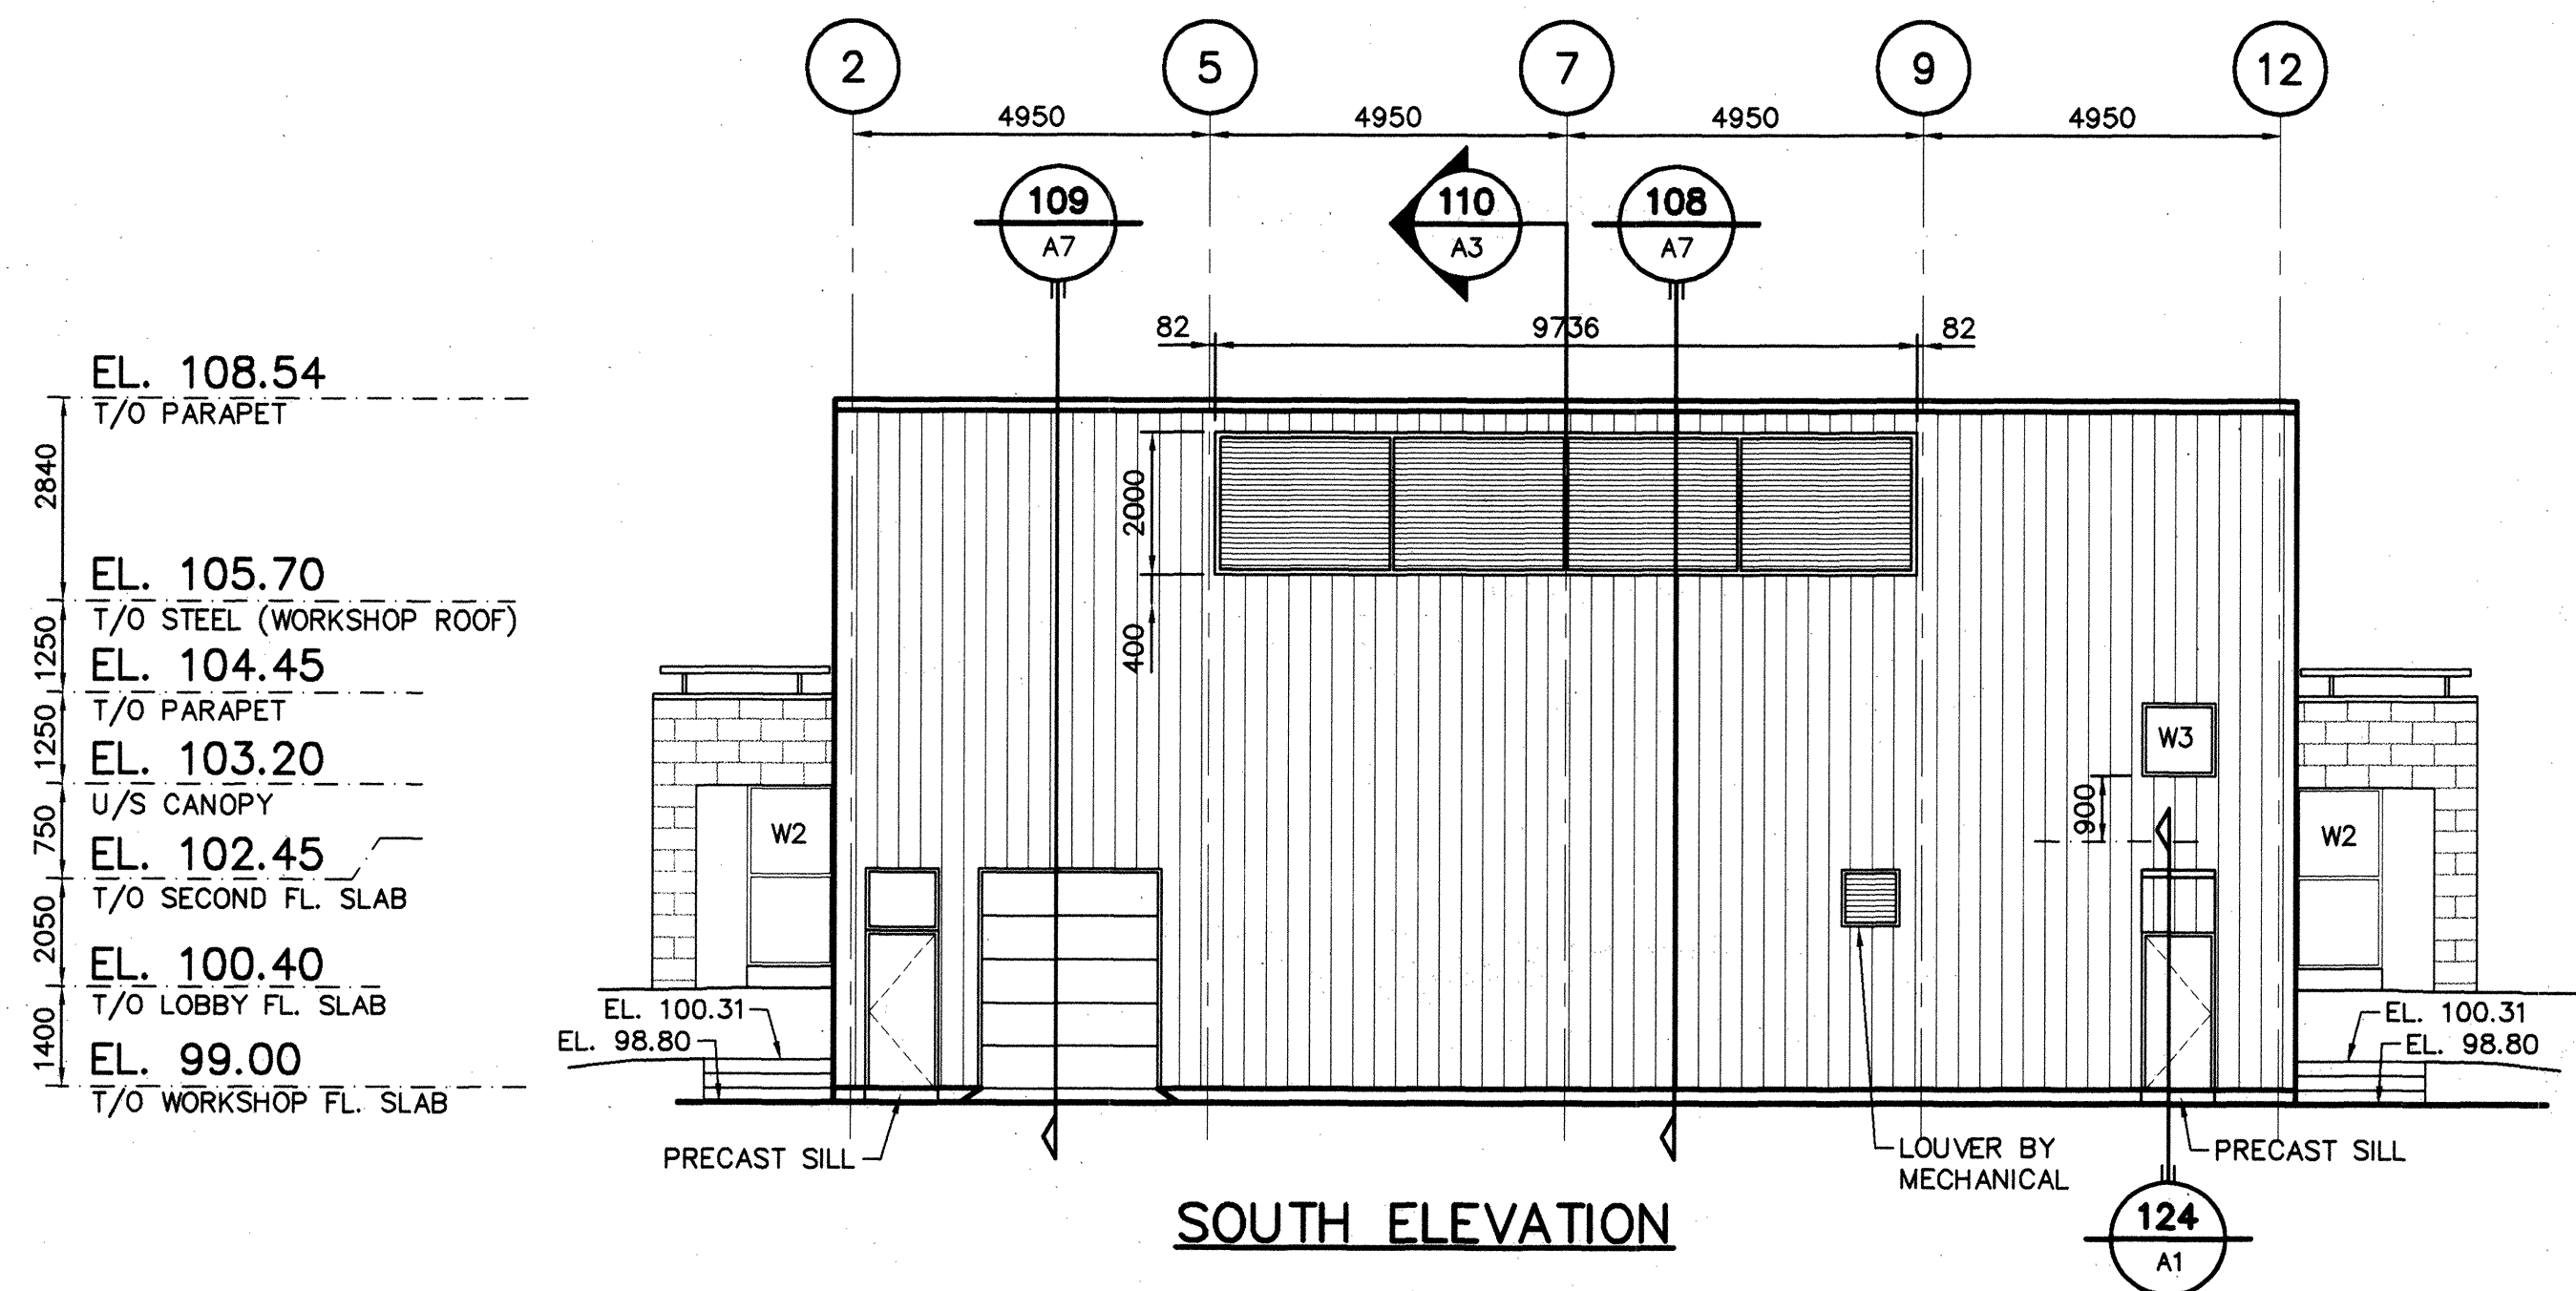

NO.	REVISION	DATE
1	ISSUED FOR TENDER	15/5/95
	ISSUE	DATE

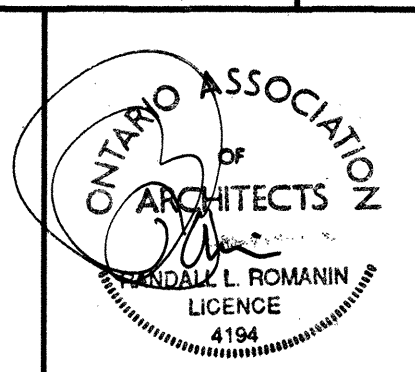

RECORD DRAWING
 PRODUCED FROM INFORMATION PROVIDED BY CONTRACTOR
 date: MARCH 1, 1996 Tmc
 J.L. RICHARDS & ASSOCIATES LIMITED

J.L. Richards & Associates Limited
 Consulting Engineers, Architects & Planners
 884 LADY ELLEN PLACE, OTTAWA, CANADA K1Z 5M2
Lett/Smith Architects - Design Consultants

PROJECT: **CITY OF KANATA
 THE
 RON MASLIN
 PLAYHOUSE
 Kanata, Ontario**

DRAWING: **ELEVATIONS**

DESIGN: STH	REVISION NO.:
DRAWN: TM	DRAWING NO.:
CHECKED: STH	A2 of 13.
DATE: MAY 1995	JOB NO.: 14456
SCALE: 1 : 100	

