

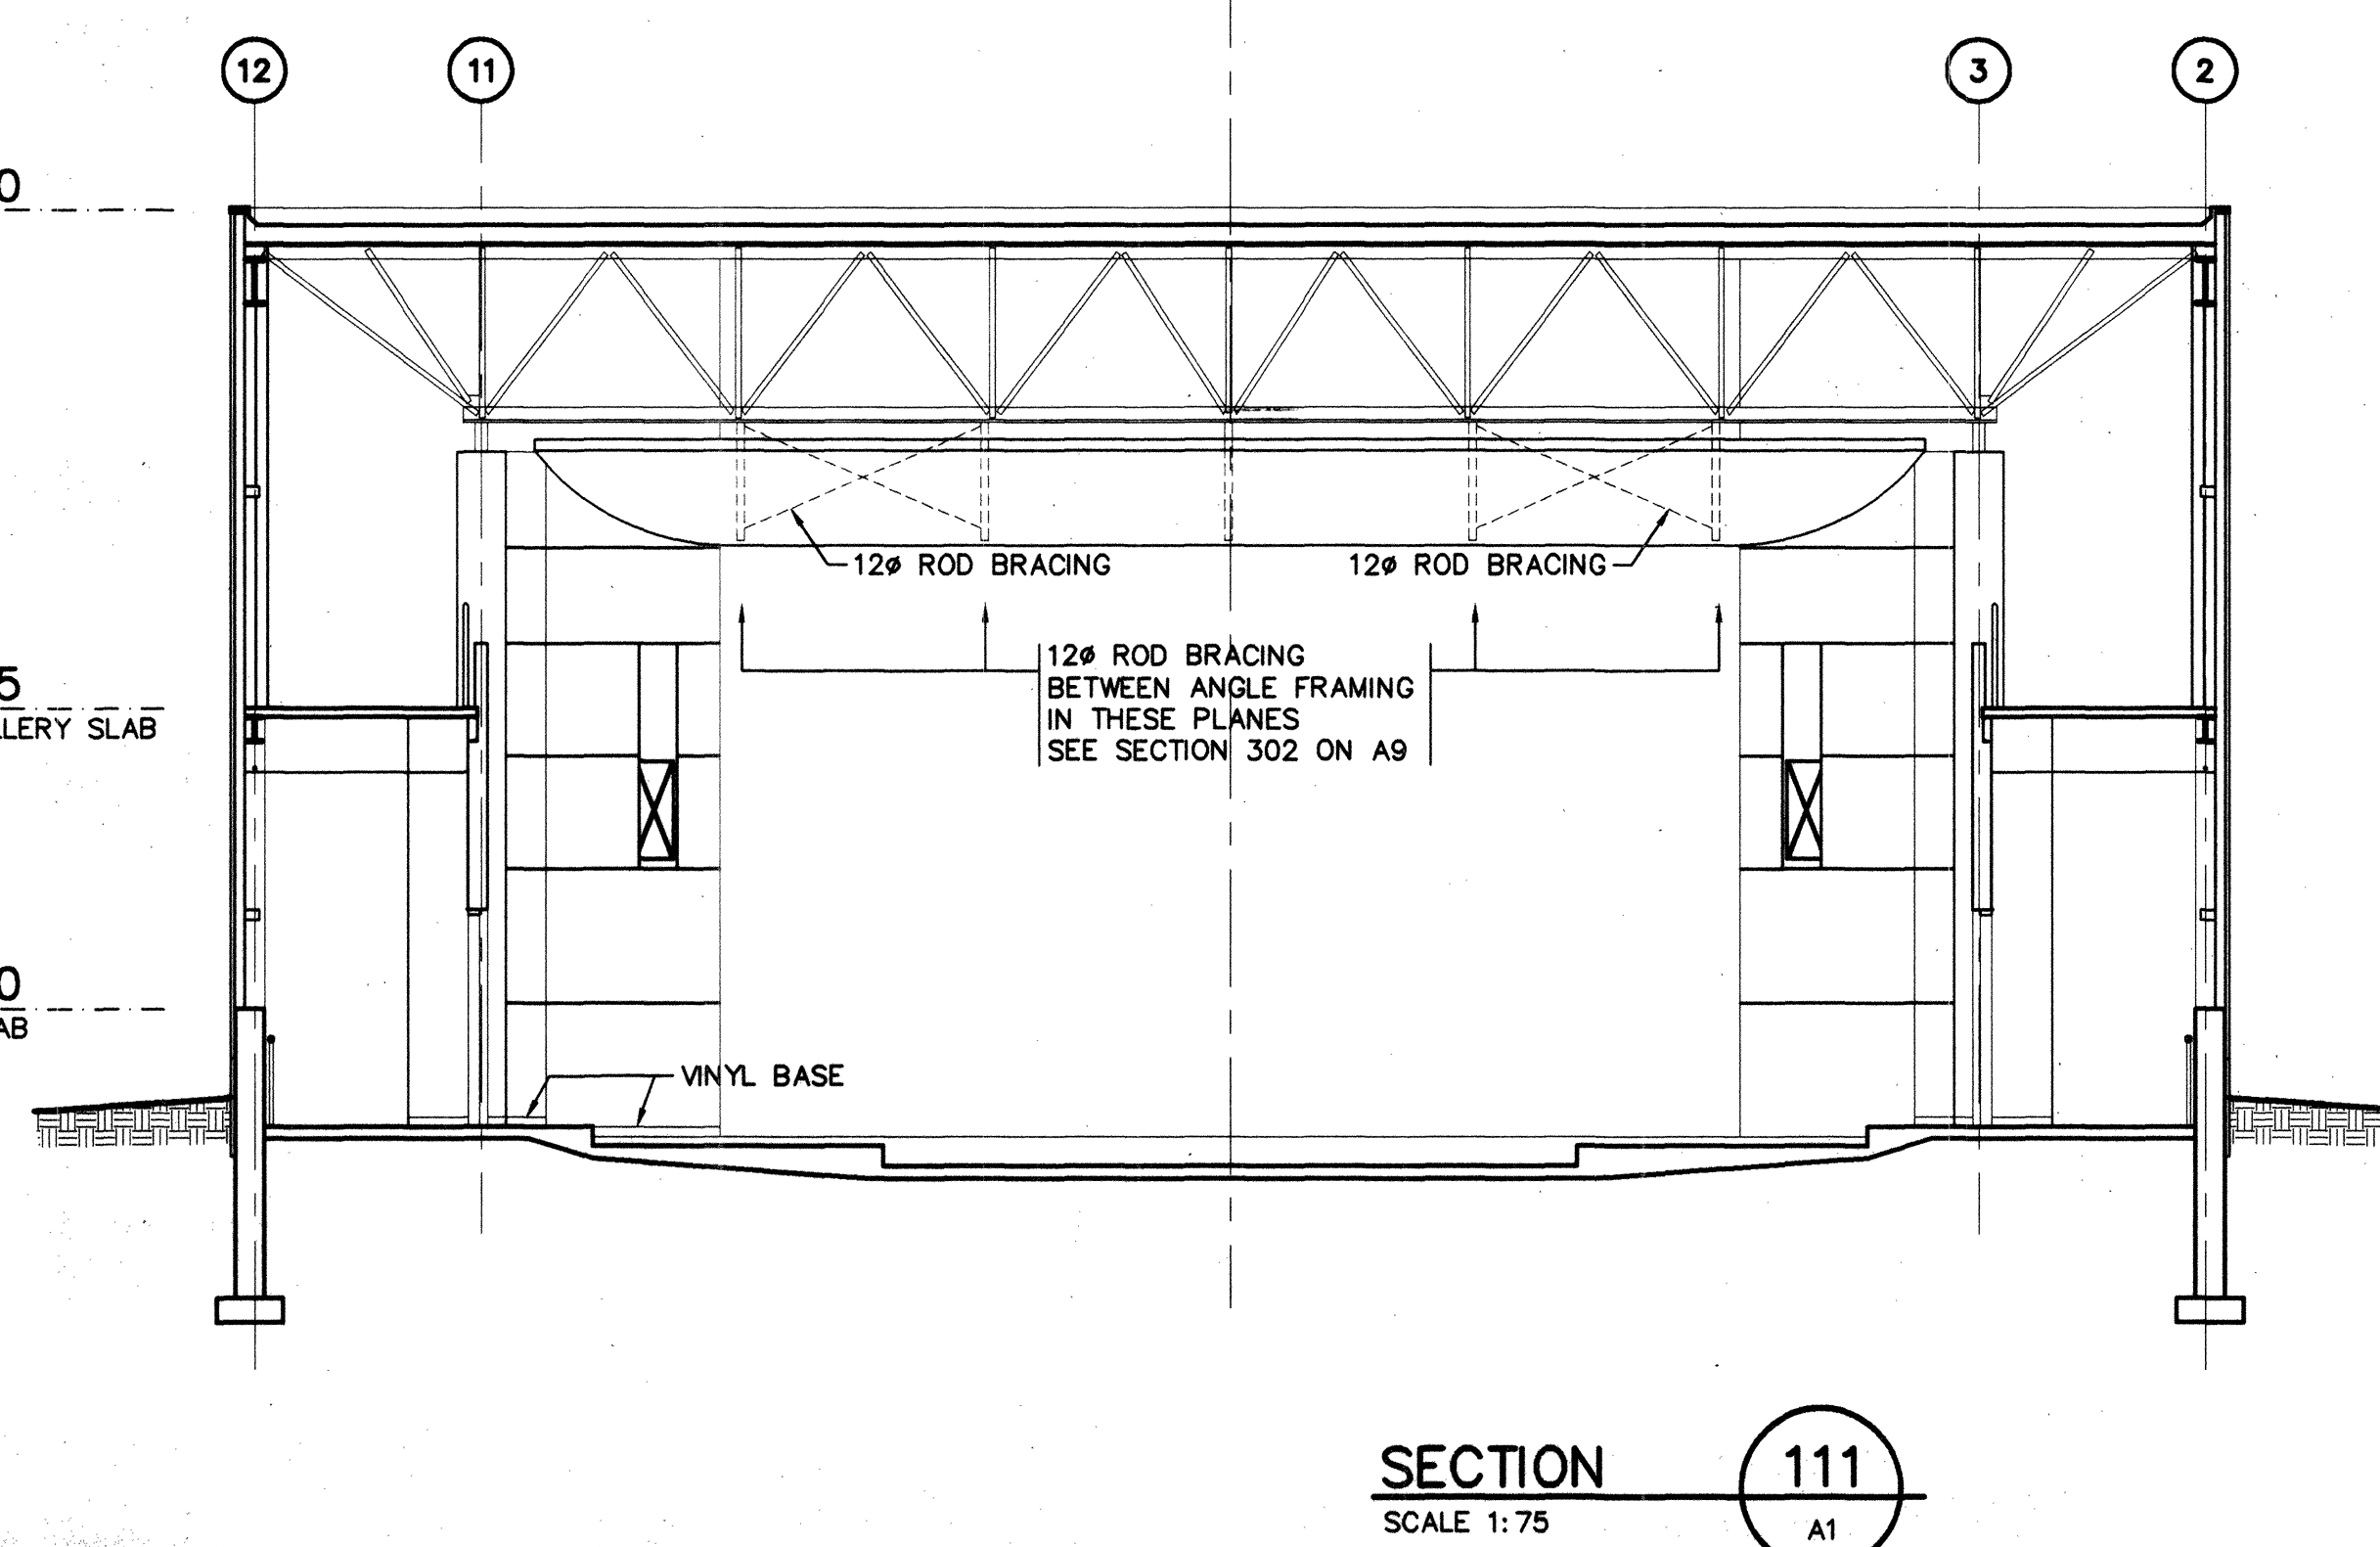
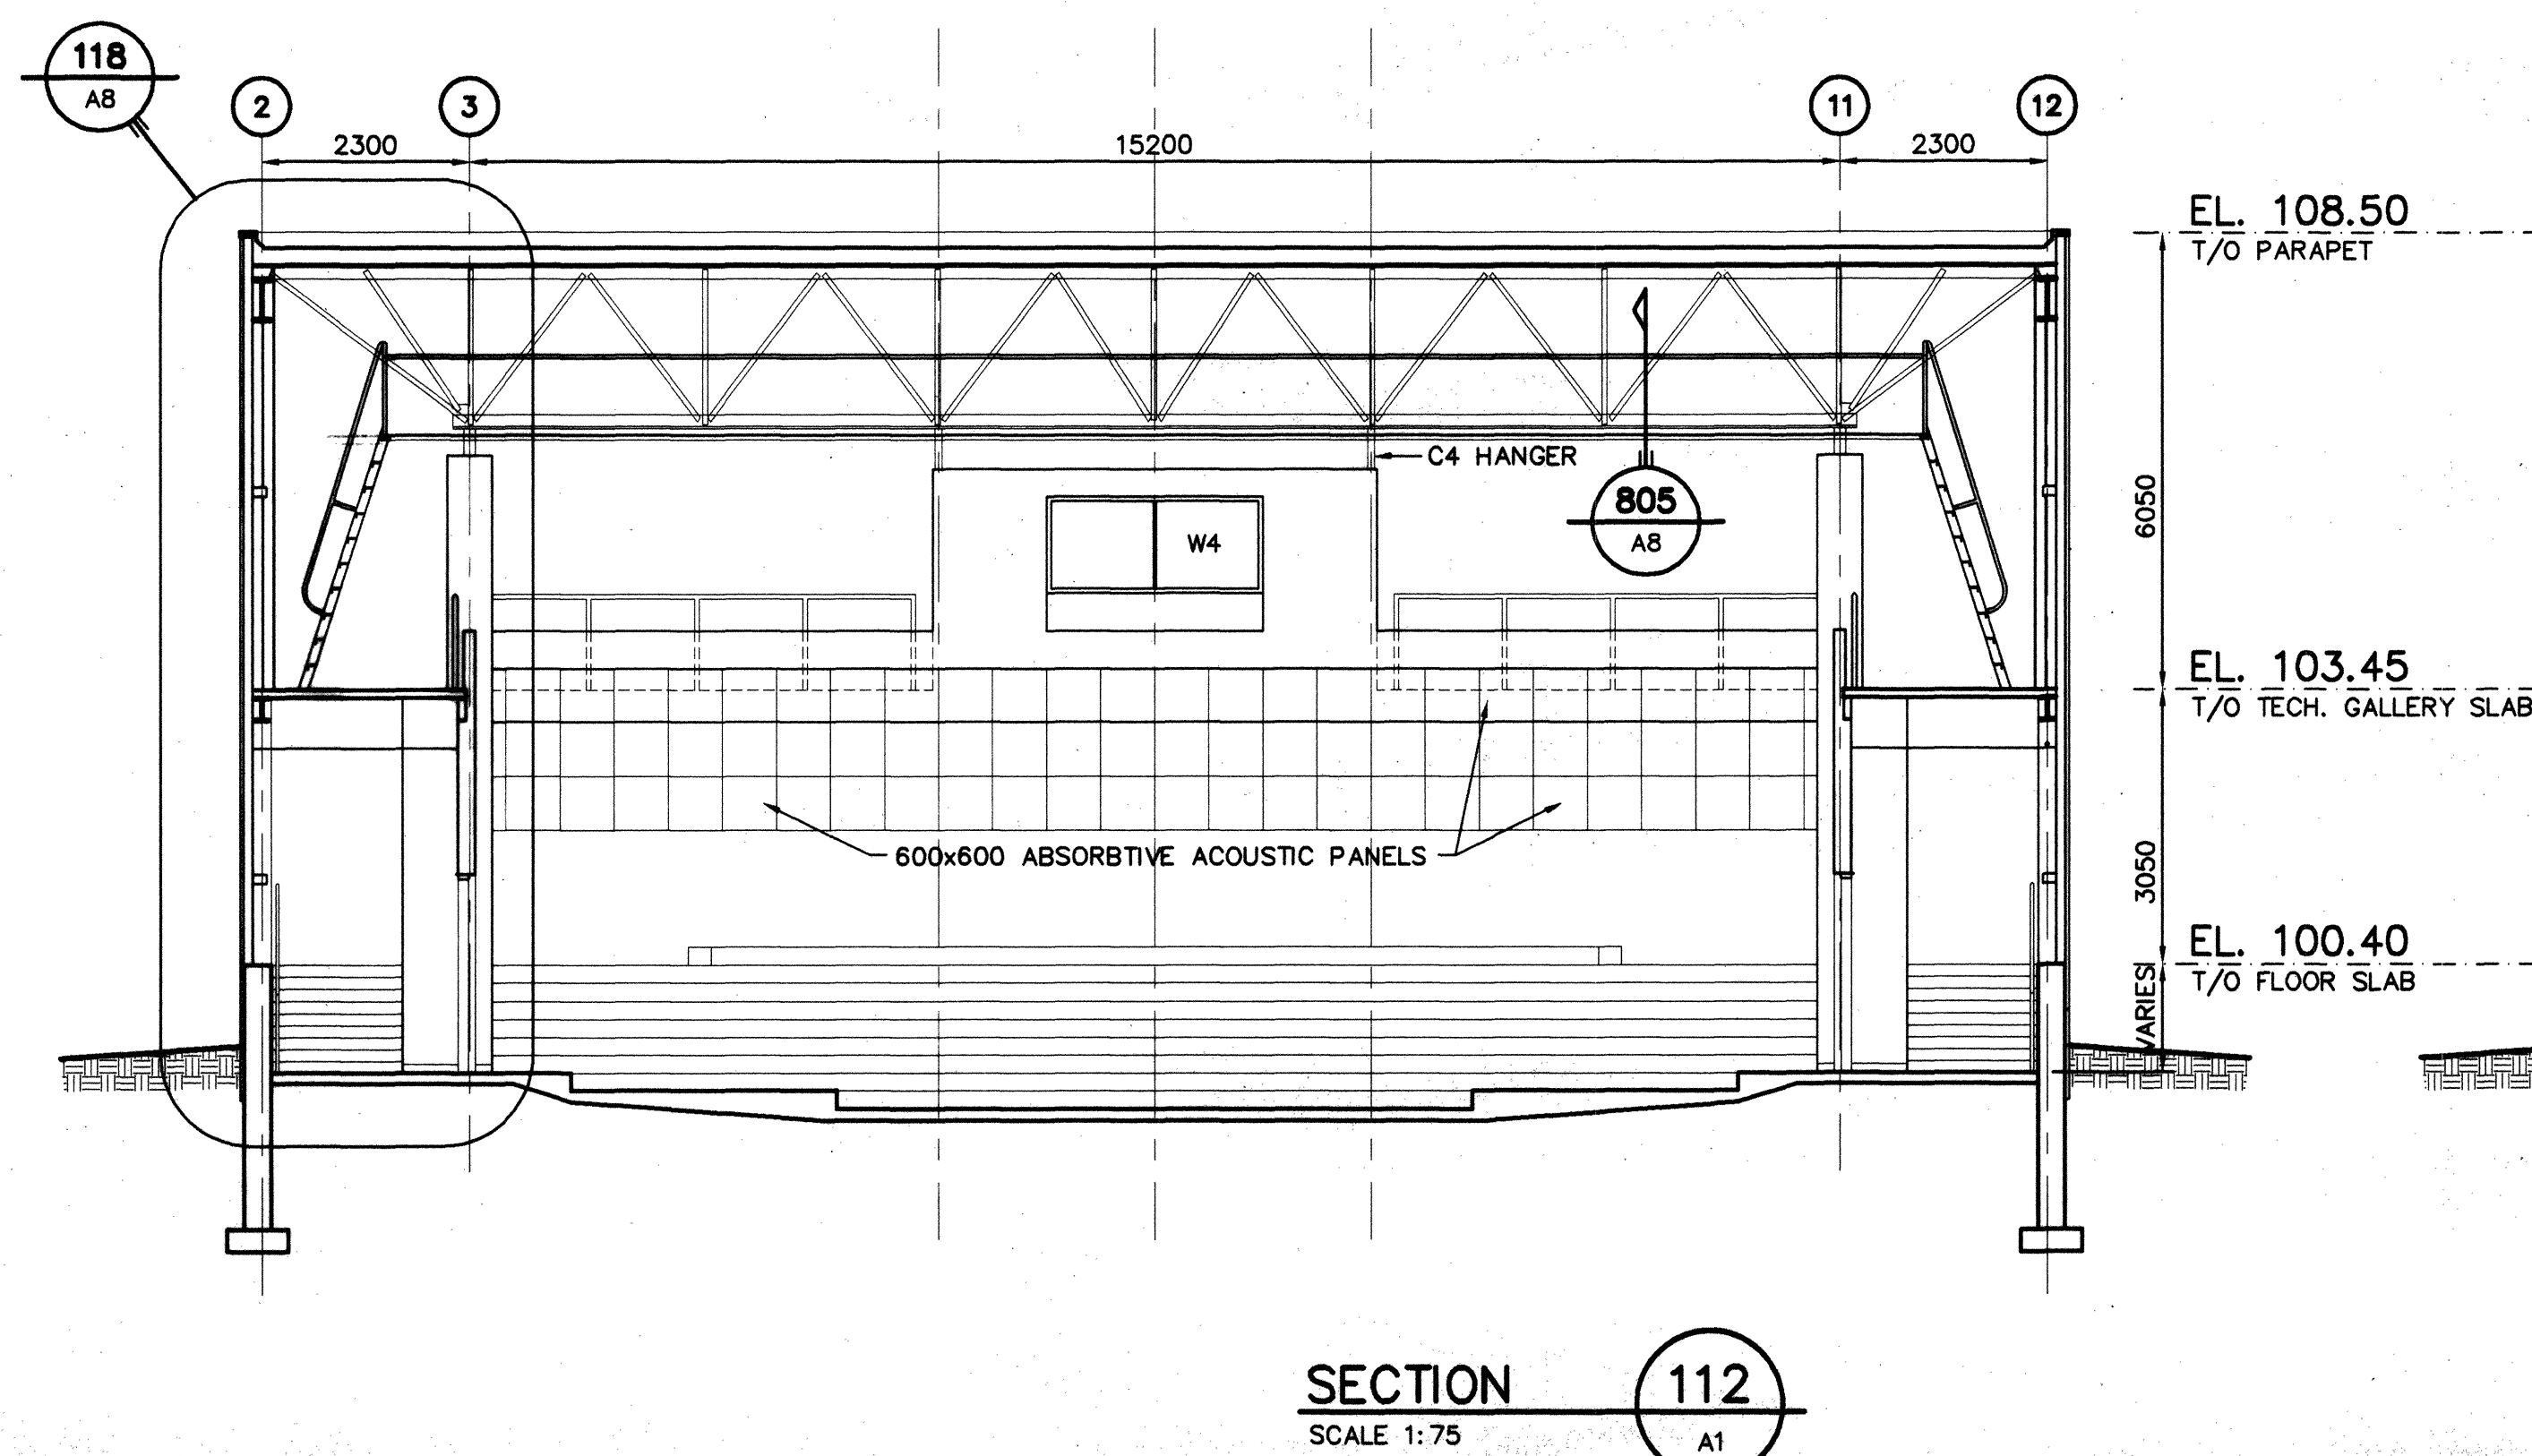


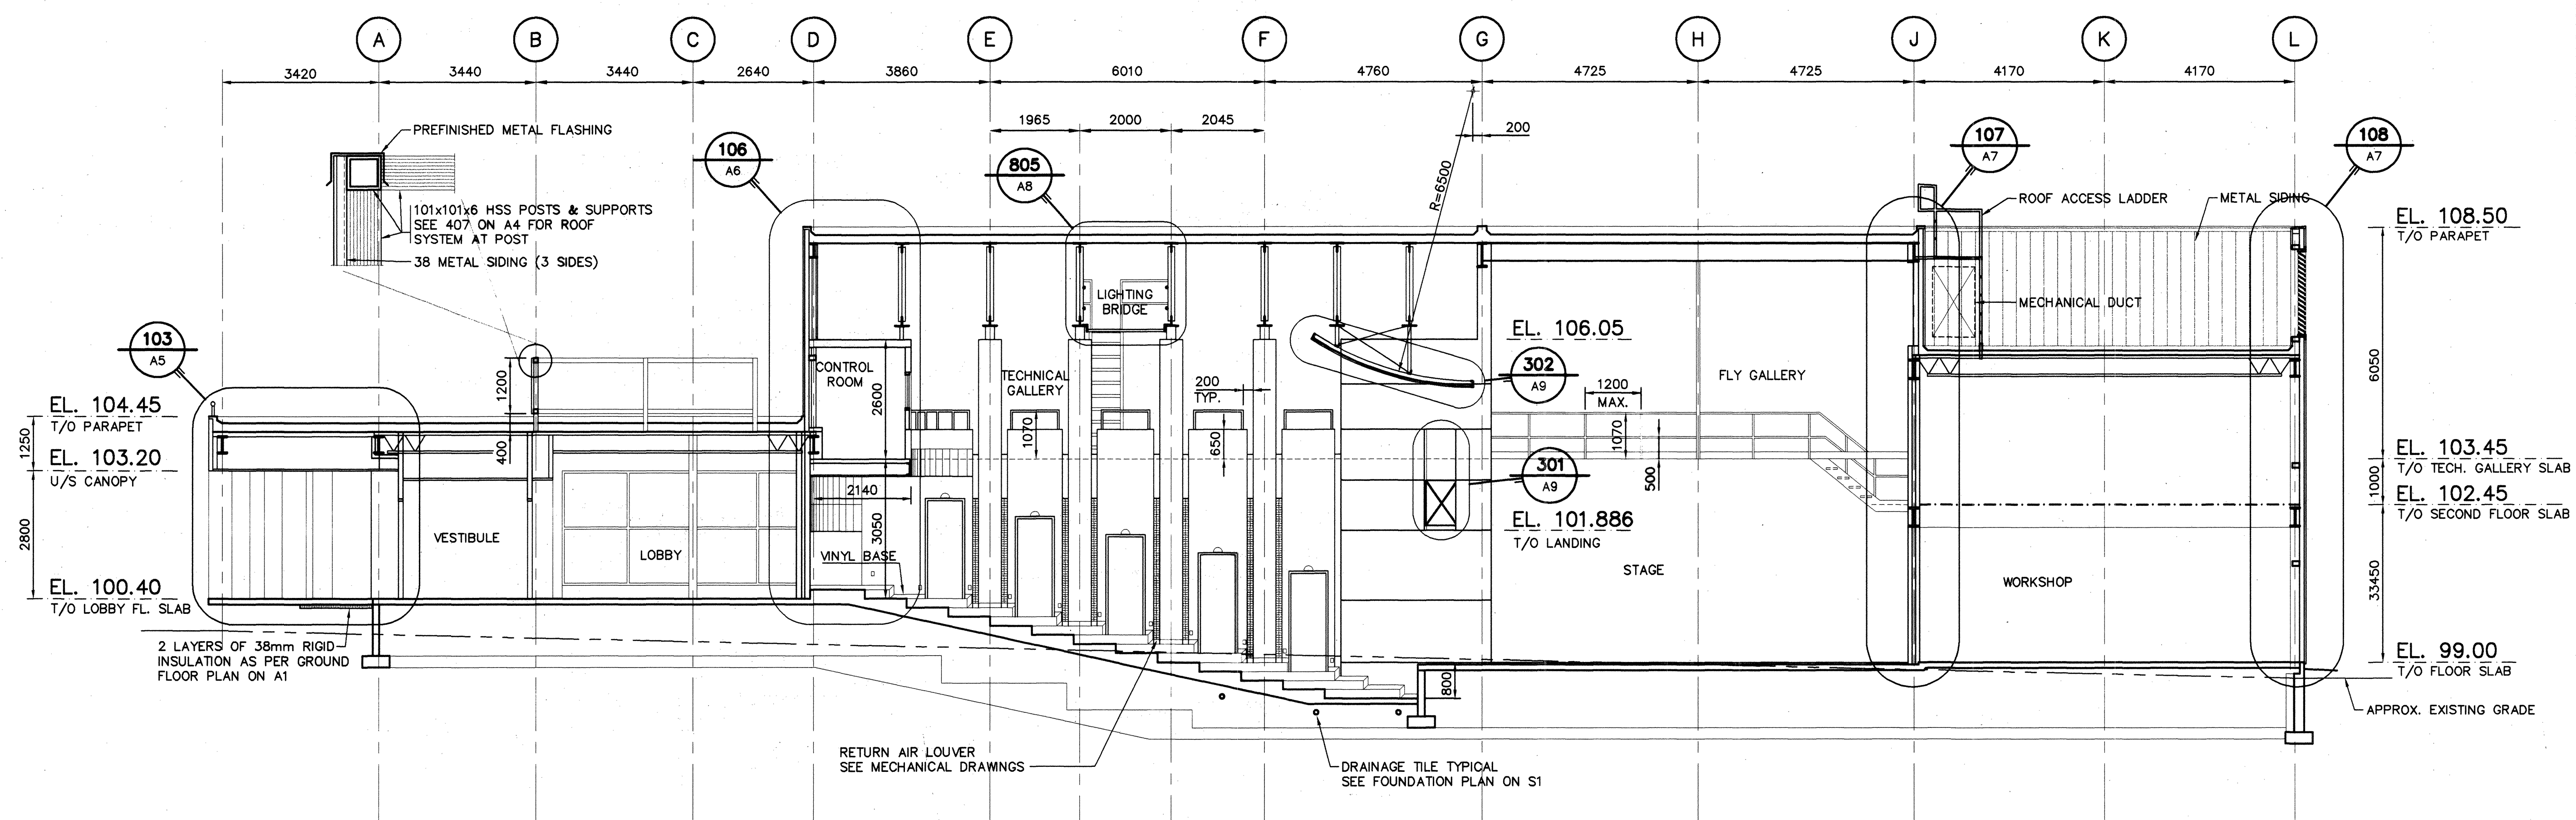

NO.	REVISION	DATE
1	ISSUED FOR TENDER	15/5/2017
NO.	ISSUE	DATE

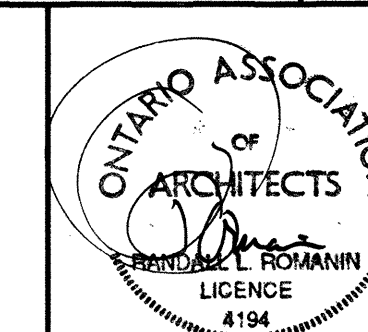


RECORD DRAWING

PRODUCED FROM INFORMATION PROVIDED BY CONTRACTOR

date: MARCH 1, 1996 TMc

J.L. RICHARDS & ASSOCIATES LIMITED

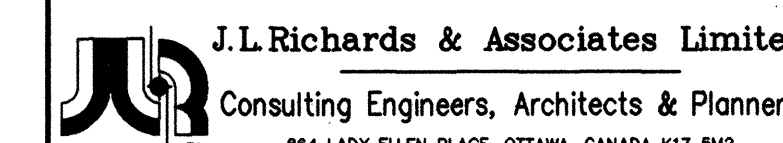

Lett/Smith Architects • Design Consultants

PROJECT: CITY OF KANATA
THE
RON MASLIN
PLAYHOUSE
Kanata, Ontario

DRAWING:

BUILDING SECTIONS

DESIGN: STH	REVISION NO.:
DRAWN: TM	DRAWING NO.:
CHECKED: STH	A3 of 13
DATE: MAY 1995	
SCALE: 1:75	JOB NO.: 14456

