

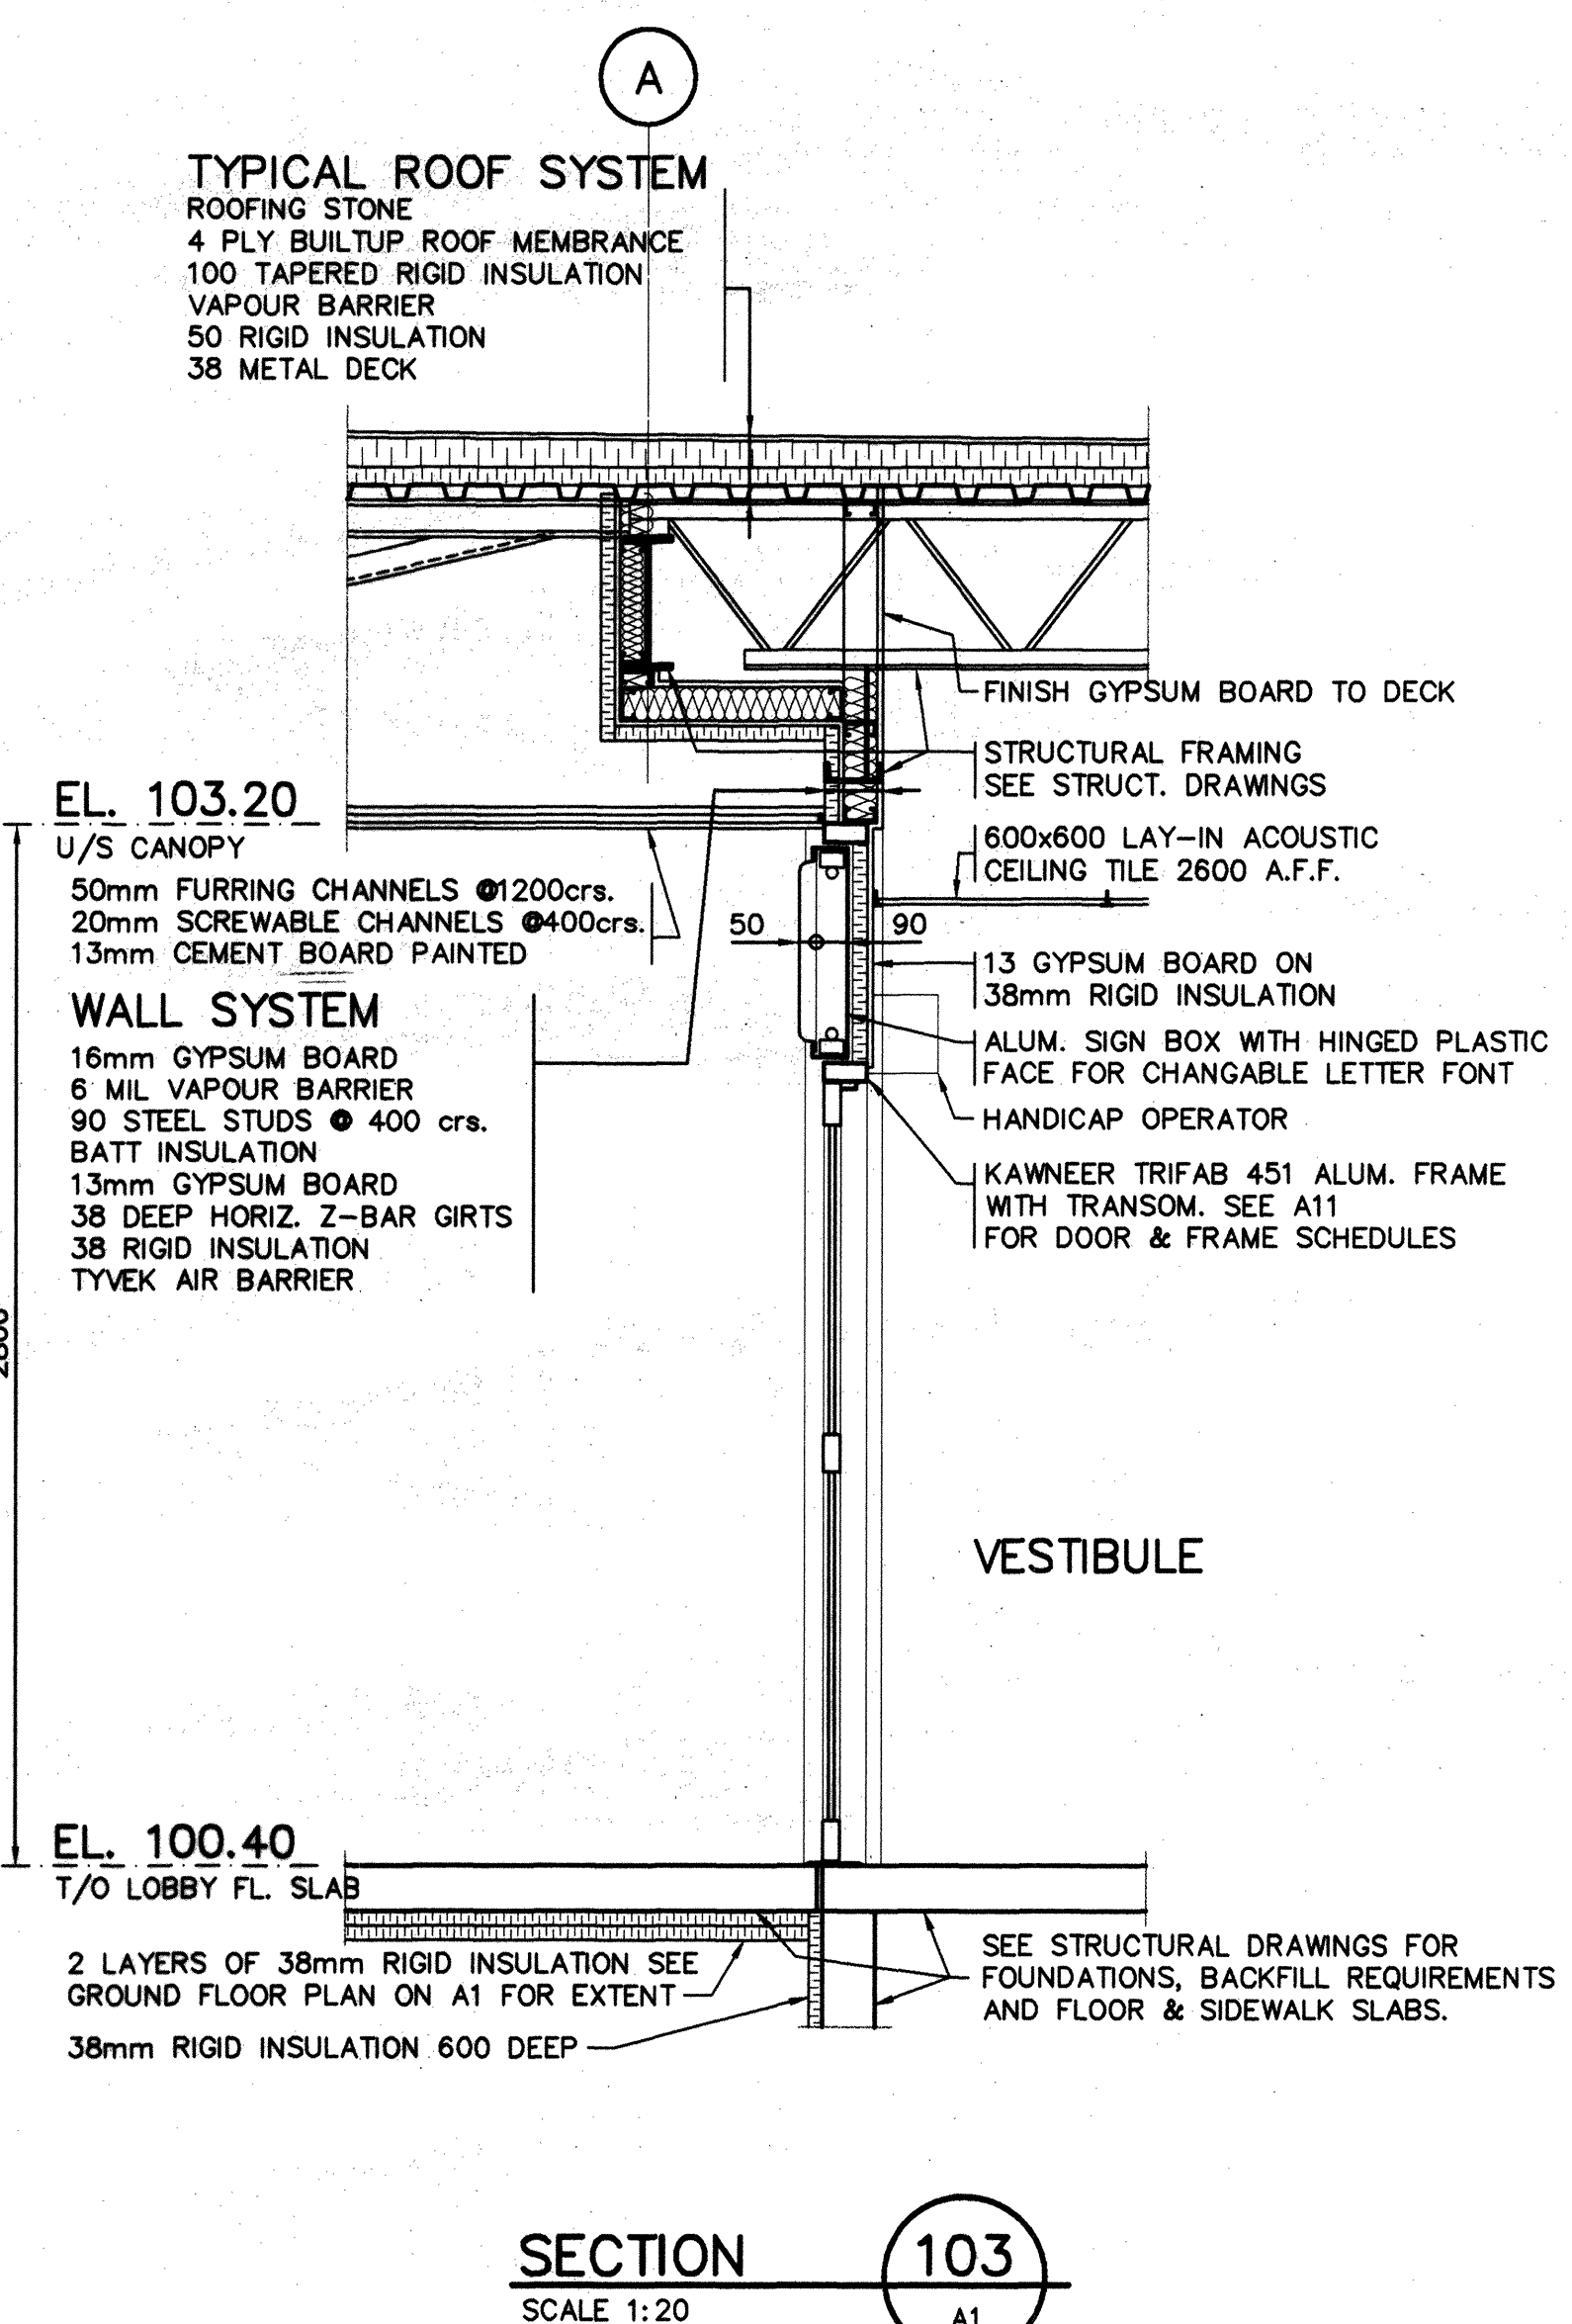
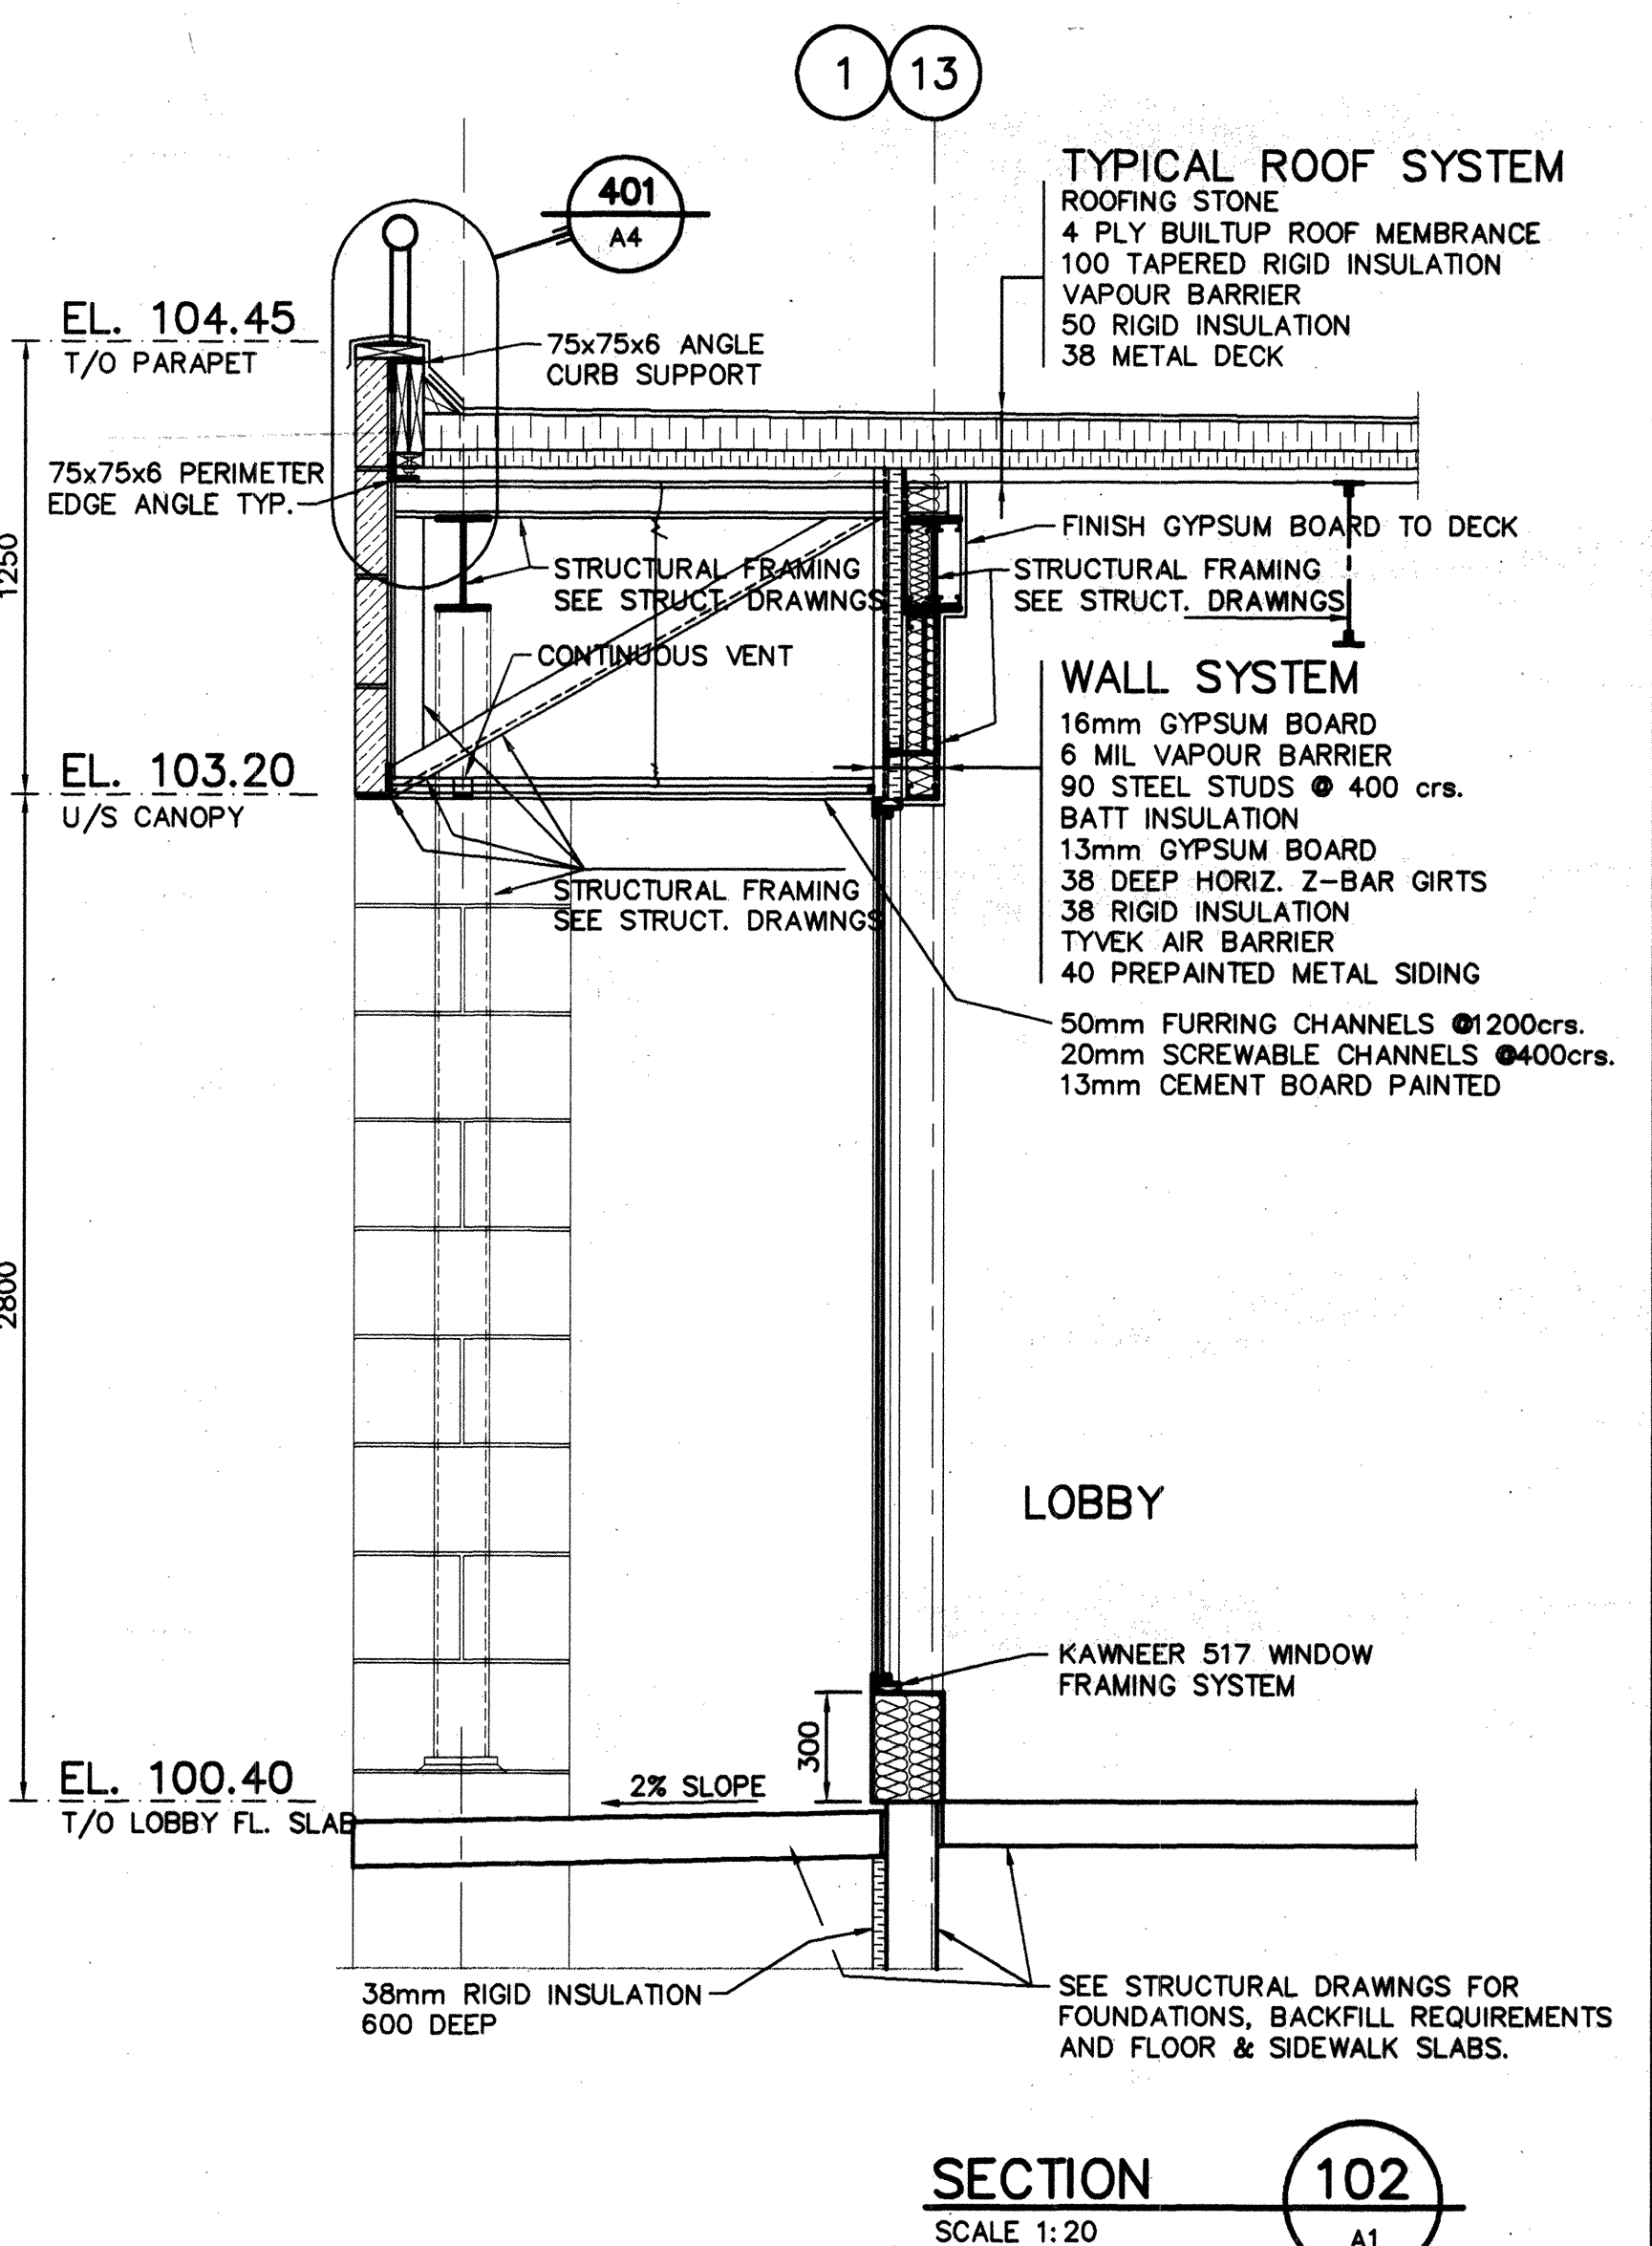
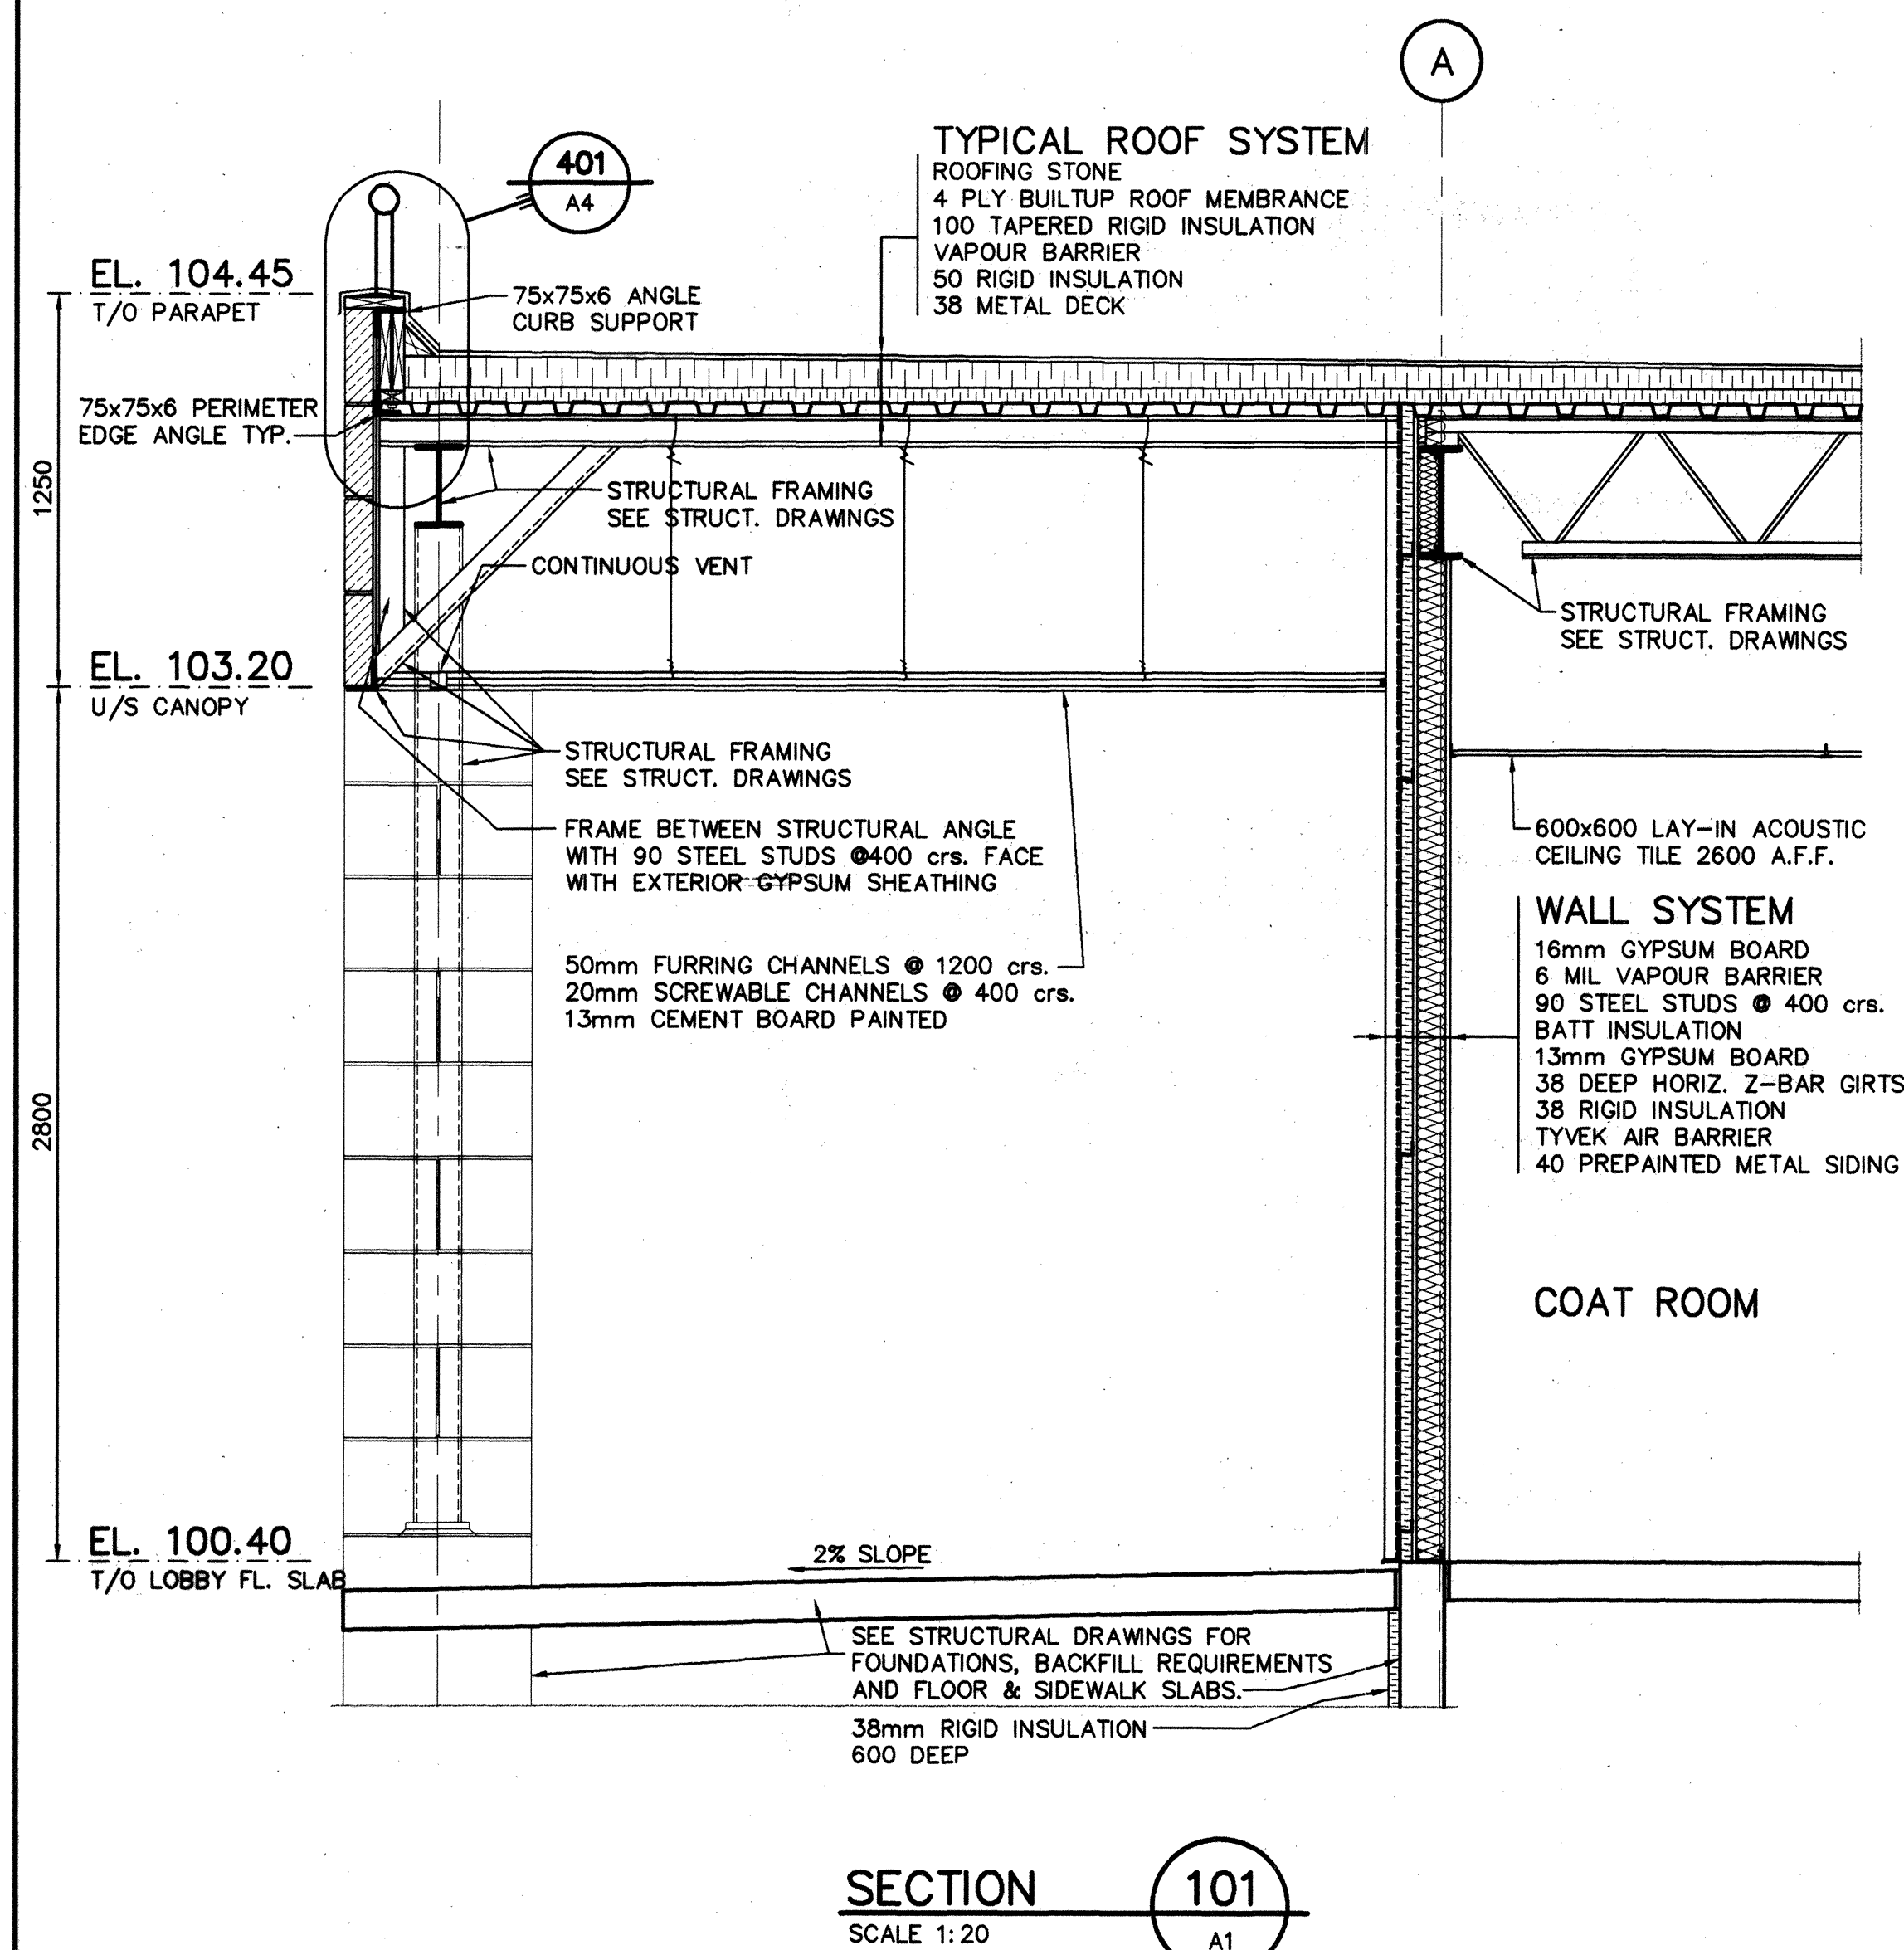


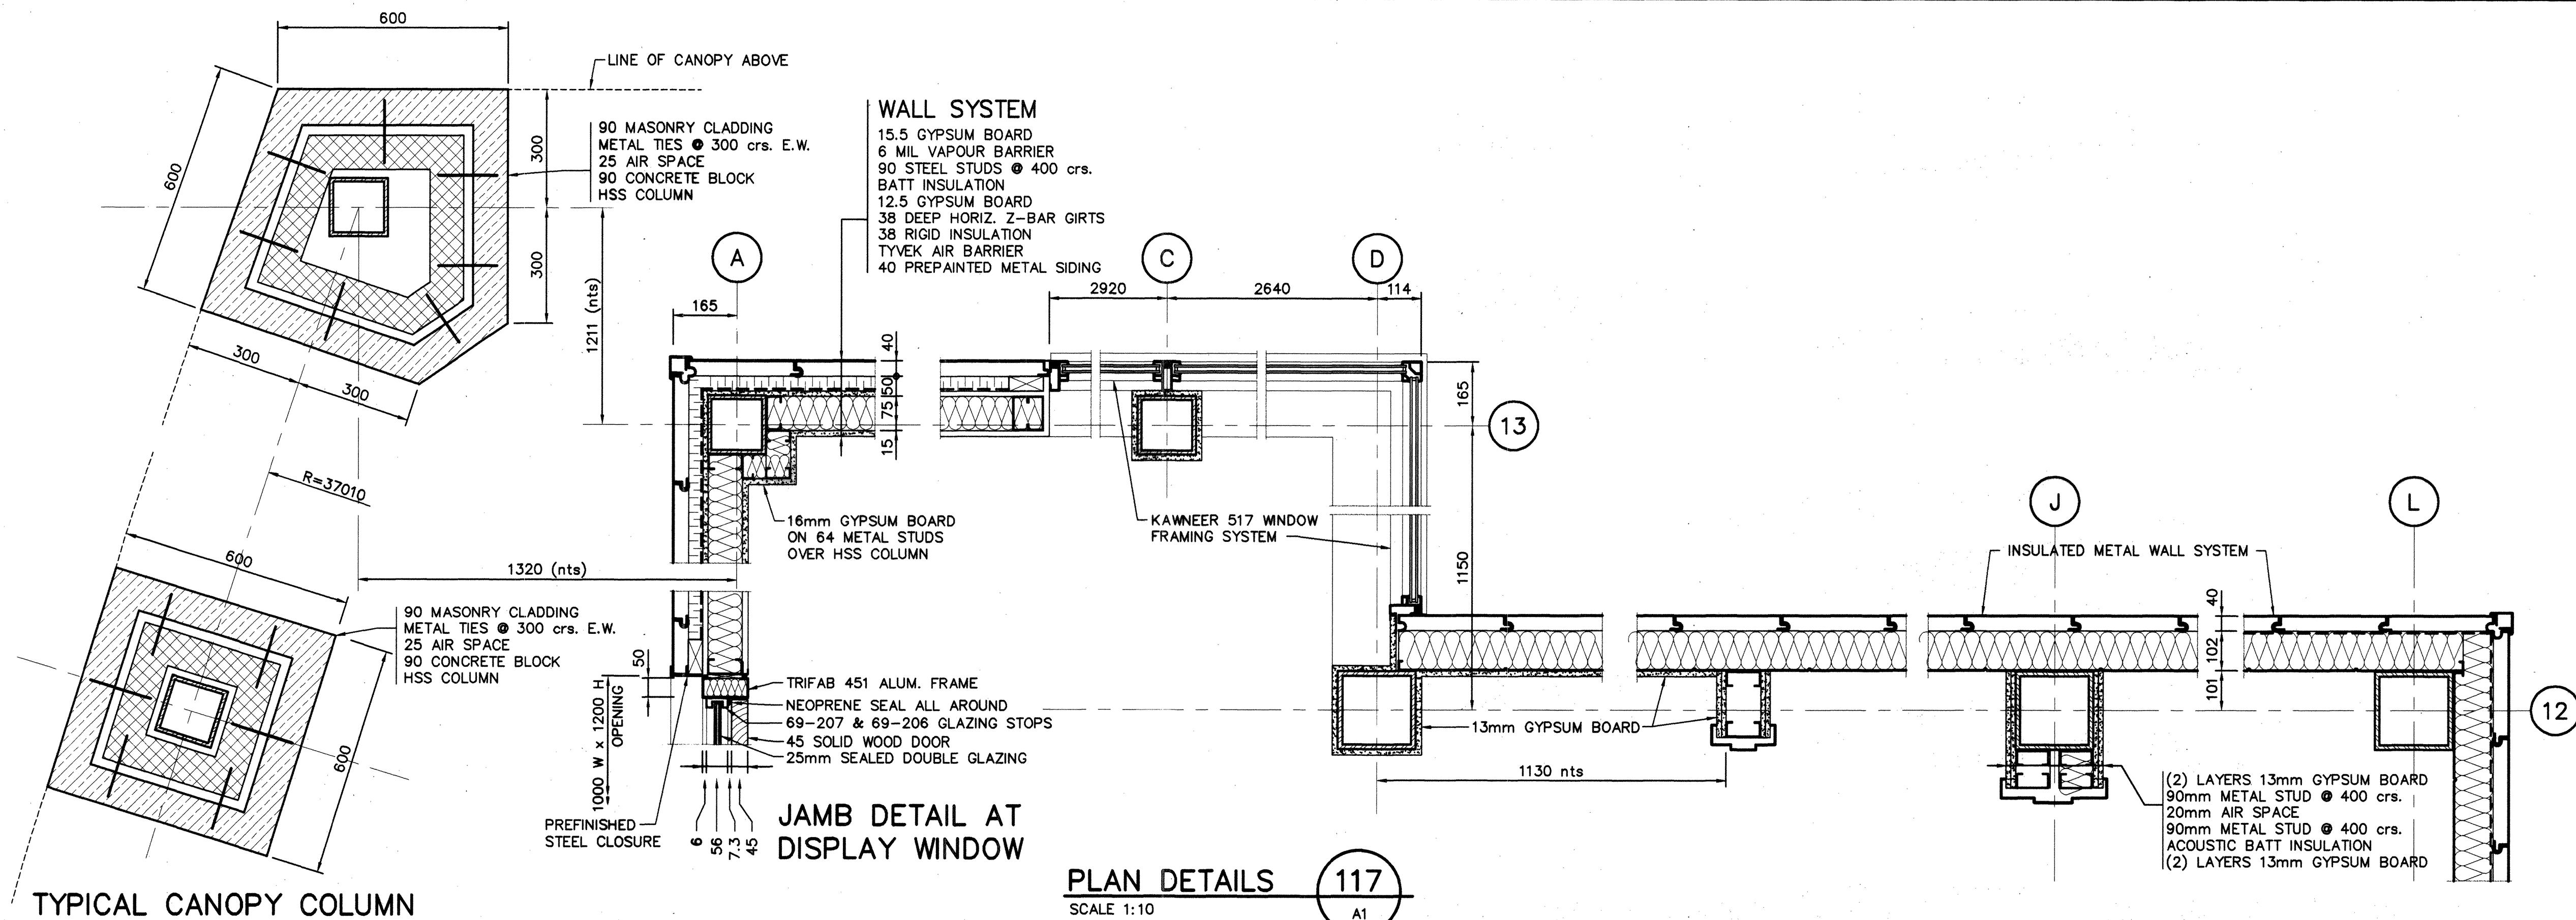

NO.	REVISION	DATE
1	ISSUED FOR TENDER	15/5/95
NO.	ISSUE	DATE

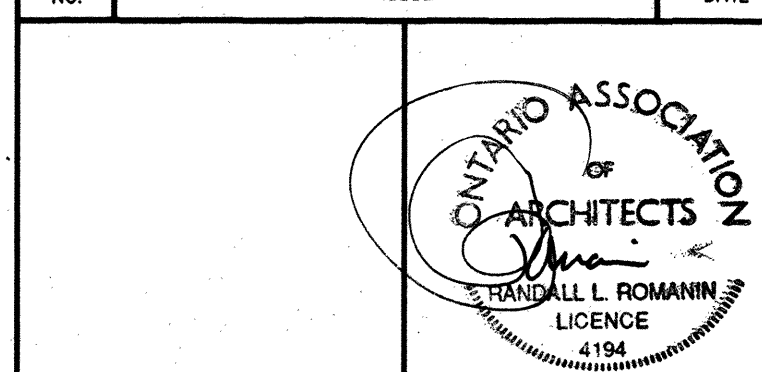

RECORD DRAWING
PRODUCED FROM INFORMATION PROVIDED BY CONTRACTOR
date: MARCH 1, 1996 TMC
J.L. RICHARDS & ASSOCIATES LIMITED

J.L. Richards & Associates Limited
Consulting Engineers, Architects & Planners
864 LADY ELLEN PLACE, OTTAWA, CANADA K1Z 3M2
Lett/Smith Architects - Design Consultants

PROJECT: **CITY OF KANATA
THE
RON MASLIN
PLAYHOUSE
Kanata, Ontario**

DRAWING: **LOBBY WALL SECTIONS
AND PLAN DETAILS**

DESIGN: STH	REVISION NO.:
DRAWN: TM	DRAWING NO.:
CHECKED: STH	A5 of 13
DATE: MAY 1995	JOB NO.: 14456
SCALE: AS NOTED	