




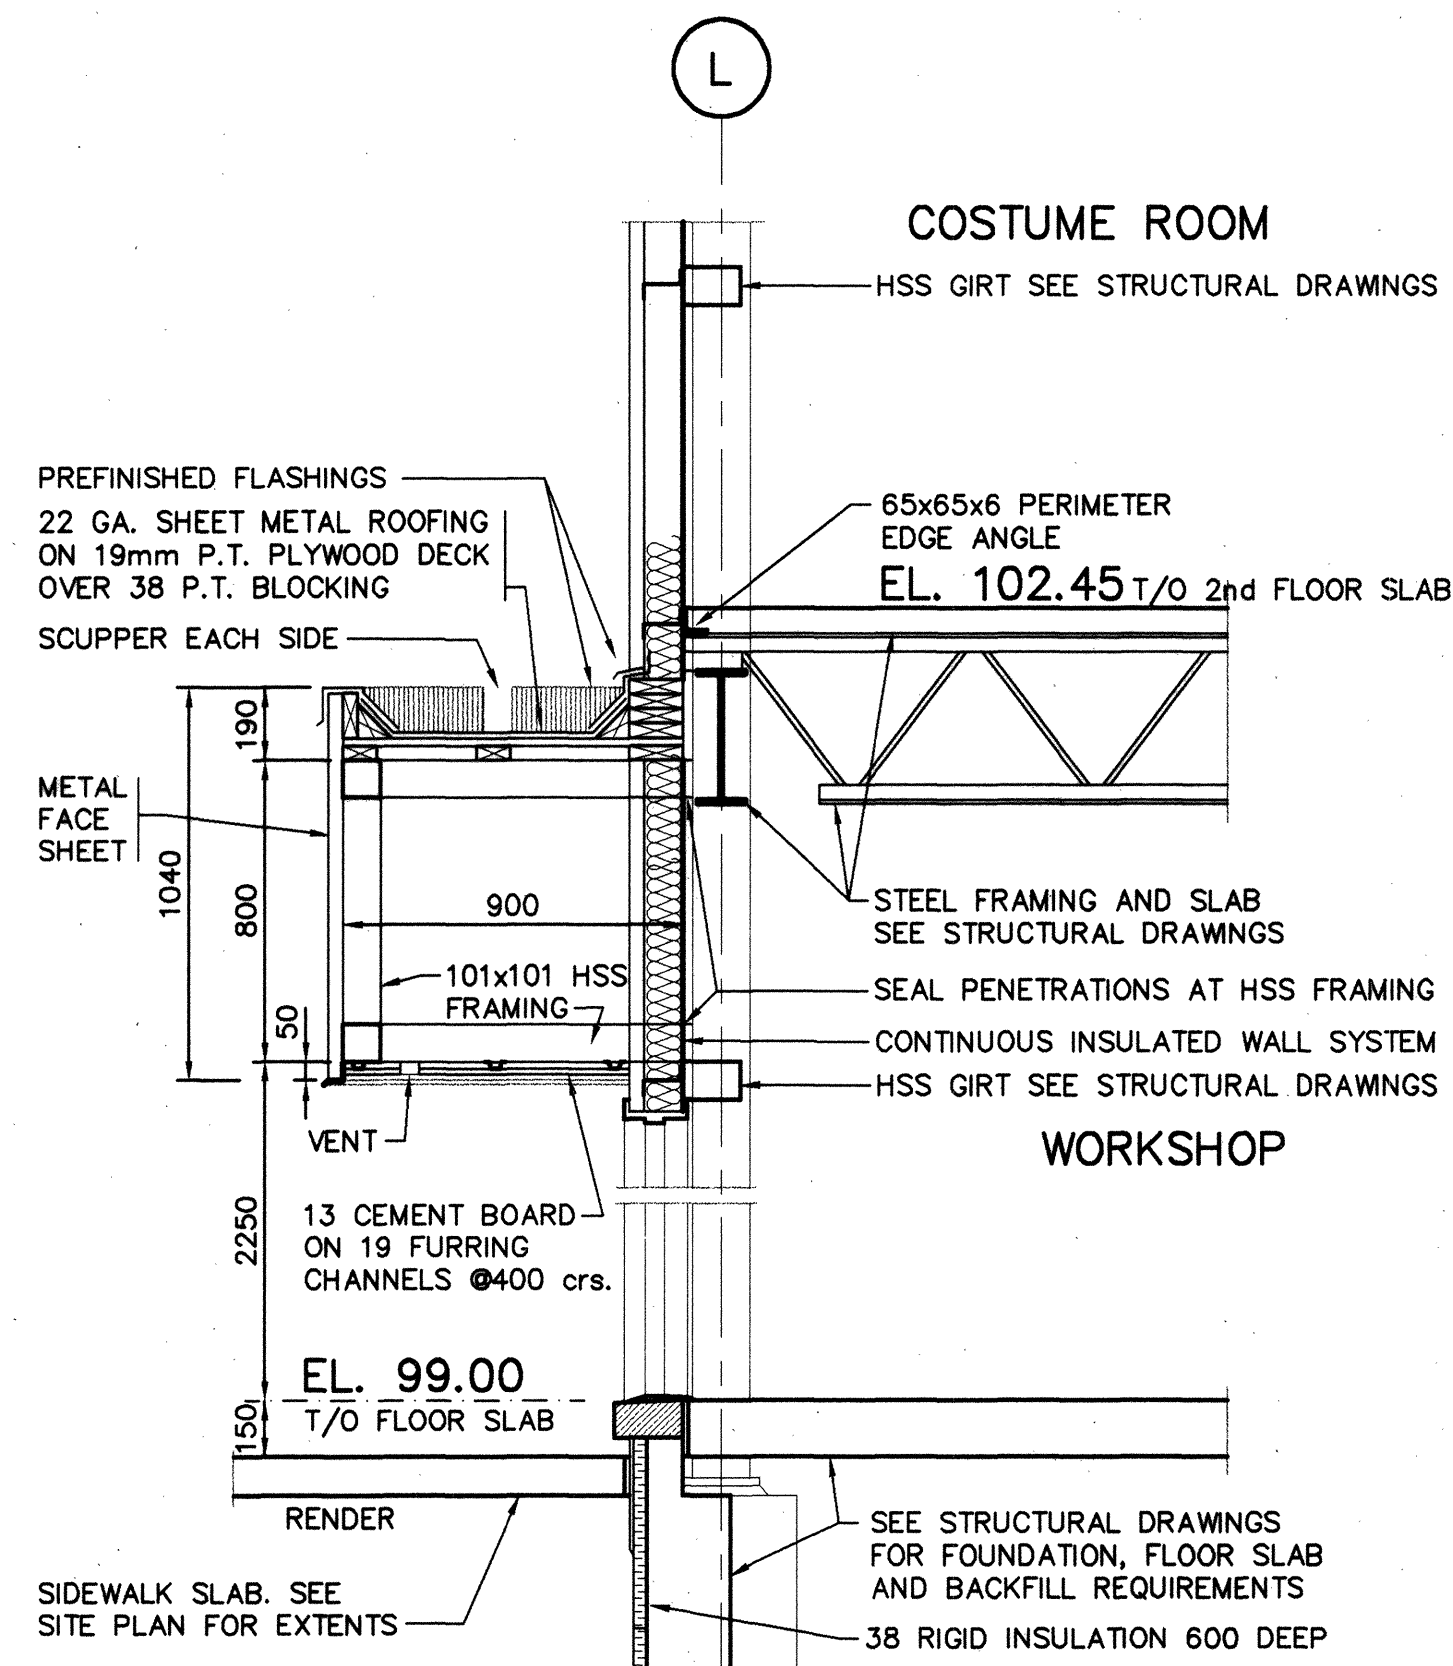

SECTION 124
SCALE 1:20

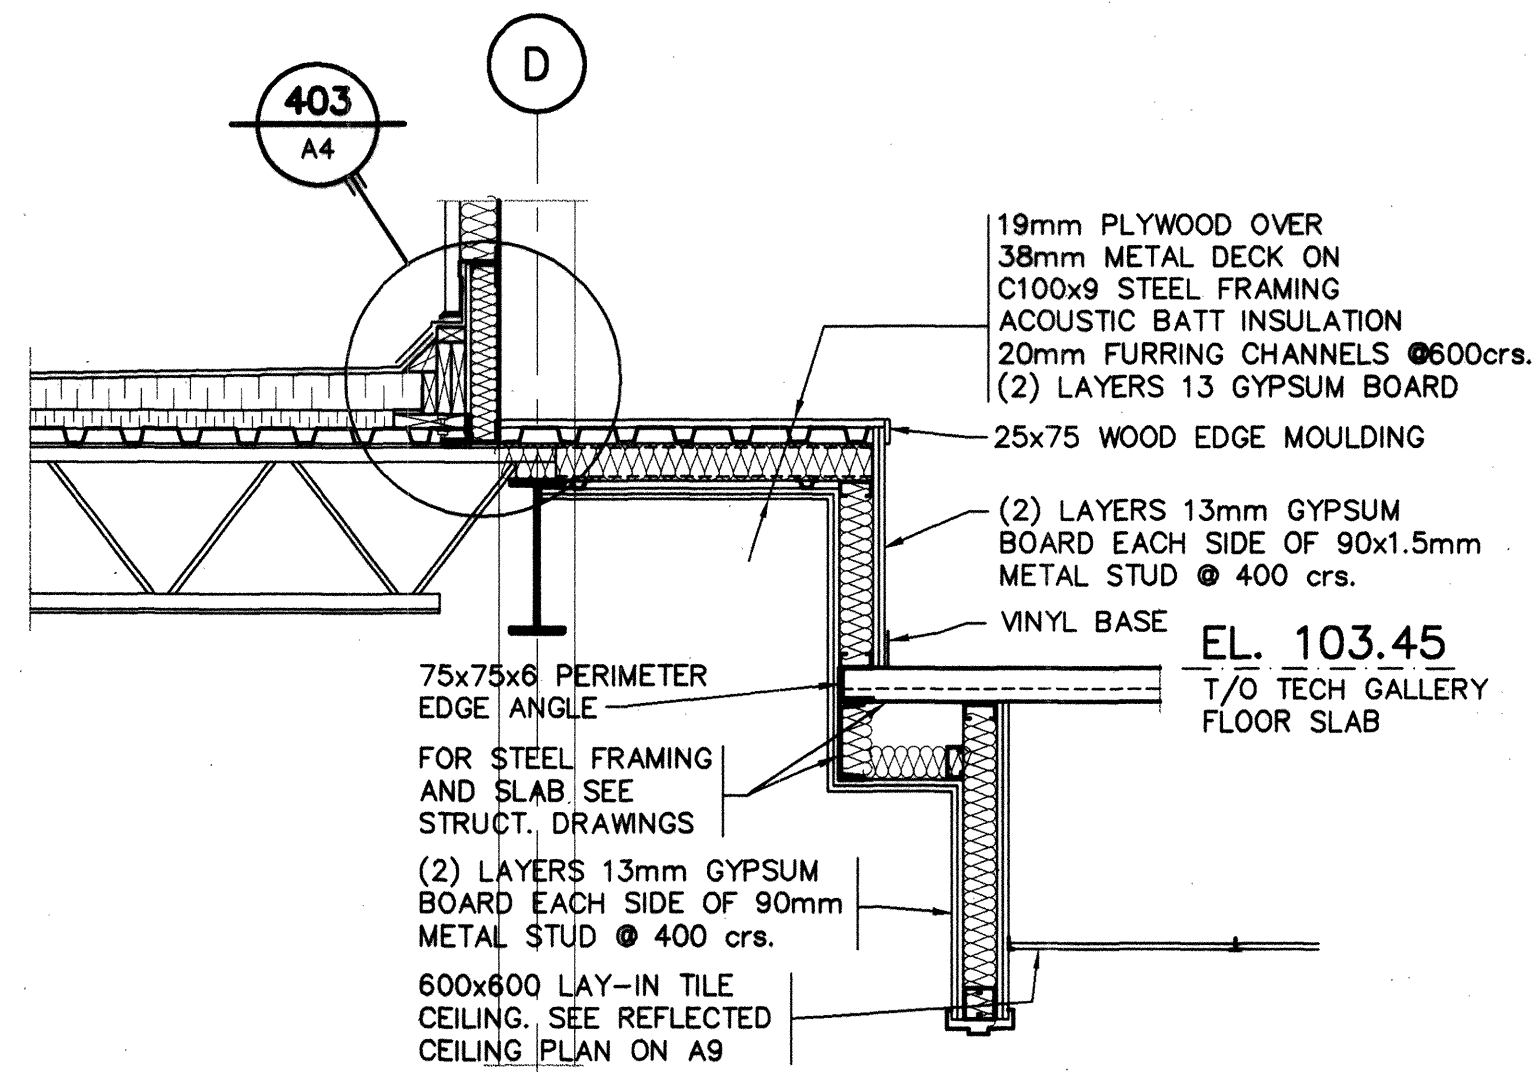


SECTION 125
SCALE 1:20

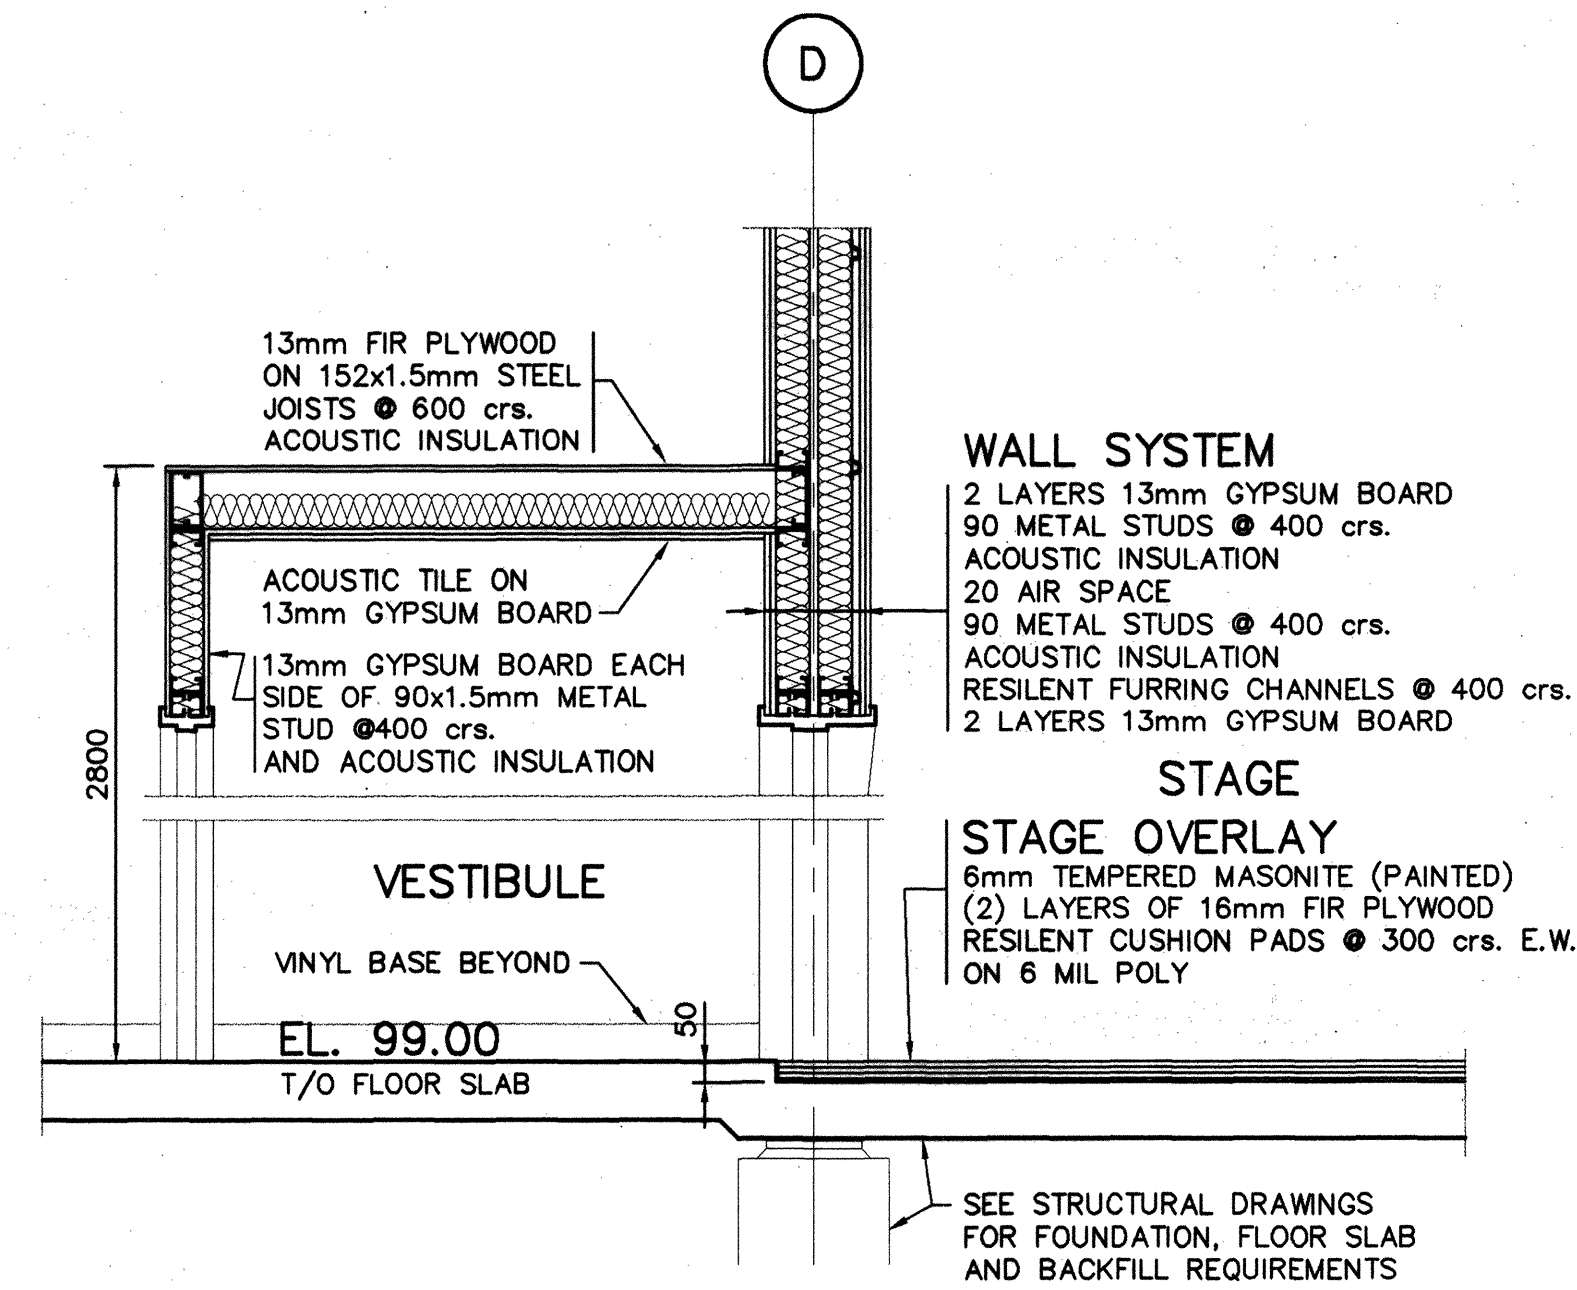


SECTION 126
SCALE 1:20


STAGE OVERLAY
6mm TEMPERED MASONITE (PAINTED)
(2) LAYERS 16mm FIR PLYWOOD
RESILIENT PADS @ 300 CRS.
6 MIL POLY

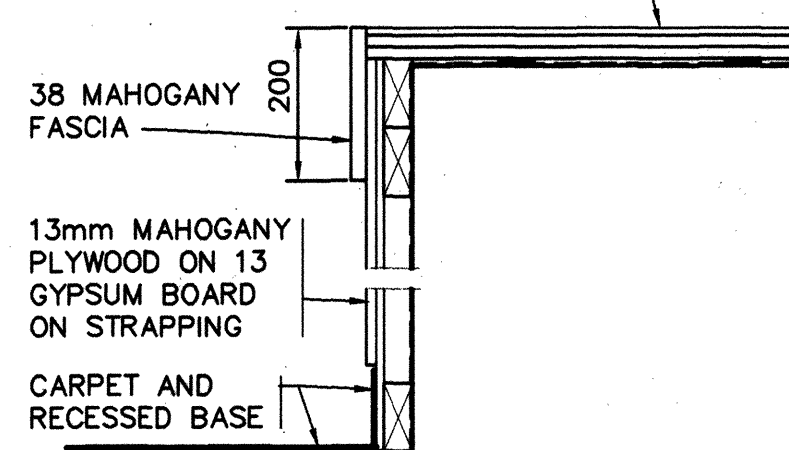


SECTION 120
SCALE 1:10

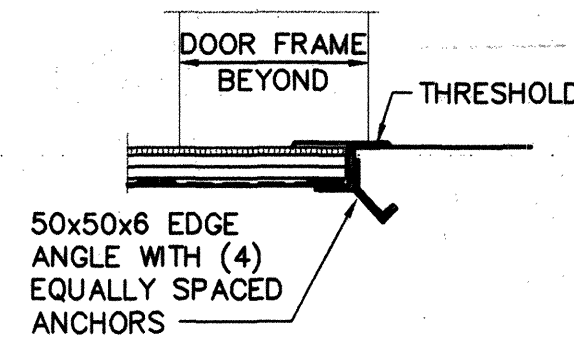


SECTION 121
SCALE 1:10

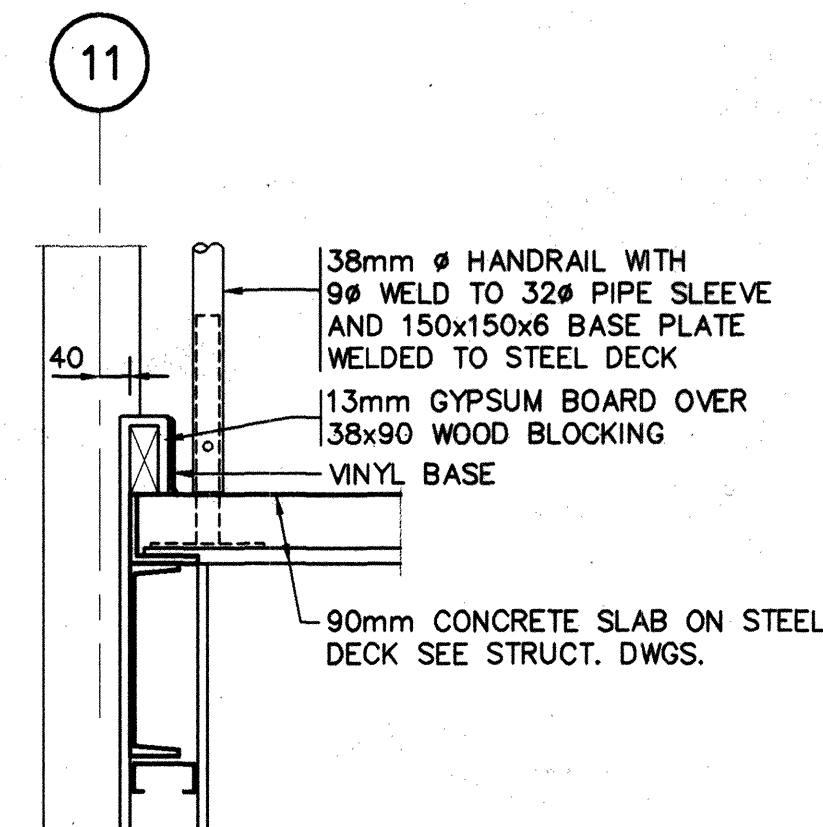


SECTION 122
SCALE 1:10

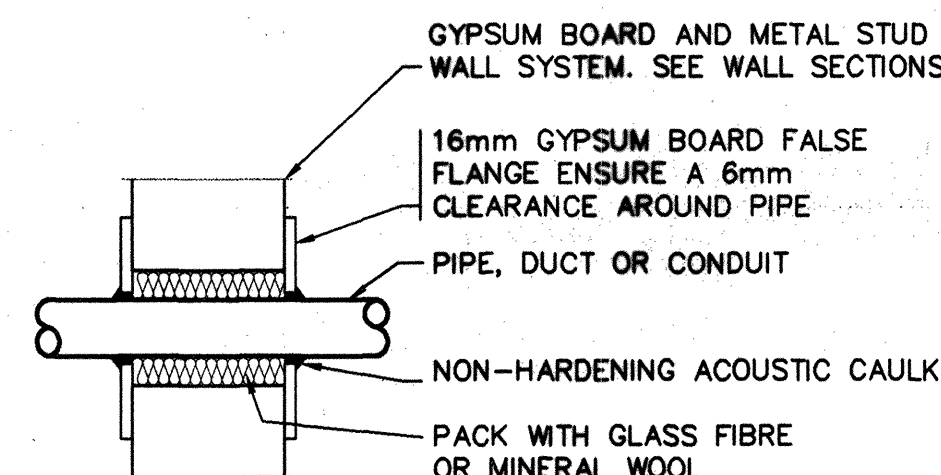


SECTION 127
SCALE 1:10

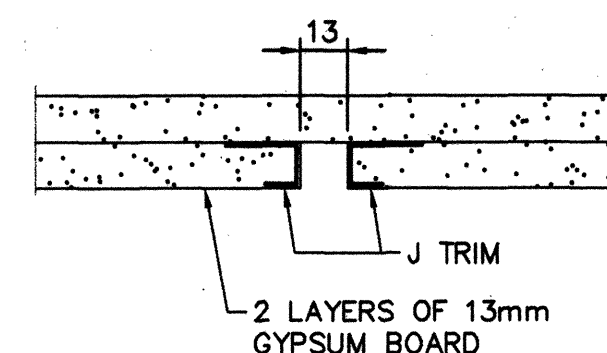


SECTION 902
SCALE 1:2

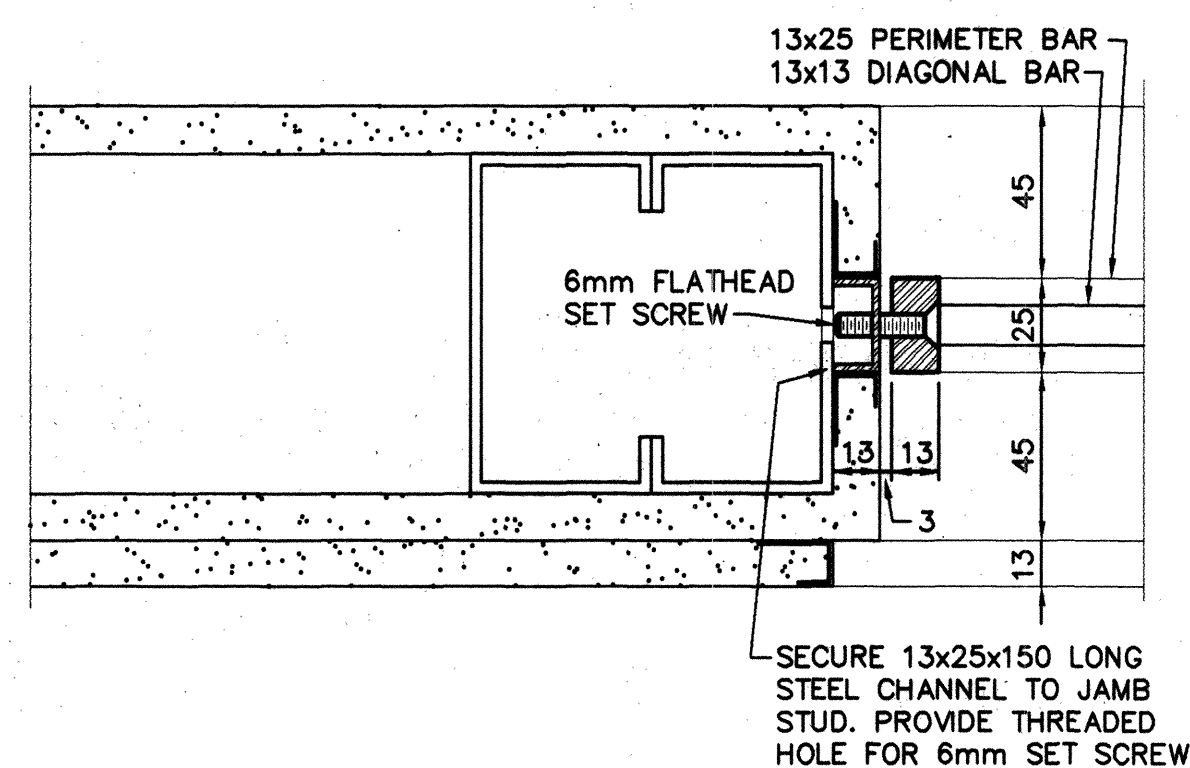

SECTION 903
SCALE 1:2

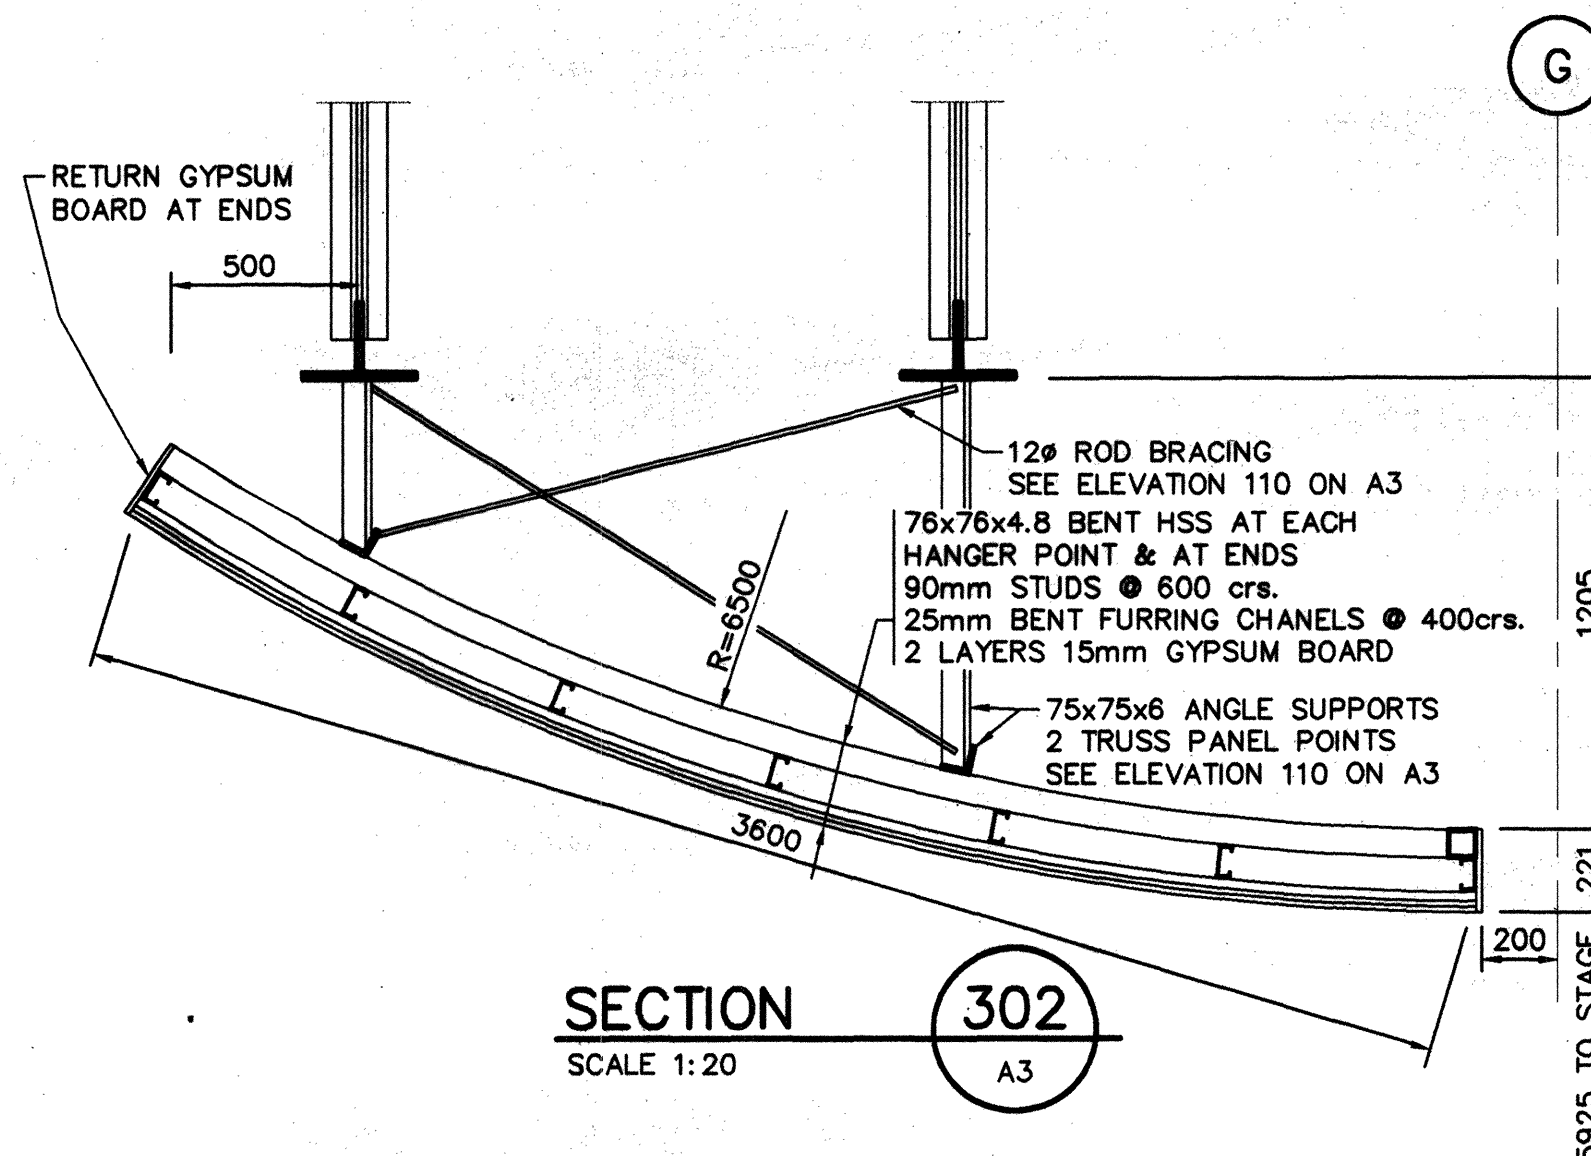


SECTION 302
SCALE 1:20

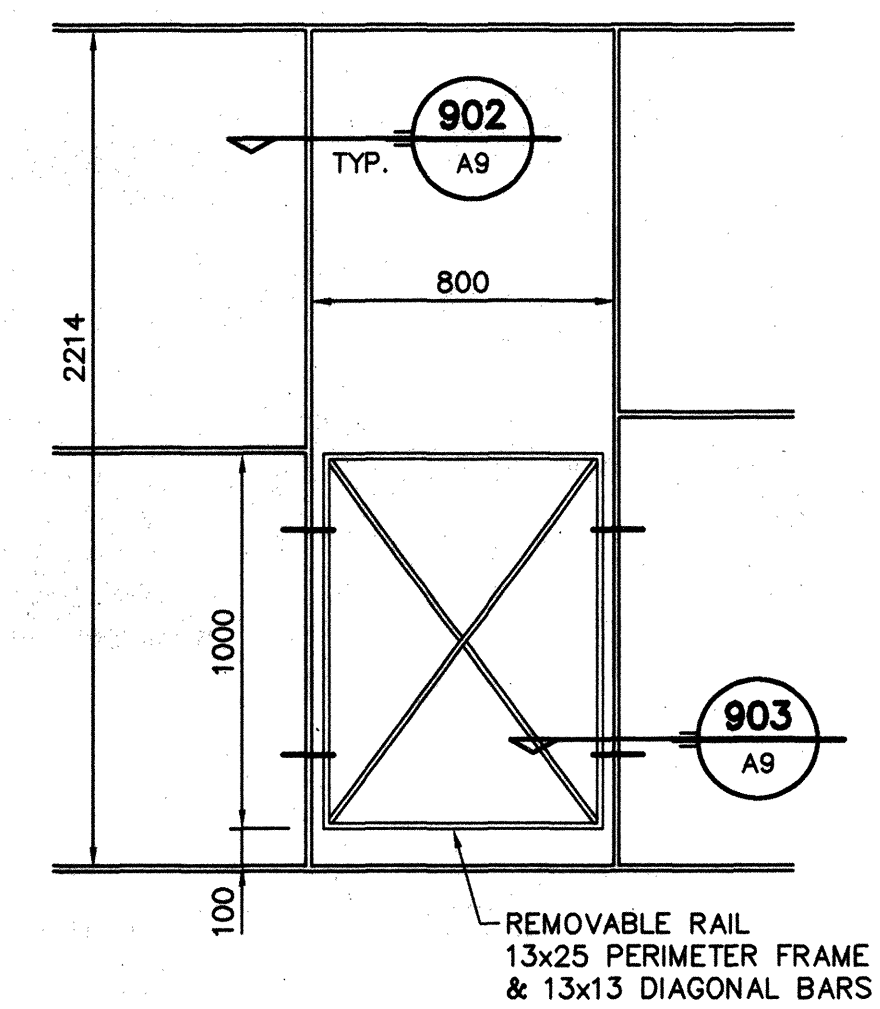

ELEVATION 301
SCALE 1:20



NO.	REVISION	DATE
1	ISSUED FOR TENDER	15/5/95

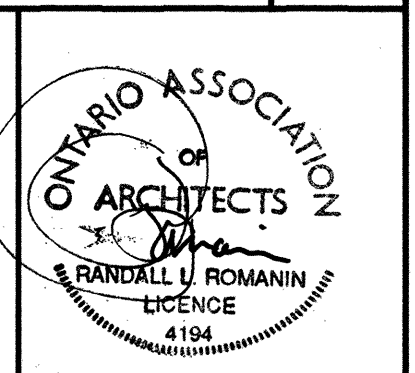

RECORD DRAWING
PRODUCED FROM INFORMATION PROVIDED BY CONTRACTOR
date: MARCH 1, 1996 Tmc
J.L. RICHARDS & ASSOCIATES LIMITED

J.L. Richards & Associates Limited
Consulting Engineers, Architects & Planners
884 LADY ELLEN PLACE, OTTAWA, CANADA K1Z 5M2
Lett/Smith Architects • Design Consultants

PROJECT: **CITY OF KANATA
THE
RON MASLIN
PLAYHOUSE
Kanata, Ontario**

**MISCELLANEOUS
SECTIONS AND DETAILS**

DESIGN: STH	REVISION NO.:
DRAWN: TM	DRAWING NO.:
CHECKED: STH	A9 of 13
DATE: MAY 1995	JOB NO.: 14456
SCALE: AS NOTED	