

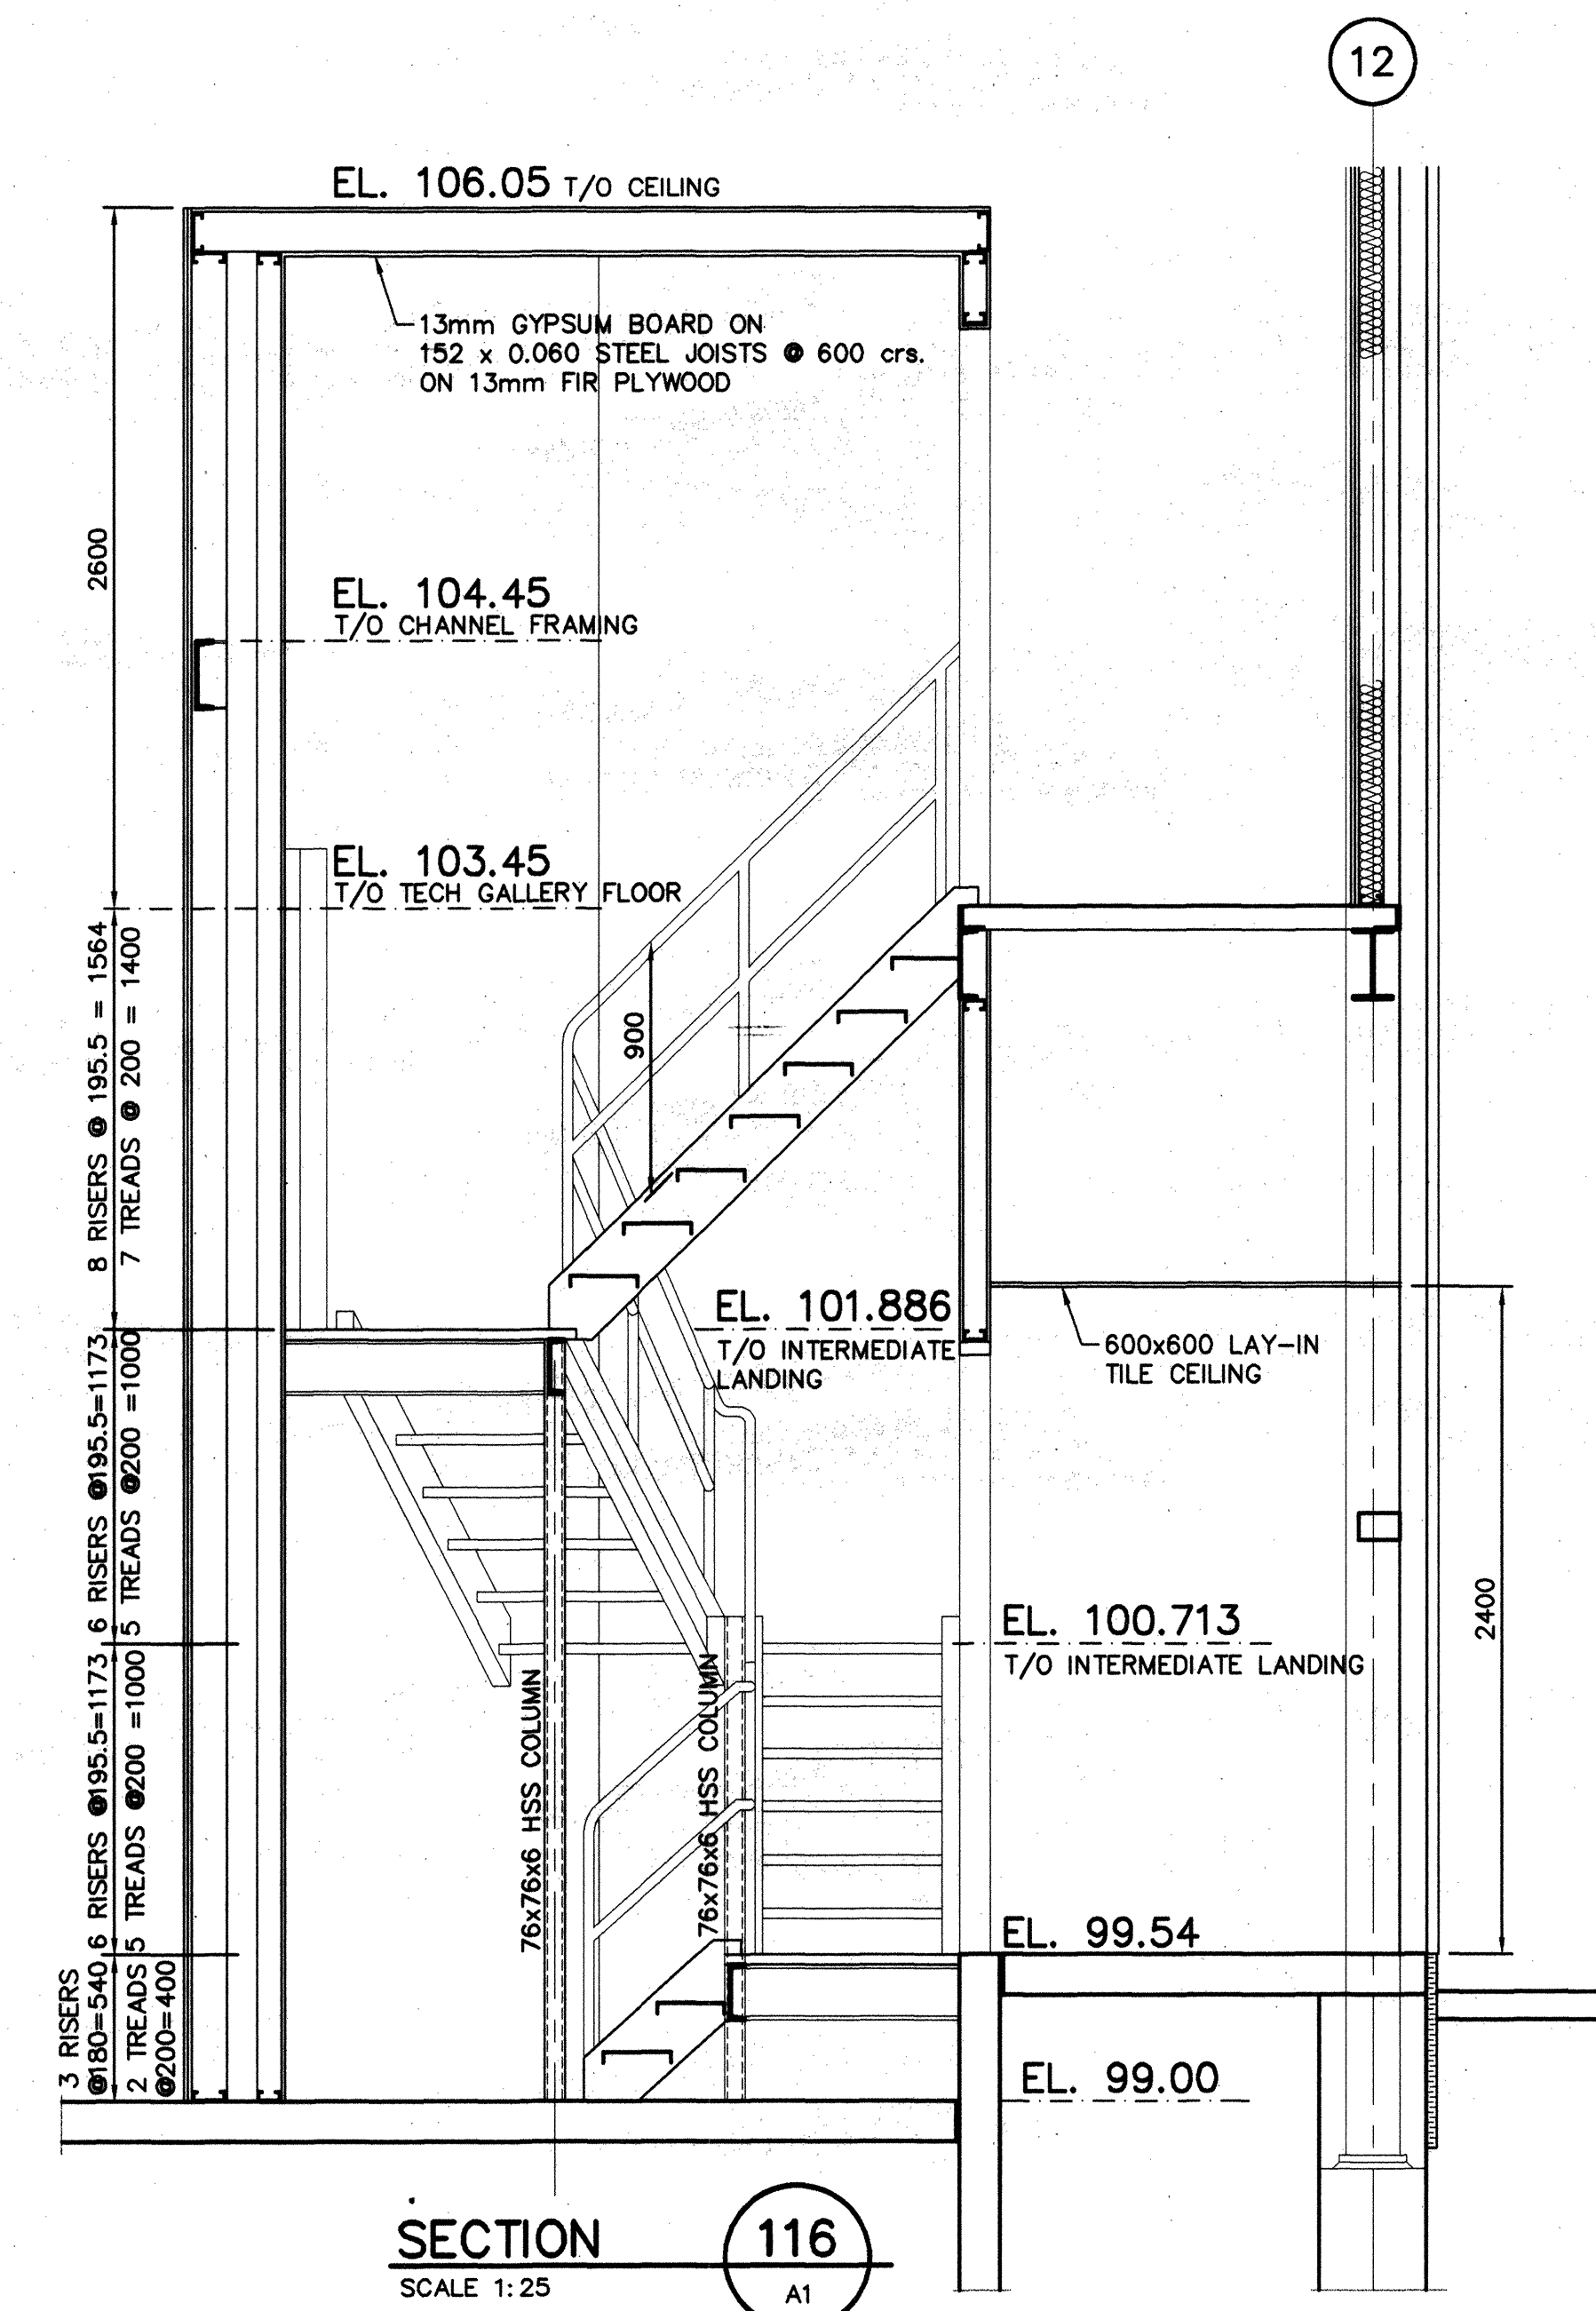
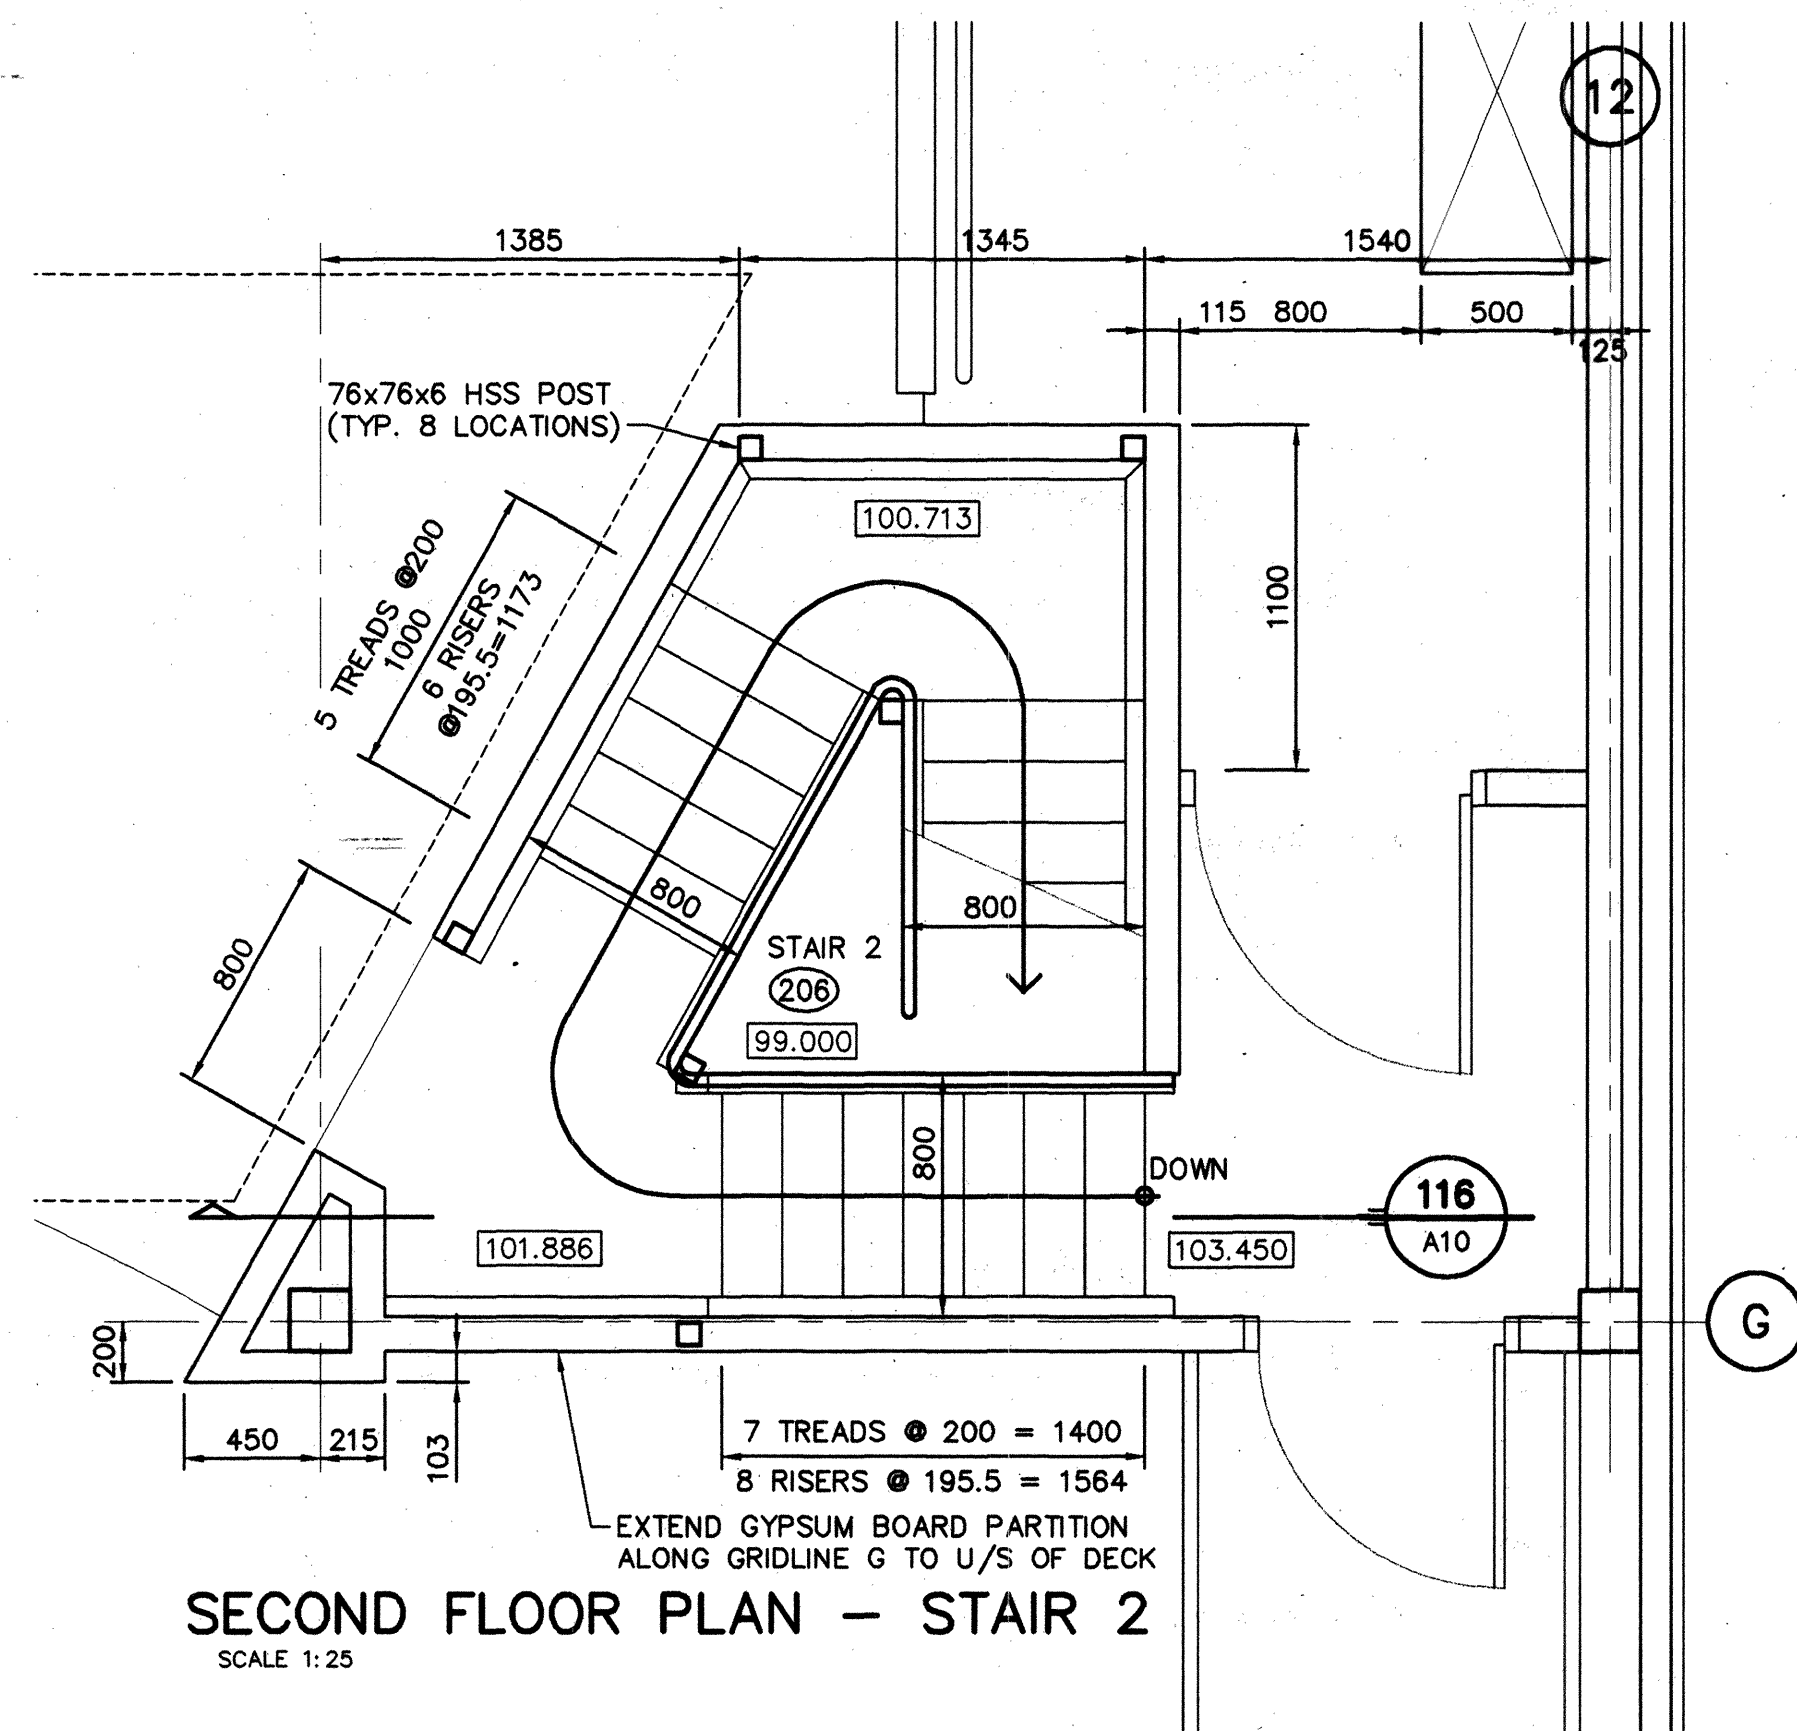
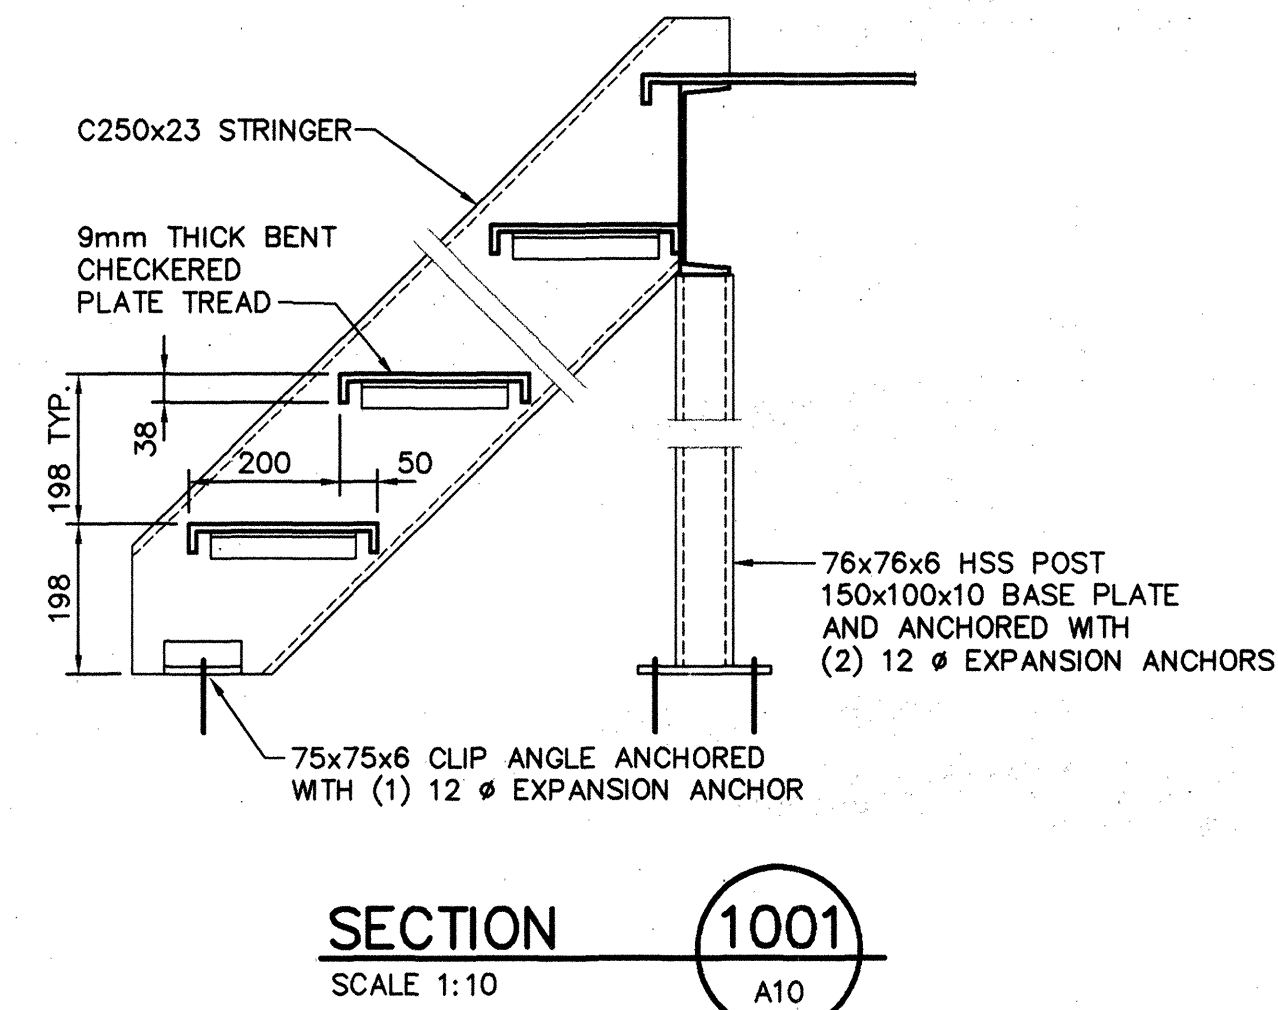


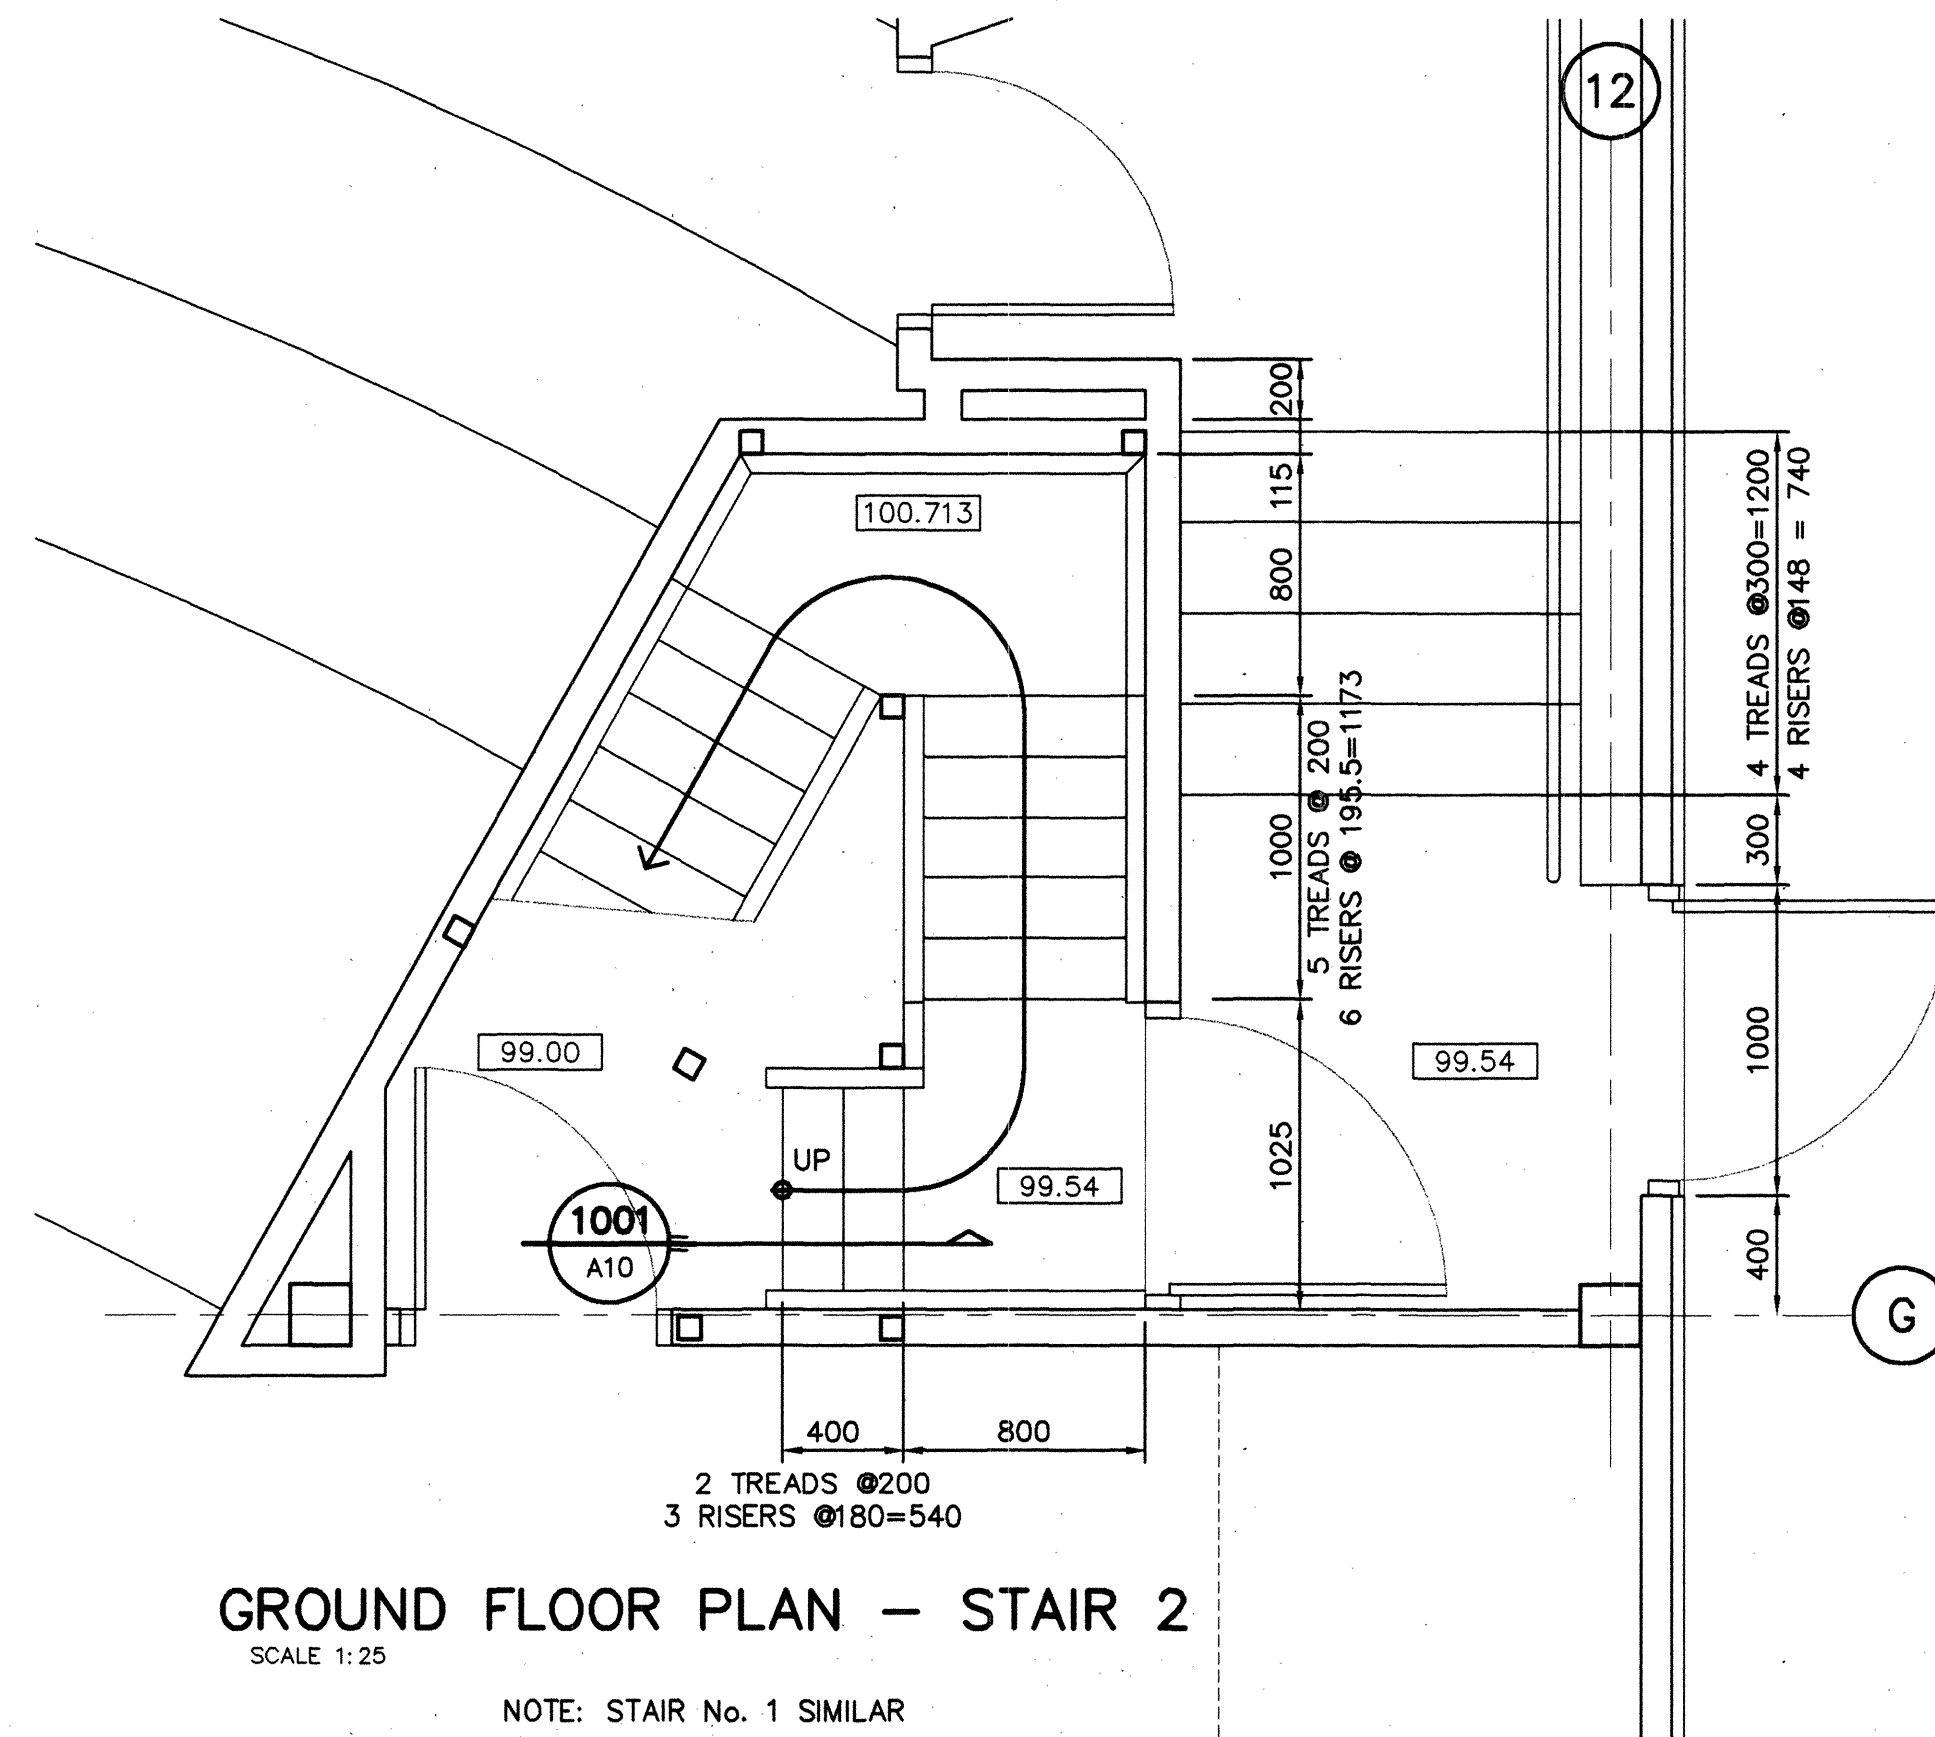

NO.	REVISION	DATE
1	ISSUED FOR TENDER	15/5/95
NO.	ISSUE	DATE

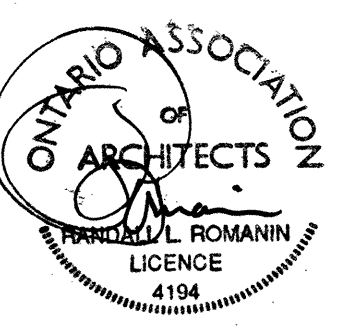

RECORD DRAWING
PRODUCED FROM INFORMATION PROVIDED BY CONTRACTOR
date: MARCH 1, 1996 TMC
J.L. RICHARDS & ASSOCIATES LIMITED

J.L. Richards & Associates Limited
Consulting Engineers, Architects & Planners
884 LADY ELLEN PLACE, OTTAWA, CANADA K1Z 5M2
Lett/Smith Architects - Design Consultants

PROJECT: **CITY OF KANATA
THE
RON MASLIN
PLAYHOUSE**
Kanata, Ontario

DRAWING: **STAIR No. 1 AND 2
PLANS, SECTION AND DETAIL**

DESIGN: STH	REVISION NO.:
DRAWN: TM	DRAWING NO.:
CHECKED: STH	A10 of 13
DATE: MAY 1995	JOB NO.:
SCALE: 1 : 100	14456