
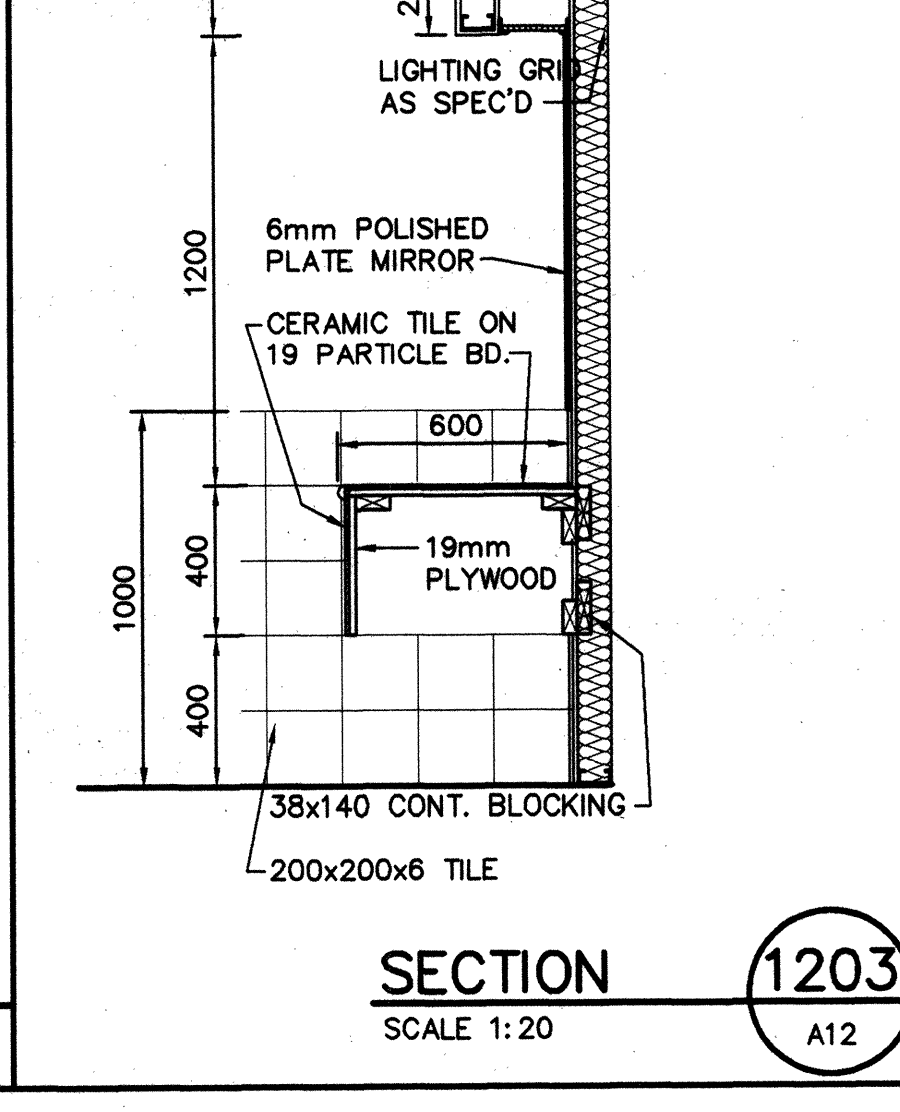
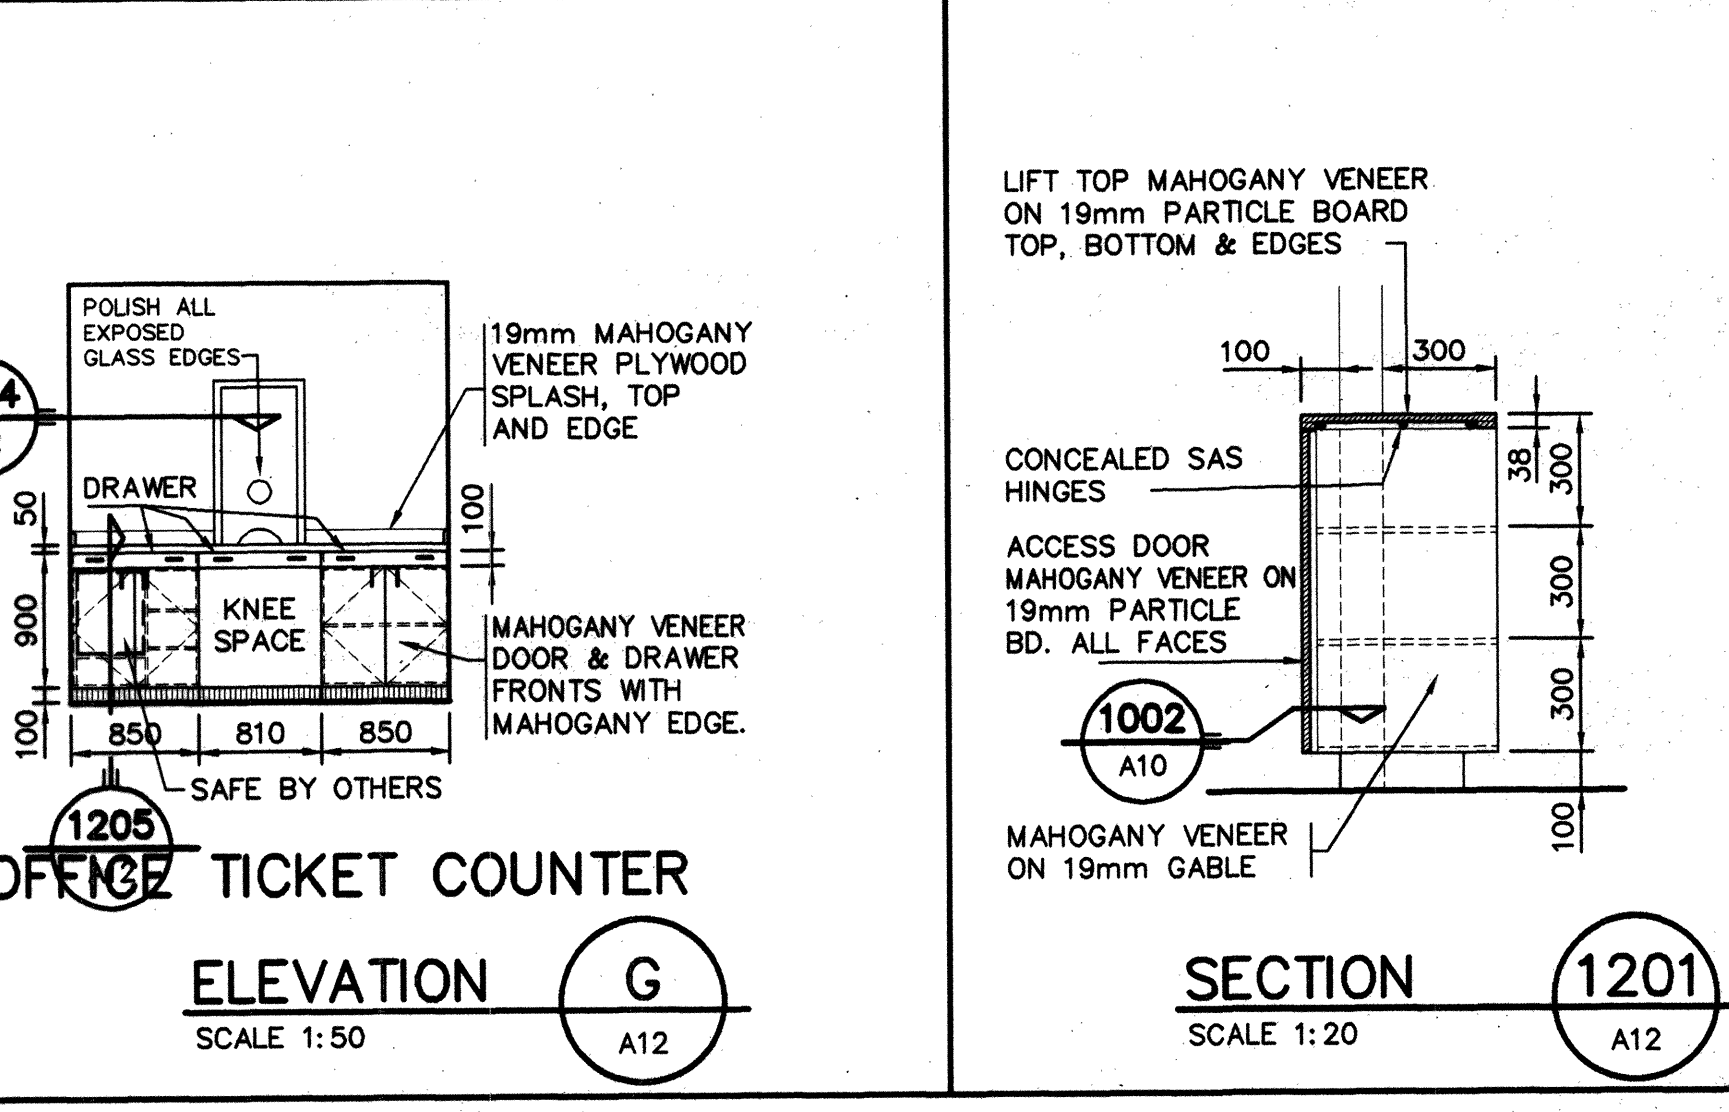
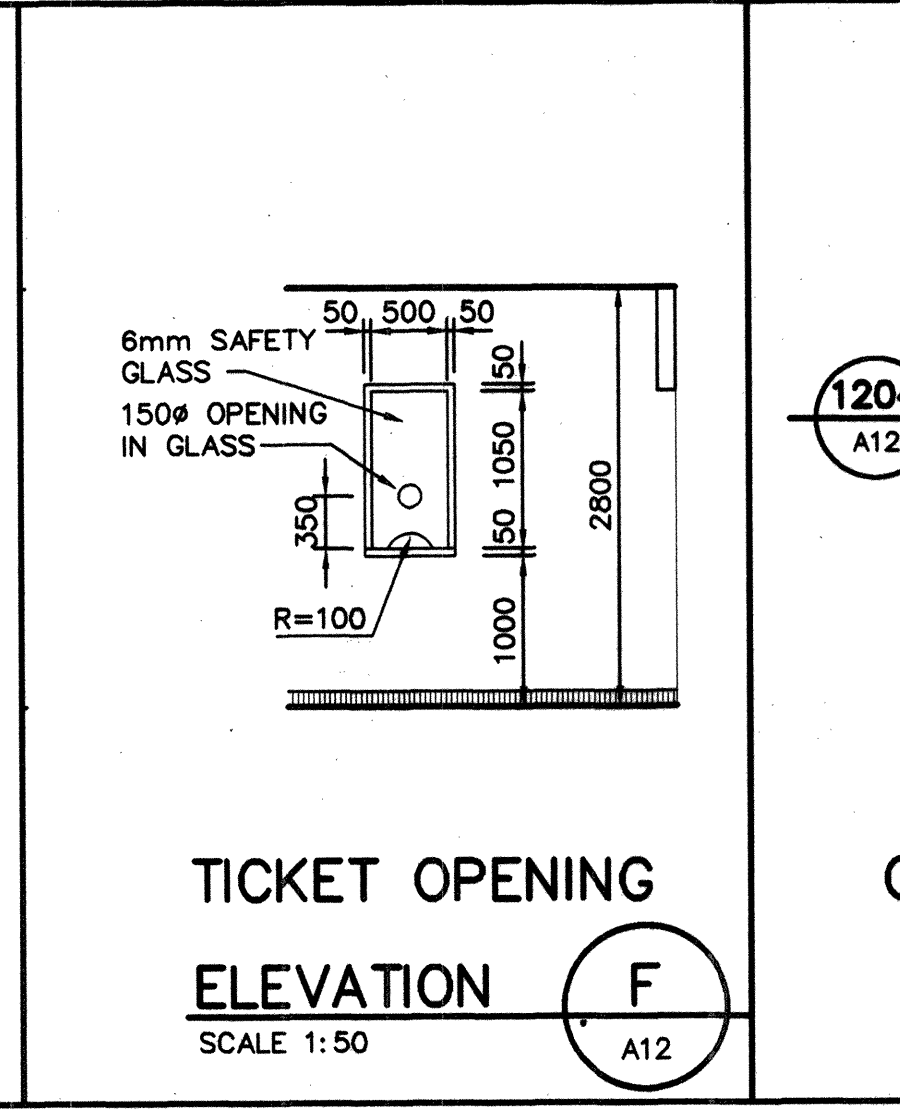
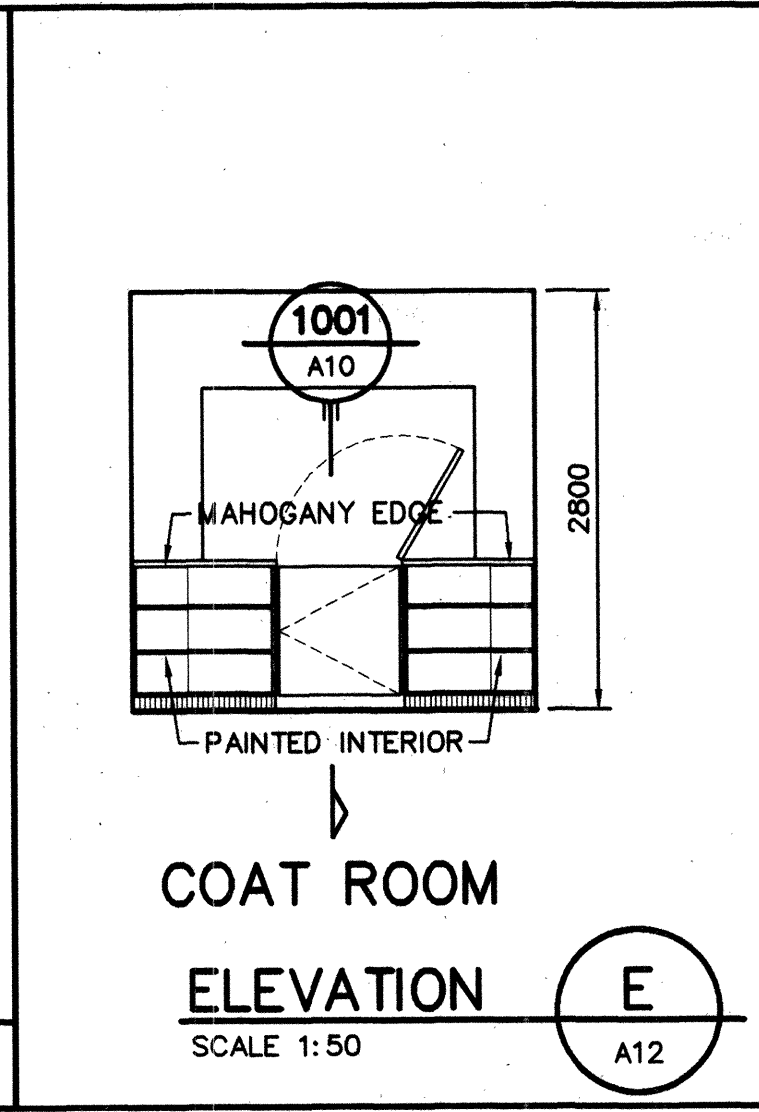
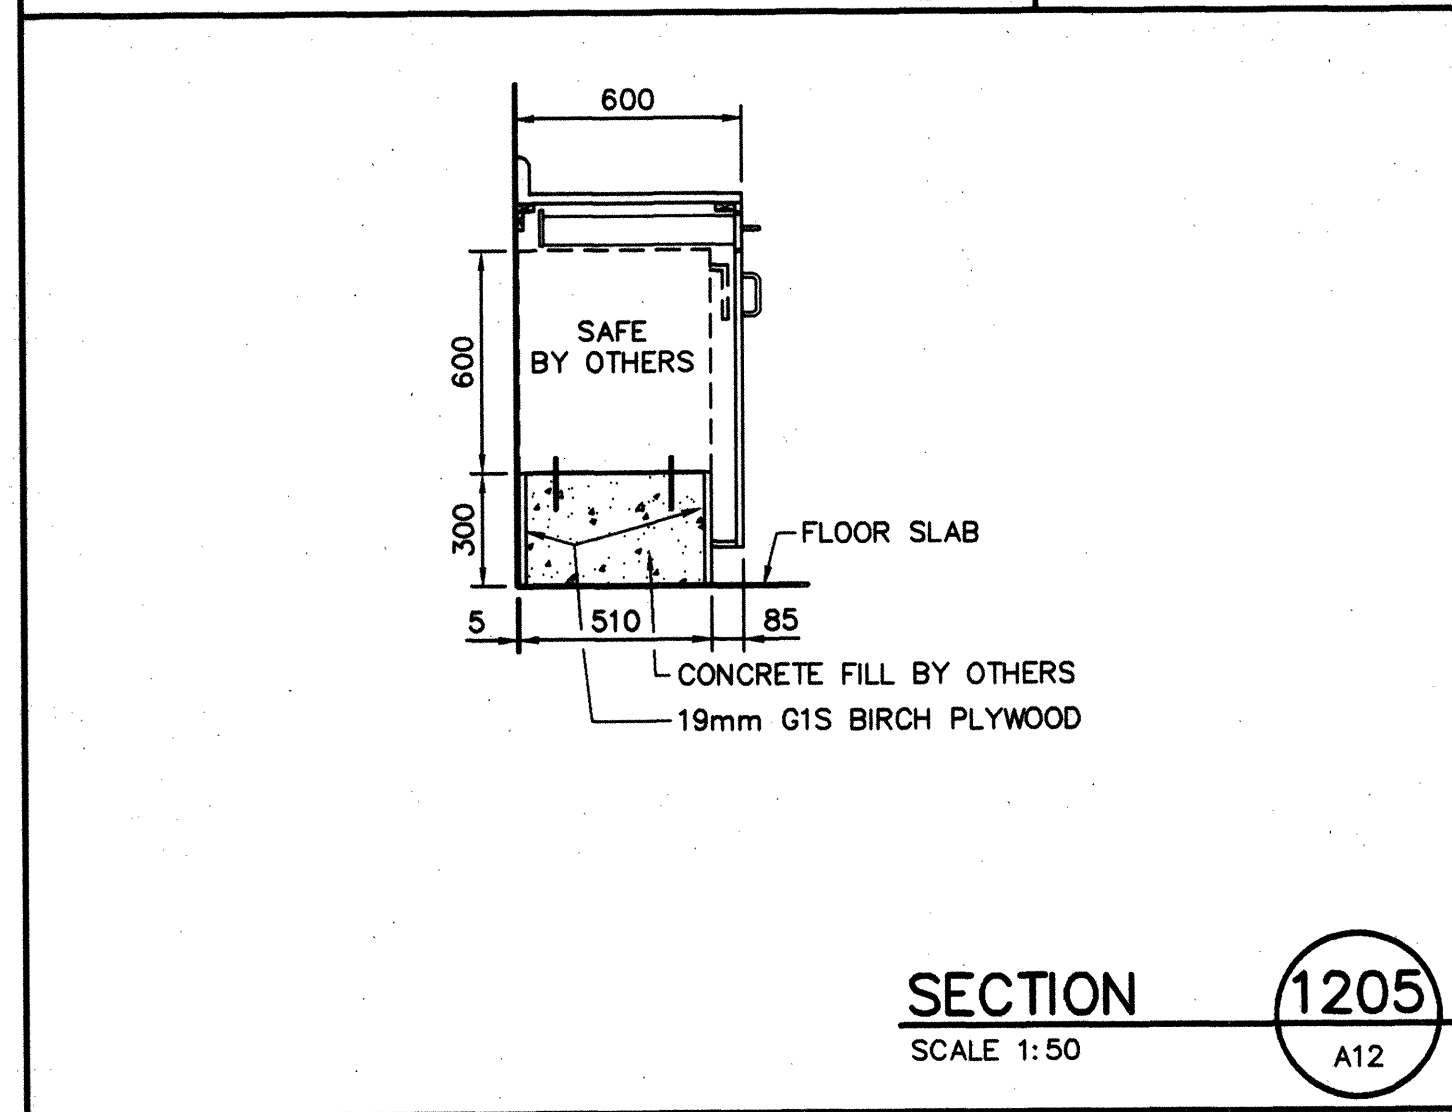
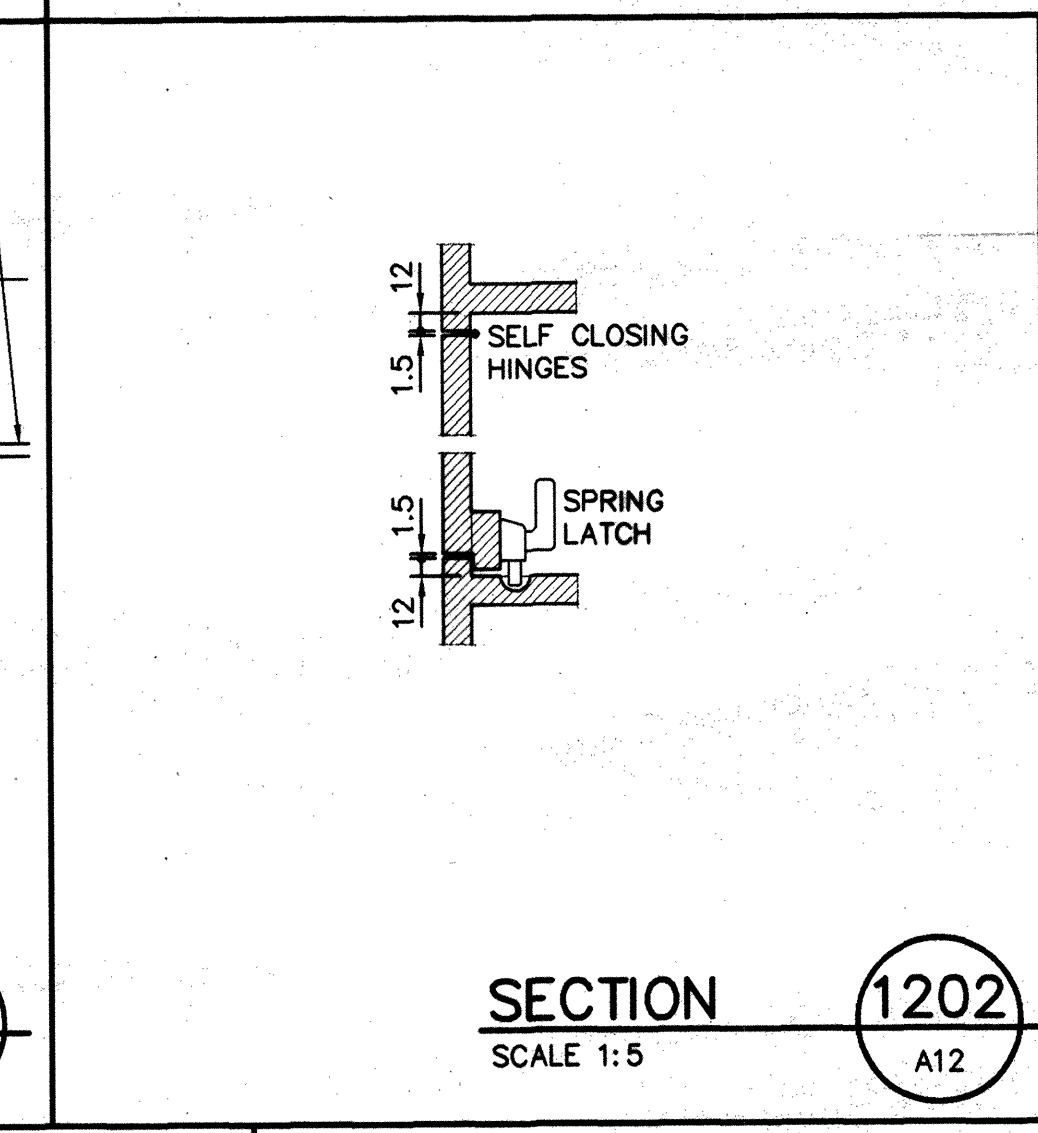
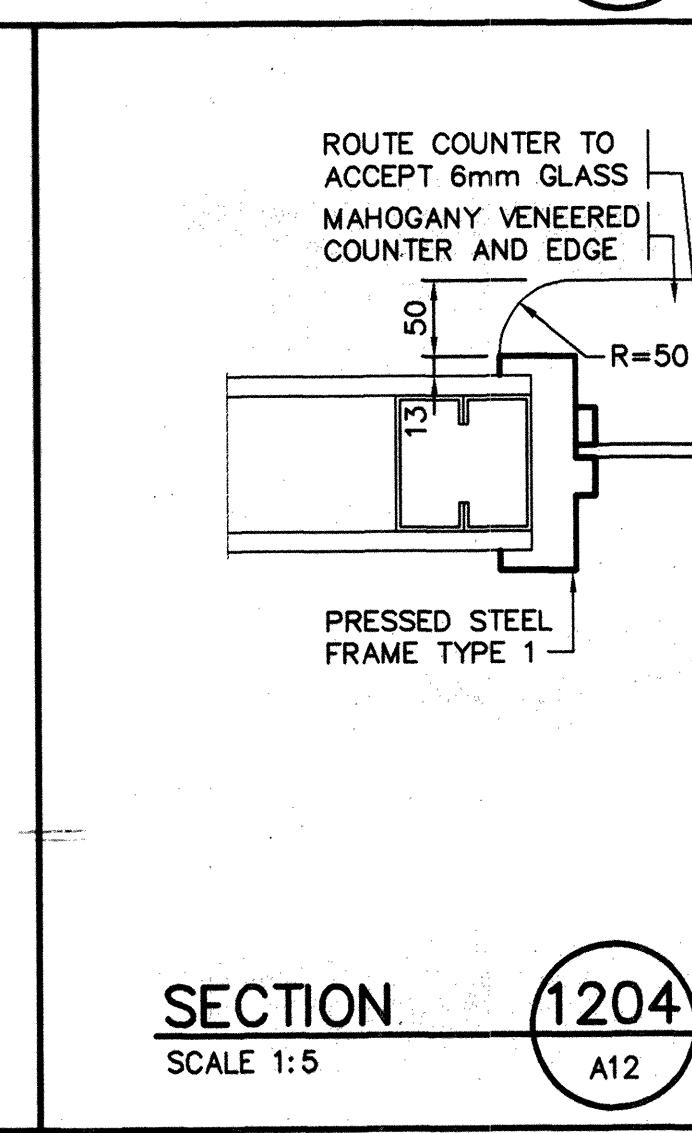
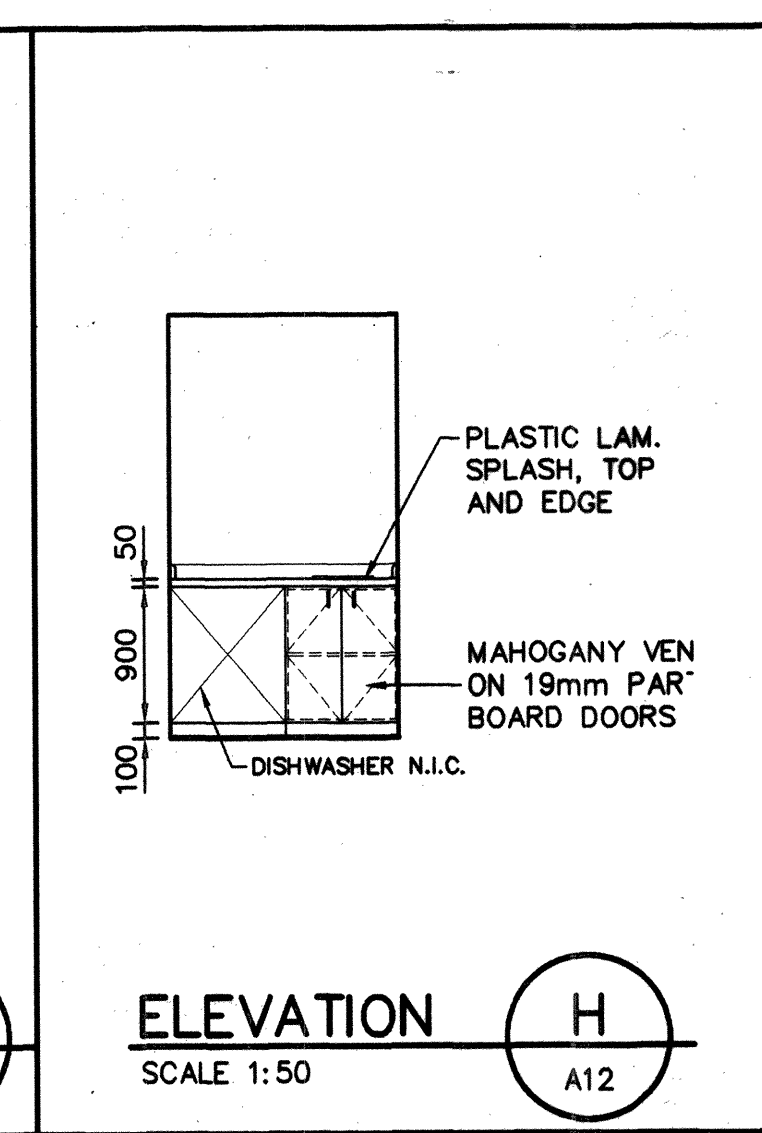
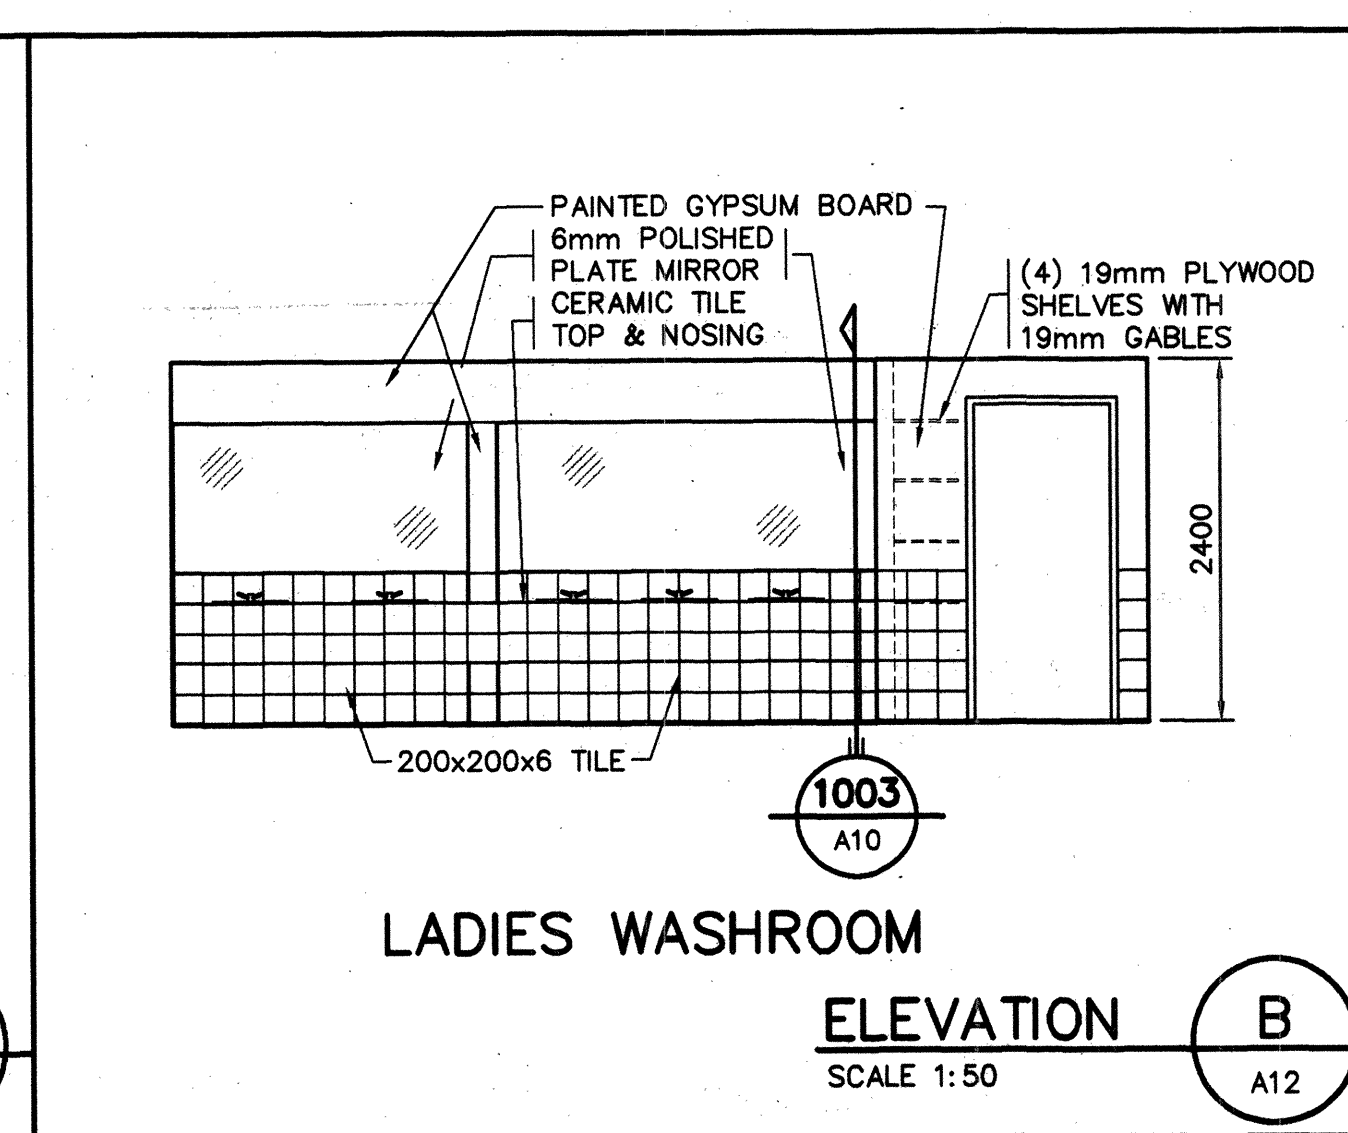
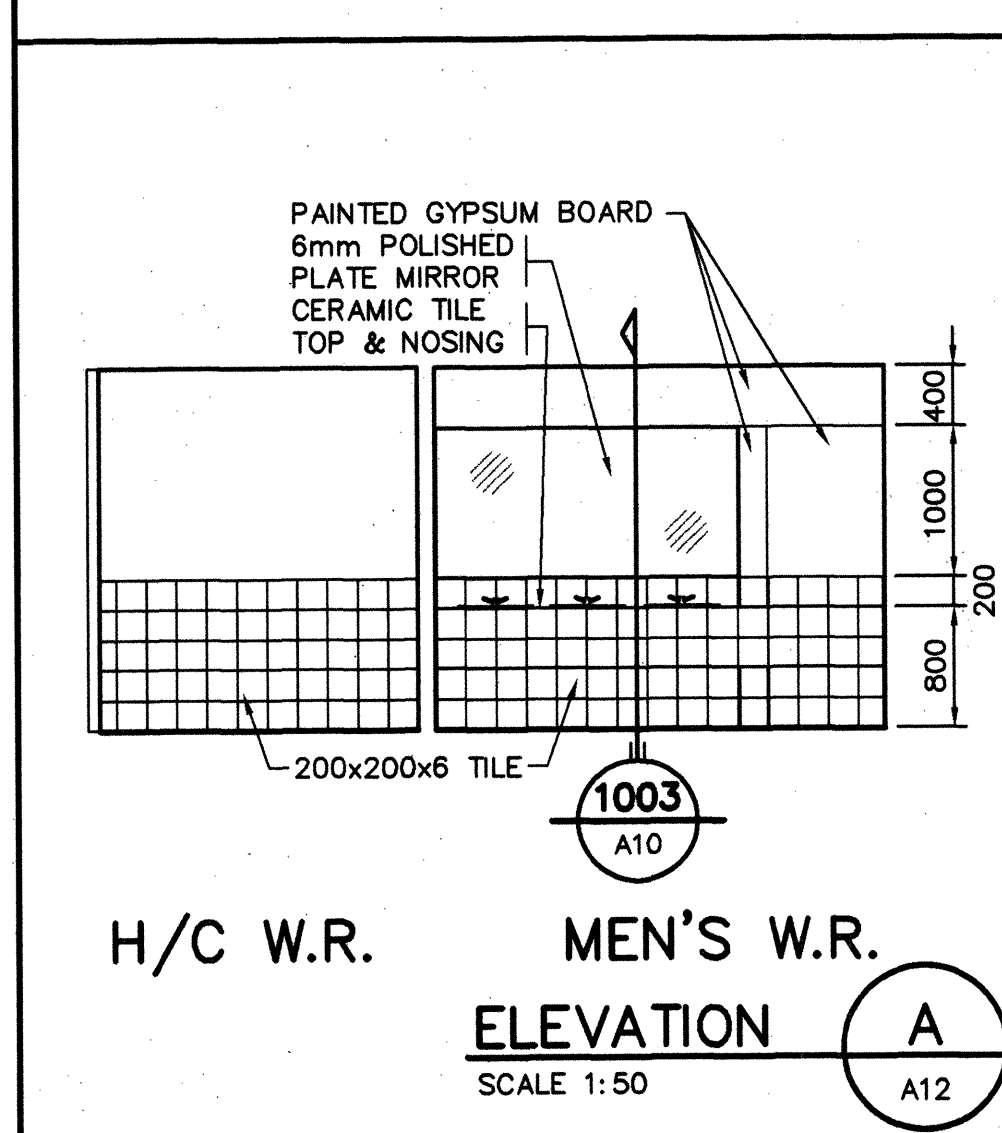
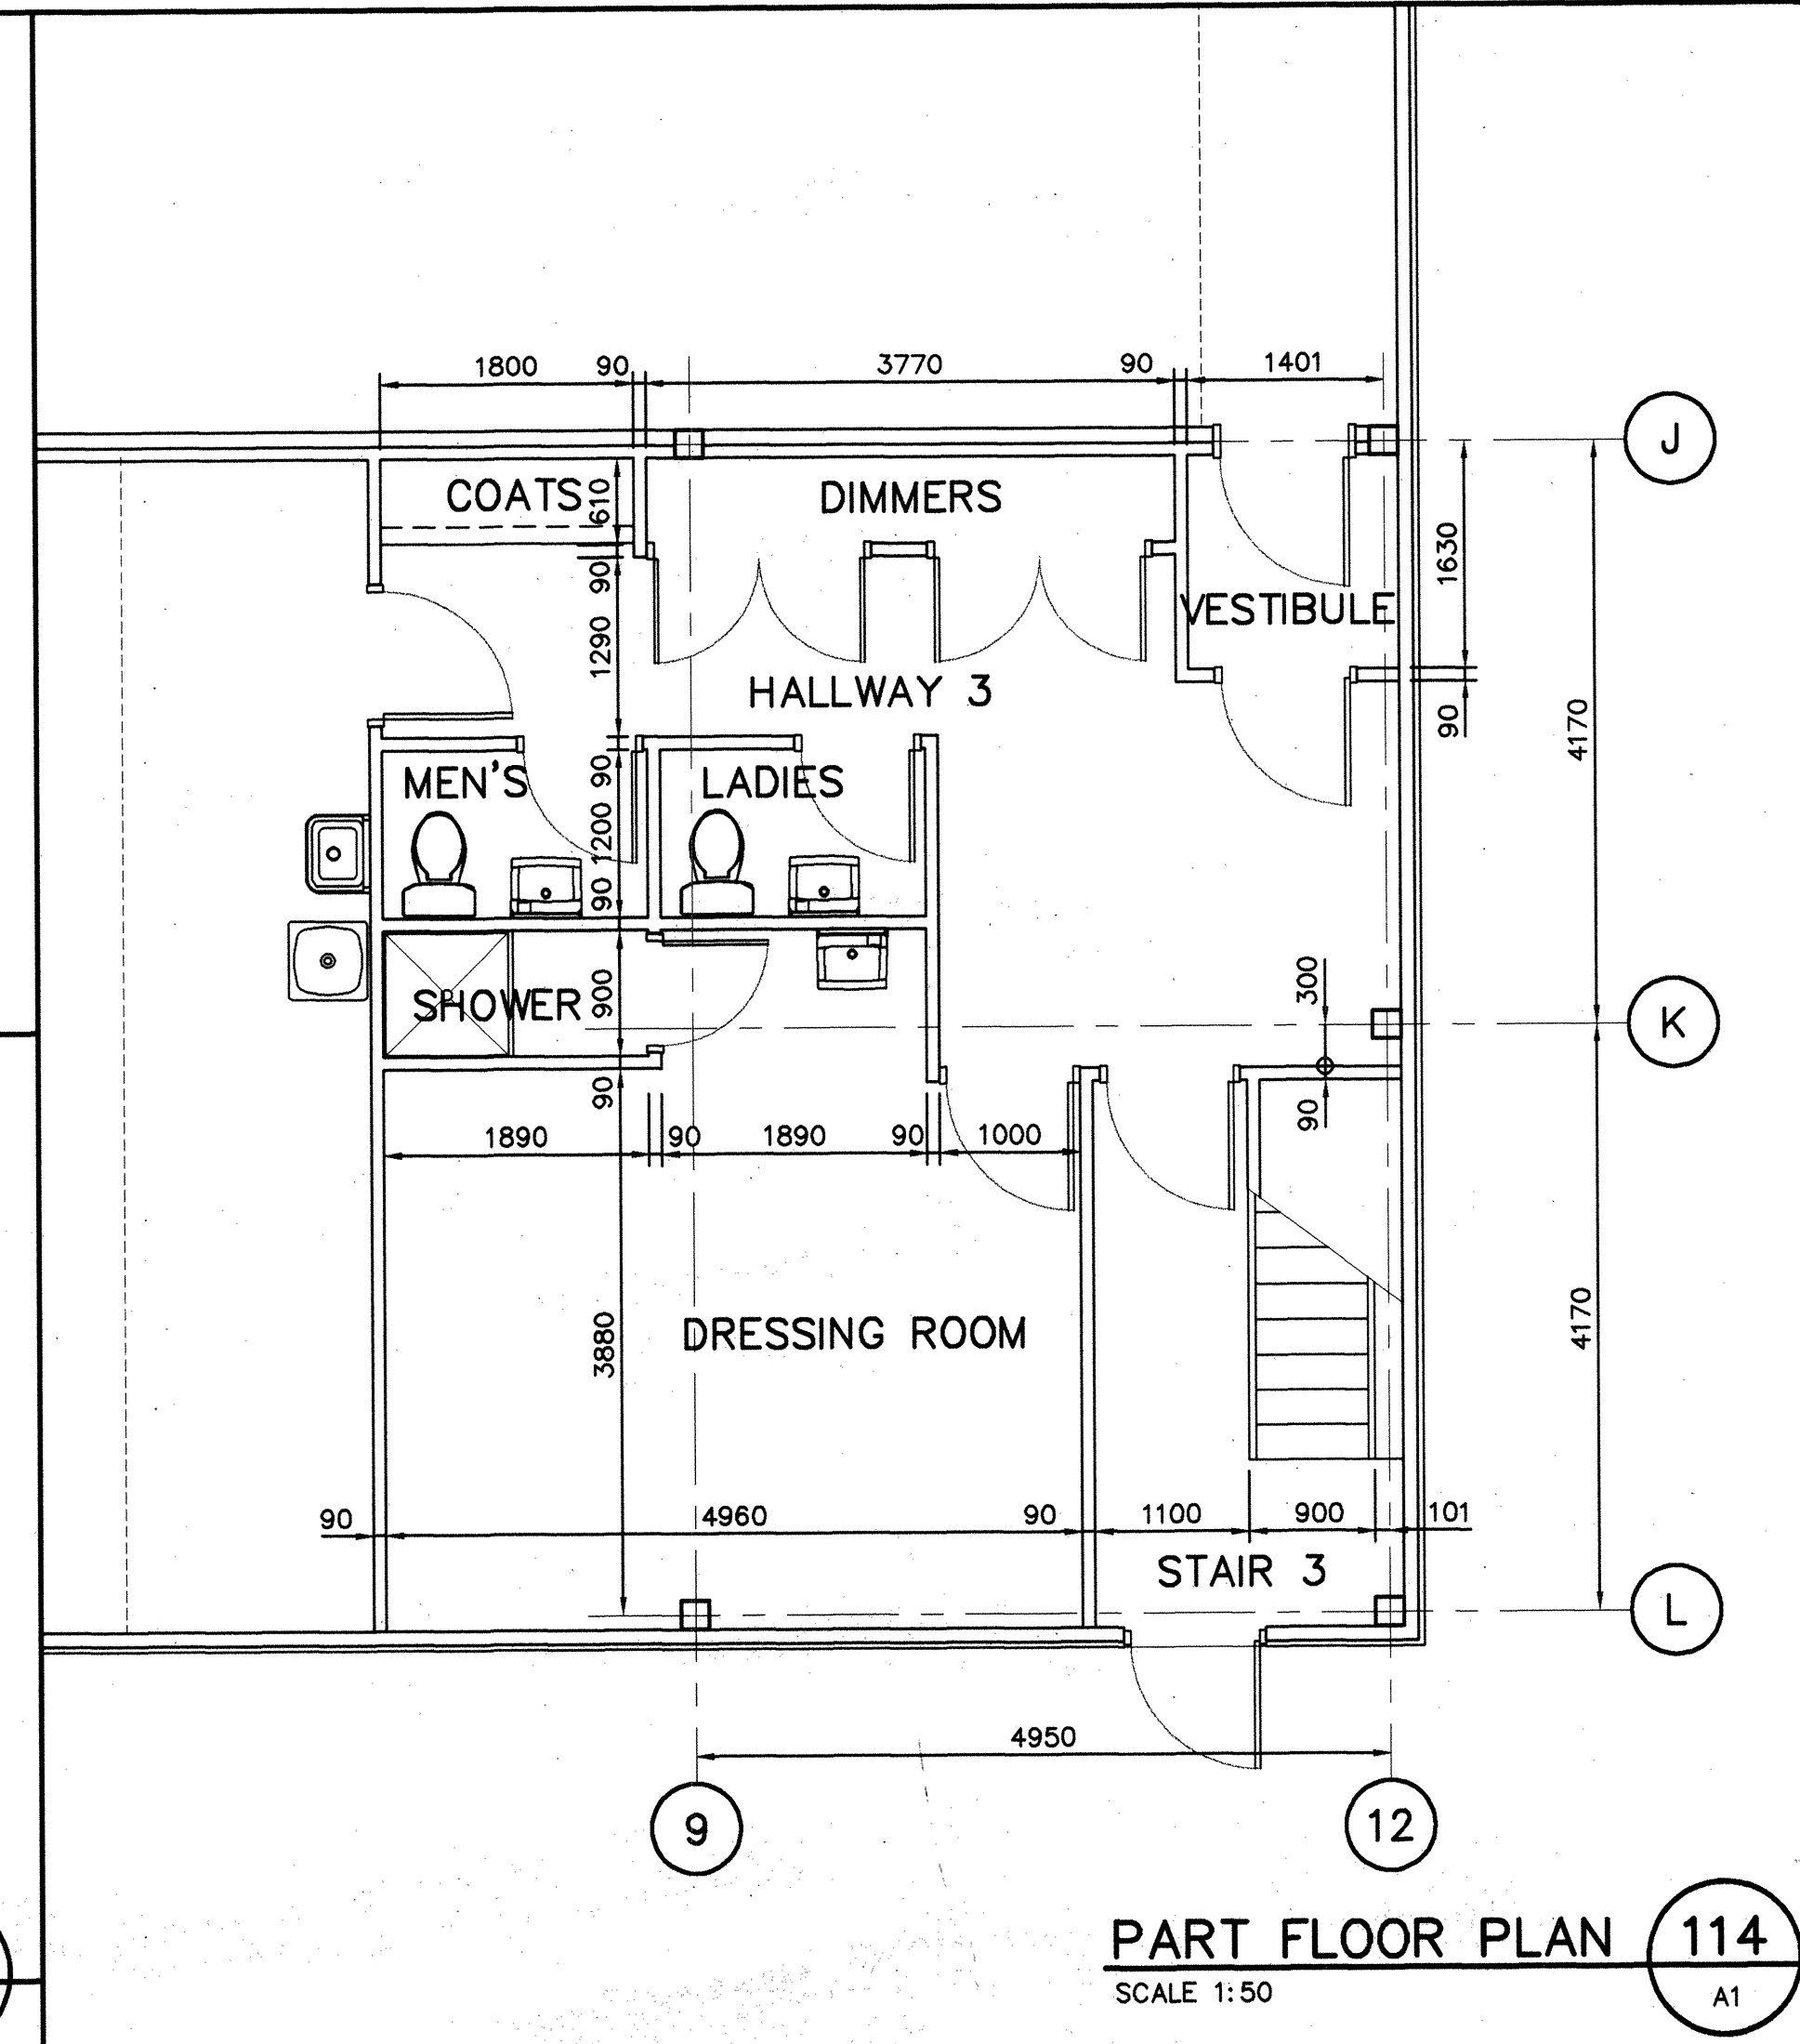
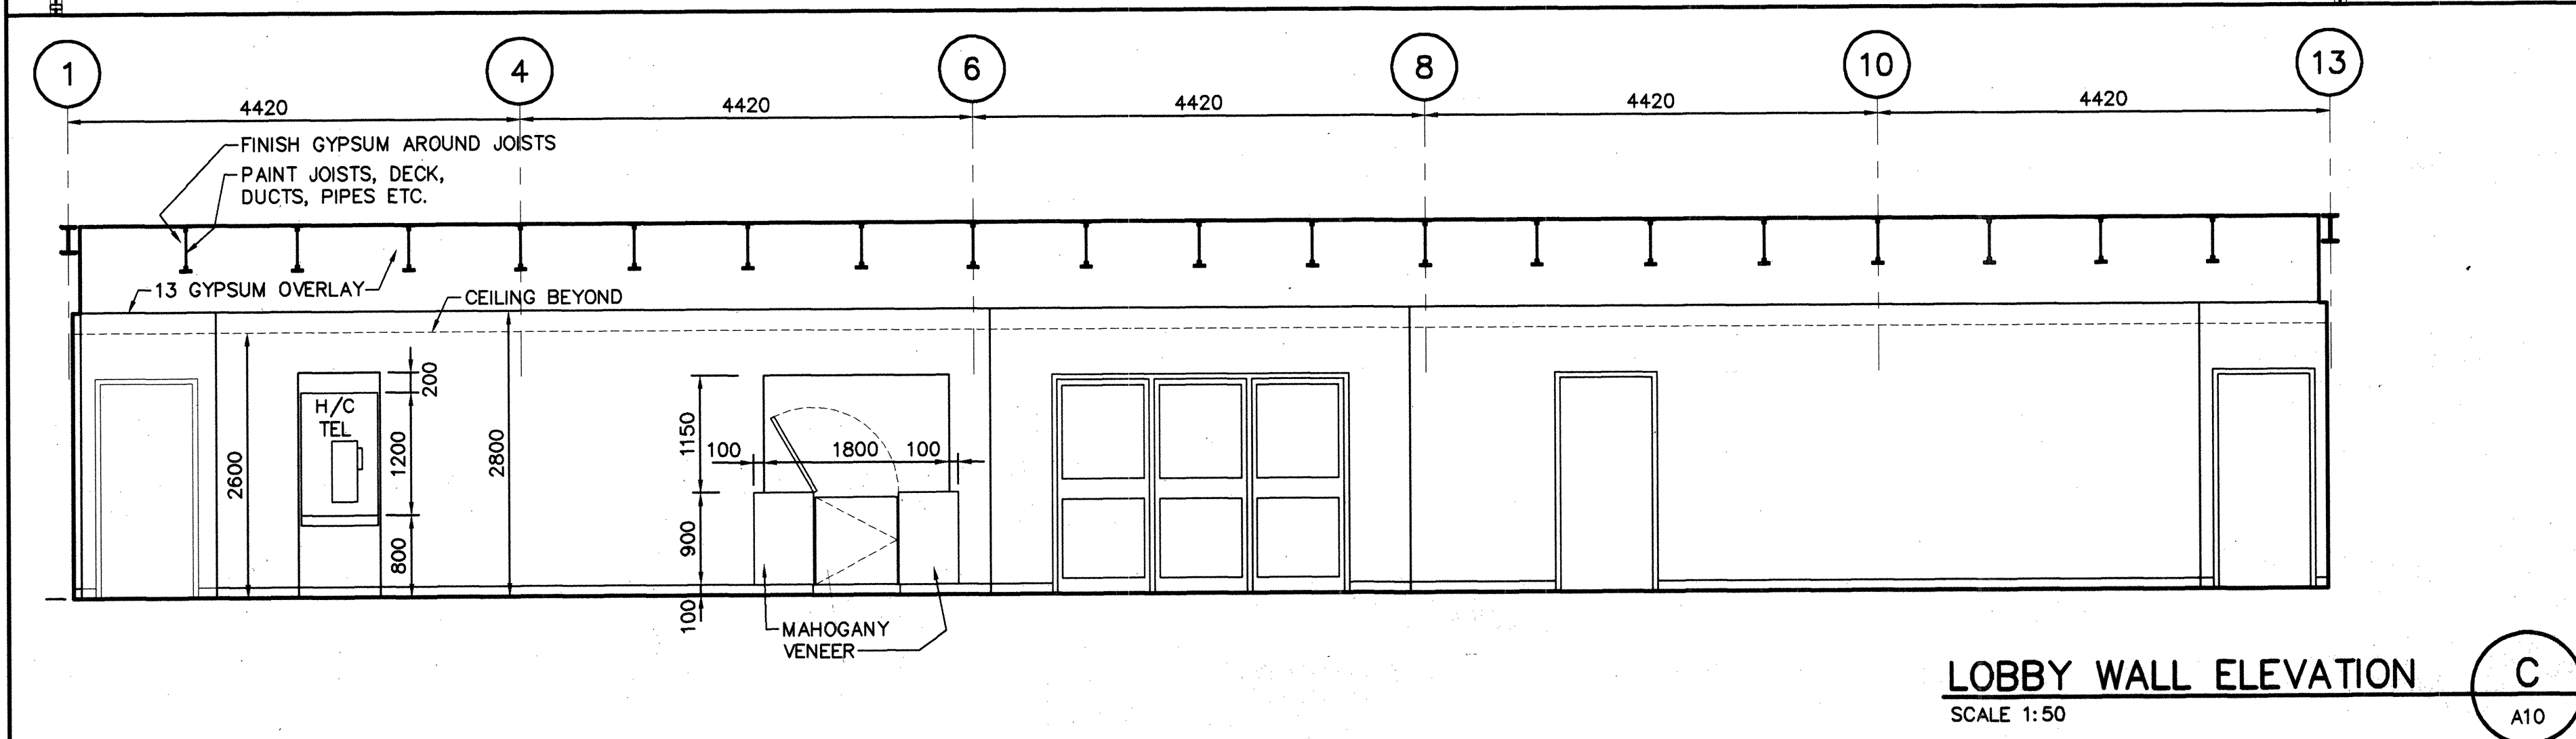


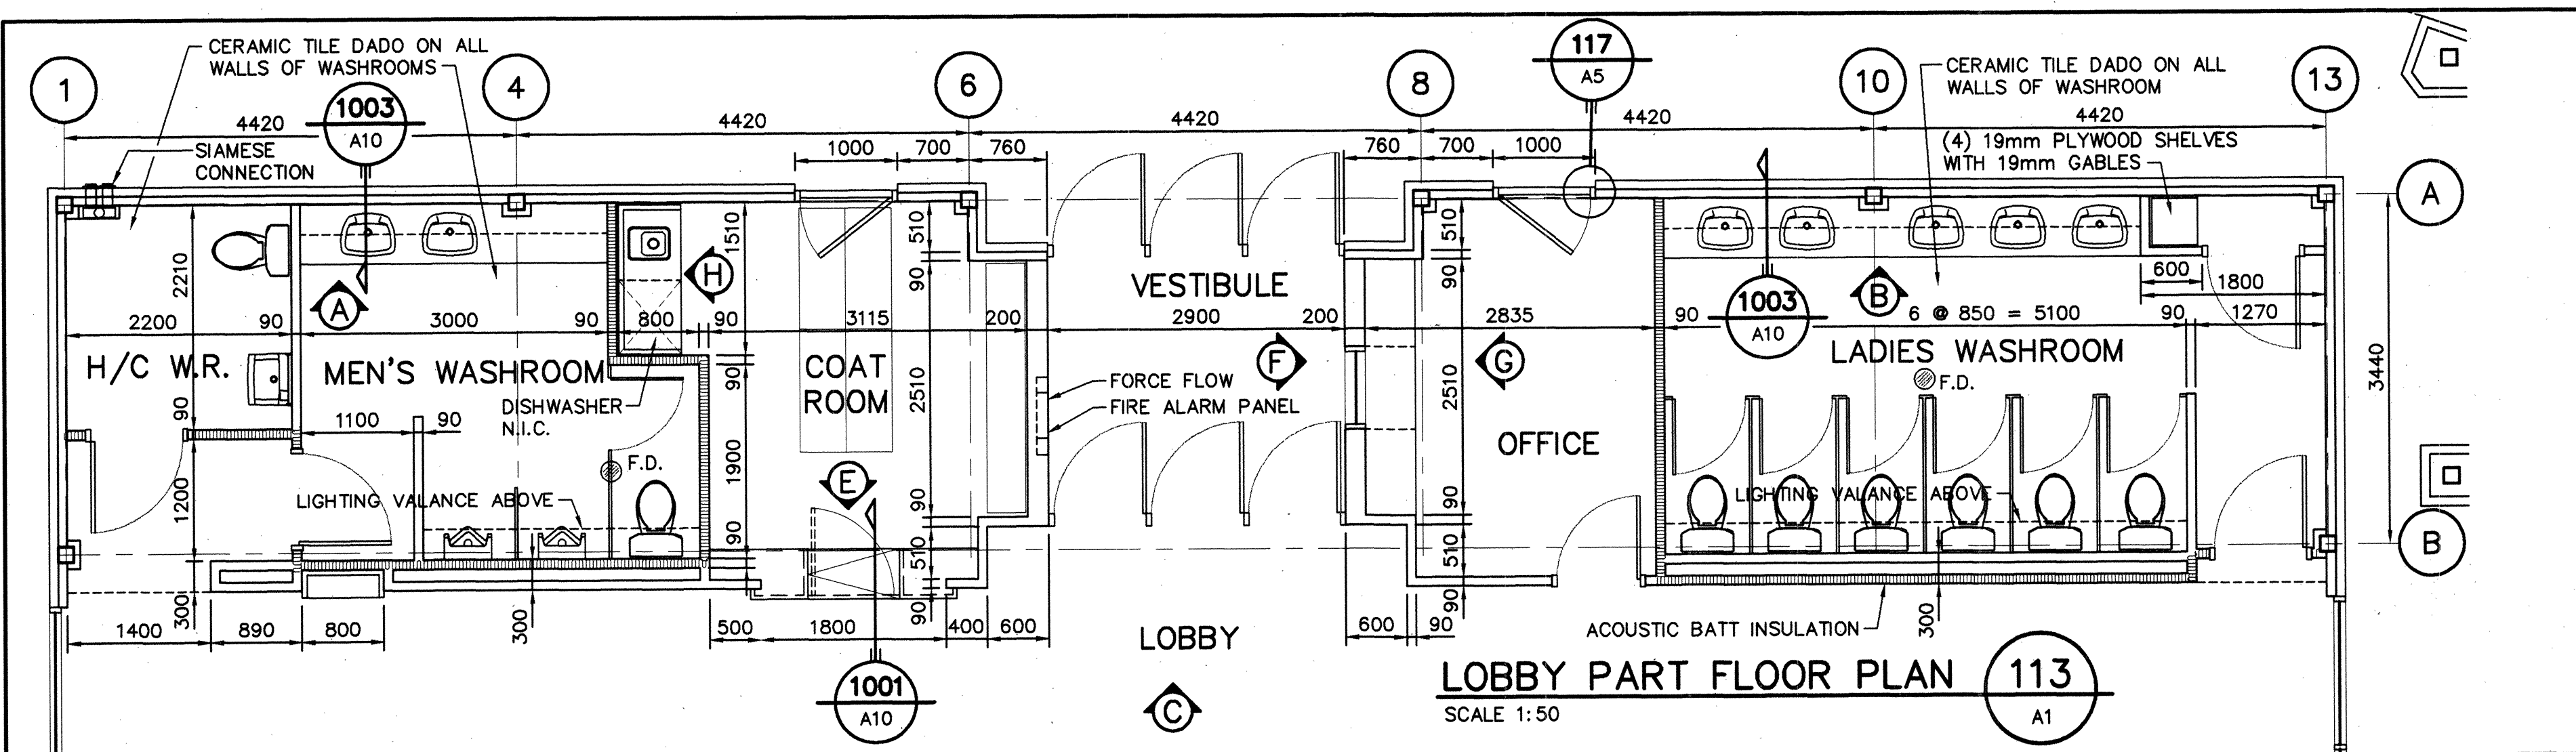

Smartcode
AAB7524

NO.	REVISION	DATE
1	ISSUED FOR TENDER	15/5/95
NO.	ISSUE	DATE

ONARIO ASSOCIATION OF ARCHITECTS
J.L. RICHARDS & ASSOCIATES LIMITED
4194

RECORD DRAWING
PRODUCED FROM INFORMATION PROVIDED BY CONTRACTOR
date: MARCH 1, 1996 Tmc
J.L. RICHARDS & ASSOCIATES LIMITED

J.L. Richards & Associates Limited
Consulting Engineers, Architects & Planners
884 LADY ELLEN PLACE, OTTAWA, CANADA K1Z 5M2

Let/Smith Architects - Design Consultants

PROJECT: **CITY OF KANATA THE RON MASLIN PLAYHOUSE**
Kanata, Ontario

DRAWING: **PART FLOOR PLANS, MILLWORK AND INTERIOR ELEVATIONS**

DESIGN: STH	REVISION NO.:
DRAWN: TM	DRAWING NO.:
CHECKED: STH	A12 of 13
DATE: MAY 1995	JOB NO.:
SCALE: AS NOTED	14456