


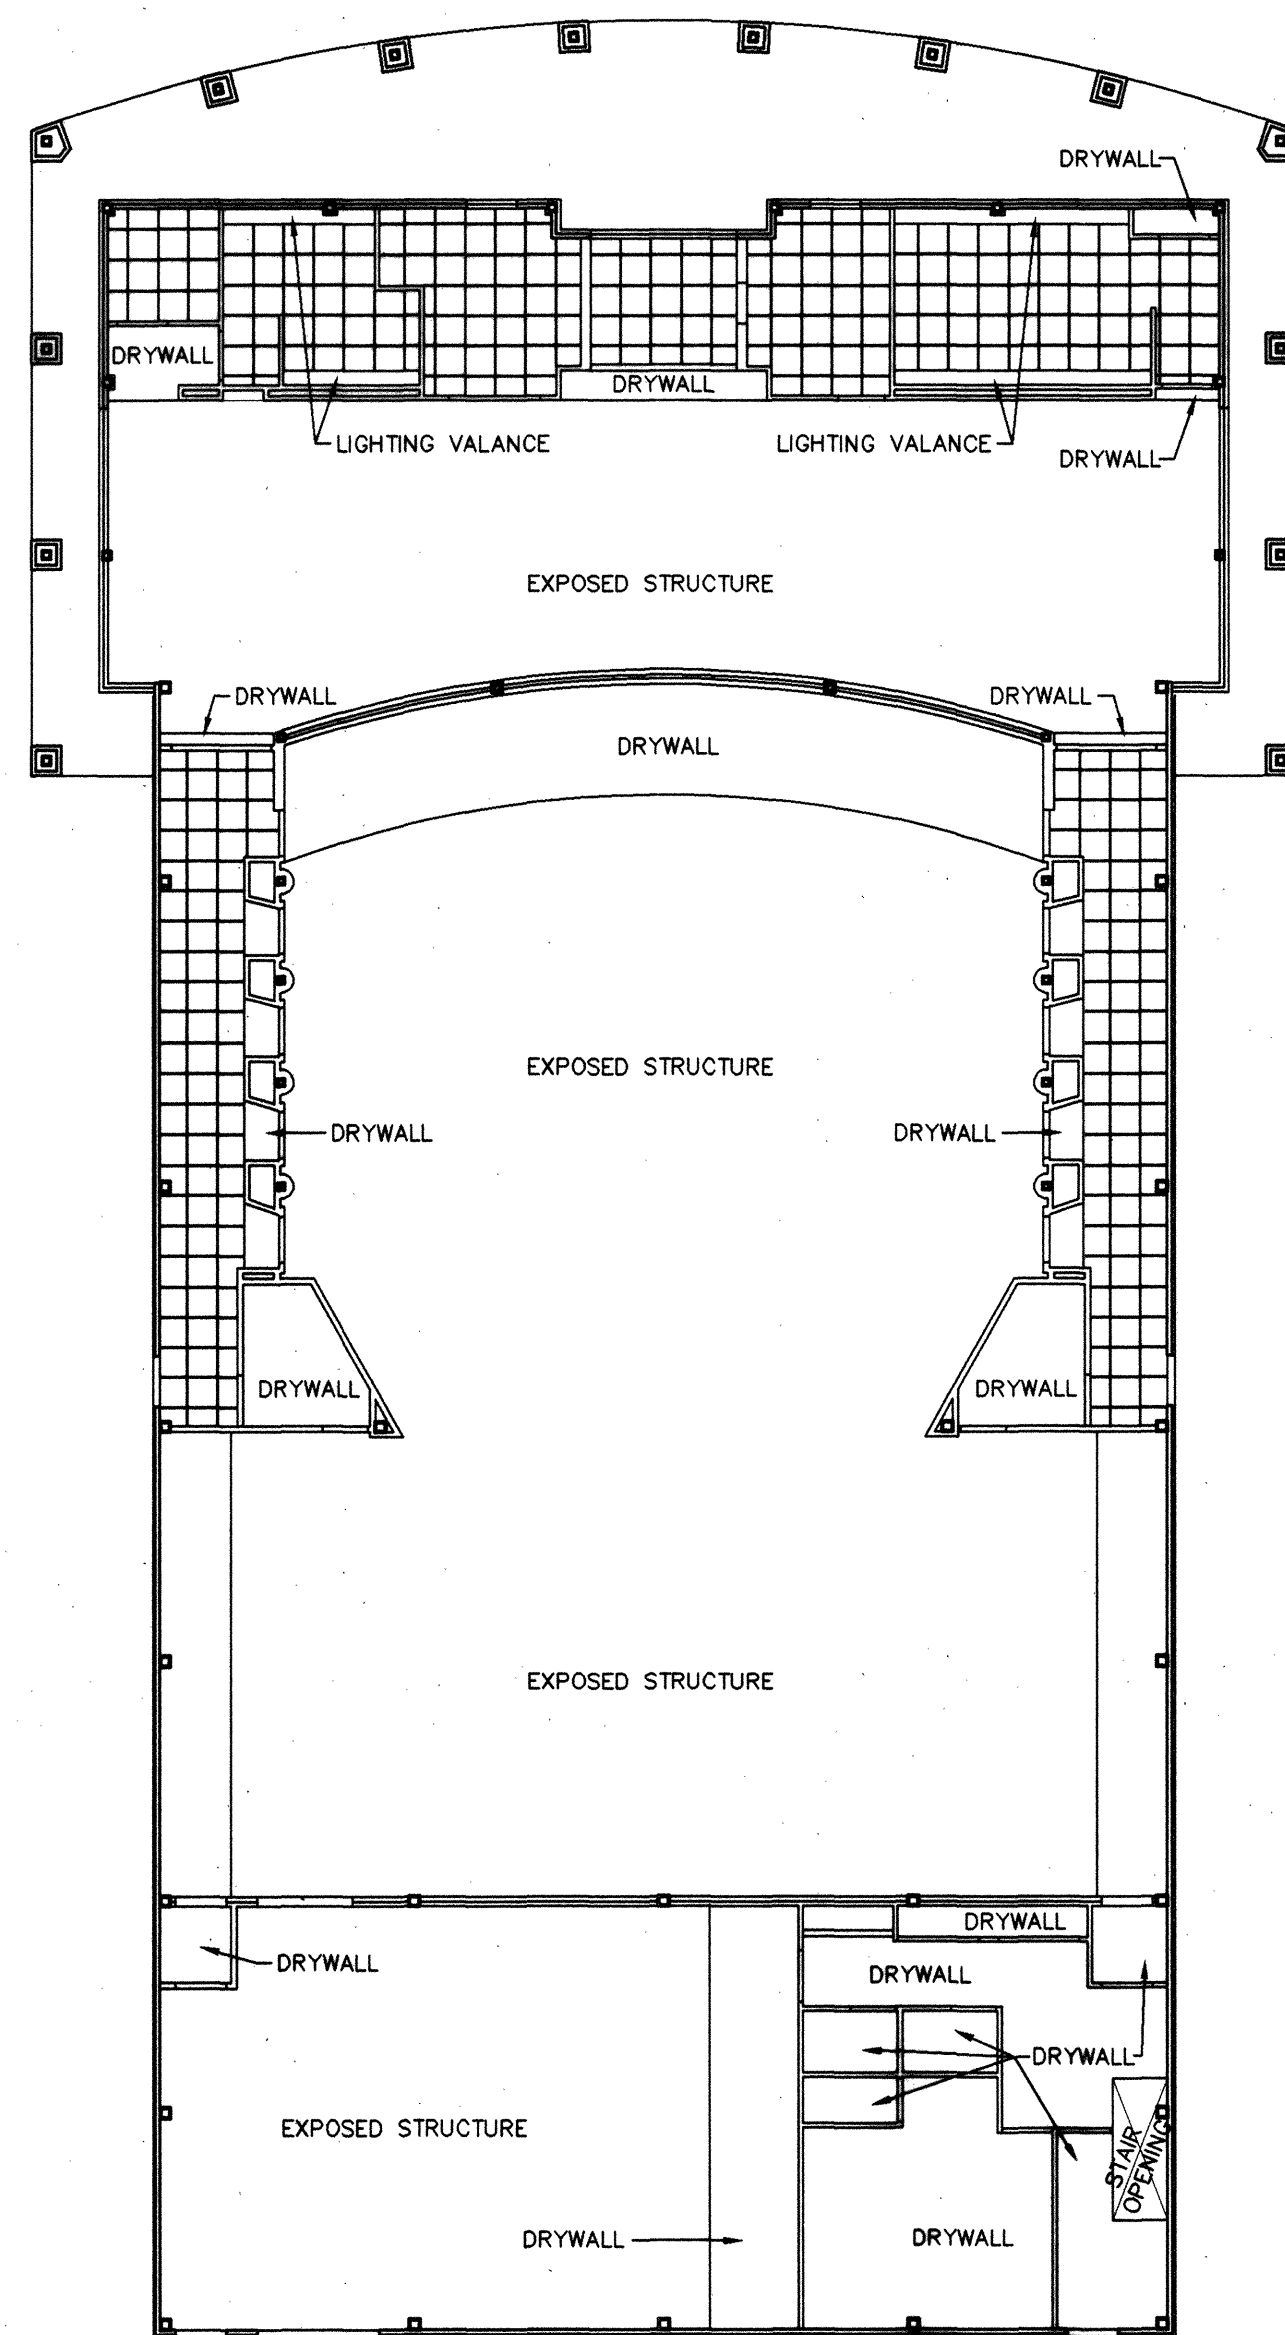


DOOR & FRAME SCHEDULE

DOOR No.	LOCATION	DOOR DETAIL	FRAME DETAIL	REMARKS
FROM ROOM No.	TO ROOM No.	TYPE MATERIAL SIZE	FINISH TYPE MATERIAL ELEV FINISH	
101A	101 108	A SC WOOD 45x900x2100	V 2 PS Q P H4	PAIR OF DOORS
101B	101 109	A SC WOOD 45x900x2100	V 2 PS Q P H4	PAIR OF DOORS
102	101 102	A SC WOOD 45x900x2100	V 1 PS P P H4	HANDICAP OPERATOR
103	101 103	A SC WOOD 45x900x2100	V 1 PS P P H5	
104	104 DISPLAY CASE	A SC WOOD 45x900x1100	P 5 ALUM U F H9	
105A	EXT 105	B ALUM 45x900x2100	F 5 ALUM R F -	HANDICAP OPERATOR
105B	EXT 105	B ALUM 45x900x2100	F 5 ALUM R F -	
105C	EXT 105	B ALUM 45x900x2100	F 5 ALUM R F -	
105D	105 101	B ALUM 45x900x2100	F 5 ALUM R F -	HANDICAP OPERATOR
105E	105 101	B ALUM 45x900x2100	F 5 ALUM R F -	
105F	105 101	B ALUM 45x900x2100	F 5 ALUM R F -	
106A	101 106	D SC WOOD 45x900x2100	V 1 PS P P H10	
106B	106 DISPLAY CASE	A SC WOOD 45x900x1100	P 5 ALUM U F H9	
107A	101 107	A SC WOOD 45x900x2100	V 1 PS P P H5	
107B	107 124	A SC WOOD 45x900x2100	P 1 PS P P H2	
108	108 EXT	A HM 45x900x2100	P 4 PS P P H4	
109	109 EXT	A HM 45x900x2100	P 4 PS P P H4	
110A	110 108	A SC WOOD 45x800x2100	V 6 PS P P H7	FILL FRAME WITH GROUT
110B	110 108	A SC WOOD 45x800x2100	V 6 PS P P H7	FILL FRAME WITH GROUT
110C	110 108	A SC WOOD 45x800x2100	V 6 PS P P H7	FILL FRAME WITH GROUT
110D	110 108	A SC WOOD 45x800x2100	V 6 PS P P H7	FILL FRAME WITH GROUT
110E	110 108	A SC WOOD 45x800x2100	V 6 PS P P H7	FILL FRAME WITH GROUT
110F	110 109	A SC WOOD 45x800x2100	V 6 PS P P H7	FILL FRAME WITH GROUT
110G	110 109	A SC WOOD 45x800x2100	V 6 PS P P H7	FILL FRAME WITH GROUT
110H	110 109	A SC WOOD 45x800x2100	V 6 PS P P H7	FILL FRAME WITH GROUT
110J	110 109	A SC WOOD 45x800x2100	V 6 PS P P H7	FILL FRAME WITH GROUT
110K	110 109	A SC WOOD 45x800x2100	V 6 PS P P H7	FILL FRAME WITH GROUT
111	111 108	A SC WOOD 45x900x2100	V 1 PS P P H3	
112	112 109	A SC WOOD 45x900x2100	V 1 PS P P H3	
113A	113 111	A HM 45x900x2100	P 2 PS P P H5x3/4hr	
113B	113 112	A HM 45x900x2100	P 2 PS P P H5x3/4hr	
113C	113 114	A HM 45x900x2100	P 3 PS P P H13/4hr	
113D	113 115	A HM (2)45x900x3050	P 7 PS P P H8	
113E	113 122	A HM 45x900x2100	P 3 PS P P H13/4hr	
114	114 115	A SC WOOD 45x900x2100	P 1 PS P P H5x	
115A	115 EXT	A HM 45x900x2100	P 4 PS S P H1	GLAZED TRANSOM
115B	115 118	A SC WOOD 45x900x2100	P 2 PS P P H3	
116	118 116	A SC WOOD 45x800x2100	P 1 PS P P H6	
117	118 117	A SC WOOD 45x800x2100	P 1 PS P P H6	
118	118 121	A HM 45x900x2100	P 1 PS P P H53/4hr	
119	120 119	A SC WOOD 45x750x2100	P 1 PS P P H6	
120	118 120	A SC WOOD 45x900x2100	P 1 PS P P H3	
121	121 EXT	A HM 45x900x2100	P 4 PS P P H1	
122	122 118	A SC WOOD 45x900x2100	P 1 PS P P H5x	
123A	123 118	C HM 45x900x2100	P 1 PS P P H12	PAIR OF DOORS
123B	123 118	C HM 45x900x2100	P 1 PS P P H12	PAIR OF DOORS
203	203 202	A SC WOOD 45x900x2100	P 1 PS P P H1	
204A	204 202	A SC WOOD 45x900x2100	P 1 PS P P H1	
204B	204 EXT	A HM (2)45x900x2100	P 4 PS P P H1	2 DOORS, INNER (H12) OUTER (H11)
205	203 205	A SC WOOD 45x900x2100	P 1 PS P P H5	
206	204 206	A SC WOOD 45x900x2100	P 1 PS P P H5	
208A	206 208	A HM 45x900x2100	P 2 PS P P H33/4hr	
208B	208 211	A HM 45x900x2100	P 3 PS P P H13/4hr	
210	210 211	A HM 45x900x2100	P 2 PS P P H13/4hr	
212	205 212	A HM 45x900x2100	P 2 PS P P H33/4hr	


ROOM FINISH SCHEDULE

ROOM NUMBER	ROOM NAME	FLOOR				BASE		WALLS		CEILING		MISC.		REMARKS			
		CONCRETE	POLISHED CONCRETE	CARPET	MASONRY (PAINTED)	RESILIENT TILE	VINYL	VENTED	PAINTED GYPSUM BD	PAINTED METAL LINER SHEET	CERAMIC DADO	ACOUSTIC TILE	PAINTED STRUCTURE & DECK		PAINTED GYPSUM BD	MILLWORK PAINTED	METAL TOILET PARTITIONS
101	LOBBY		●				●		●			●		●	●		
102	H/C WASHROOM		●						●	●		●		●	●		
103	MENS WASHROOM		●							●				●			
104	COAT ROOM		●				●		●			●					
105	VESTIBULE		●				●		●			●		●			
106	OFFICE		●				●		●		●			●	●		
107	WOMENS WASHROOM		●				●					●		●			
108	HALLWAY 1			●			●		●	●			●				
109	HALLWAY 2						●		●			●		●			
110	AUDITORIUM			●			●		●			●	●				U/S TECH GALLERY – PAINTED GYPSUM BD.
111	STAIR 1	●					●		●			●		●			PAINT ALL EXPOSED SURFACES OF STEEL STAIR & RAIL
112	STAIR 2	●					●		●			●		●			PAINT ALL EXPOSED SURFACES OF STEEL STAIR & RAIL
113	STAGE				●			●	●			●					
114	VESTIBULE	●					●		●	●				●			
115	WORKSHOP	●					●		●	●		●					PAINT OVERHEAD DOOR & FRAME INSIDE & OUT
116	MENS WASHROOM					●	●		●				●				
117	WOMENS WASHROOM					●	●		●				●				
118	HALLWAY 3						●	●	●	●			●				
119	SHOWER					●	●		●				●				PREFAB SHOWER COMPARTMENT
120	DRESSING ROOM					●	●		●	●			●				
121	STAIR 3	●					●		●				●				PAINT STEEL RISER, STRINGERS AND RAIL
122	VESTIBULE	●					●		●	●			●				
123	DIMMERS	●					●		●				●				
124	CLOSET	●					●		●				●				
202	CONTROL ROOM			●			●		●	●		●					
203	TECH GALLERY 1	●					●		●	●		●					PAINT COLUMNS & GIRTS, HANDRAIL, LADDER
204	TECH GALLERY 2	●					●		●	●		●					PAINT COLUMNS & GIRTS, HANDRAIL, LADDER
205	STAIR 1	●					●		●	●		●					PAINT EXPOSED SURFACES OF STEEL STAIR AND RAIL
206	STAIR 2	●					●		●	●		●					PAINT EXPOSED SURFACES OF STEEL STAIR AND RAIL
207	UPPER STAGE								●	●		●					
208	FLY GALLERY																PAINT ALL EXPOSED SURFACES OF STEEL DECK & RAIL
210	COSTUME ROOM	●															
211	STAIR 3	●					●		●	●			●				PAINT STEEL RISER, STRINGER AND RAIL
212	FLY GALLERY																PAINT ALL EXPOSED SURFACES OF STEEL DECK & RAIL


WINDOW FRAME ELEVATIONS

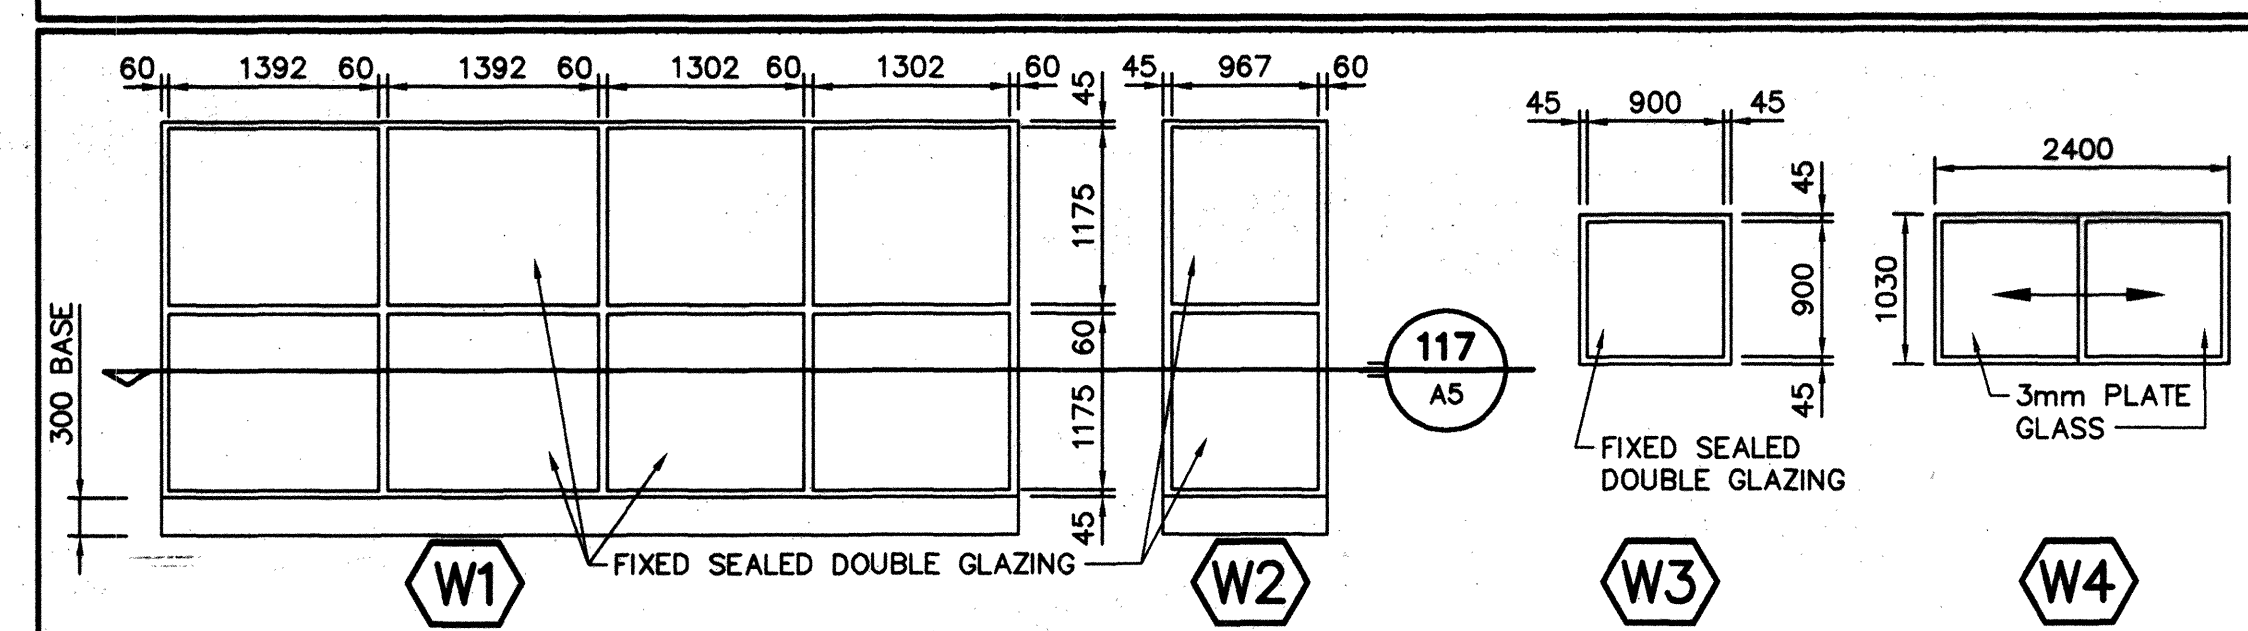


FRAME TYPES

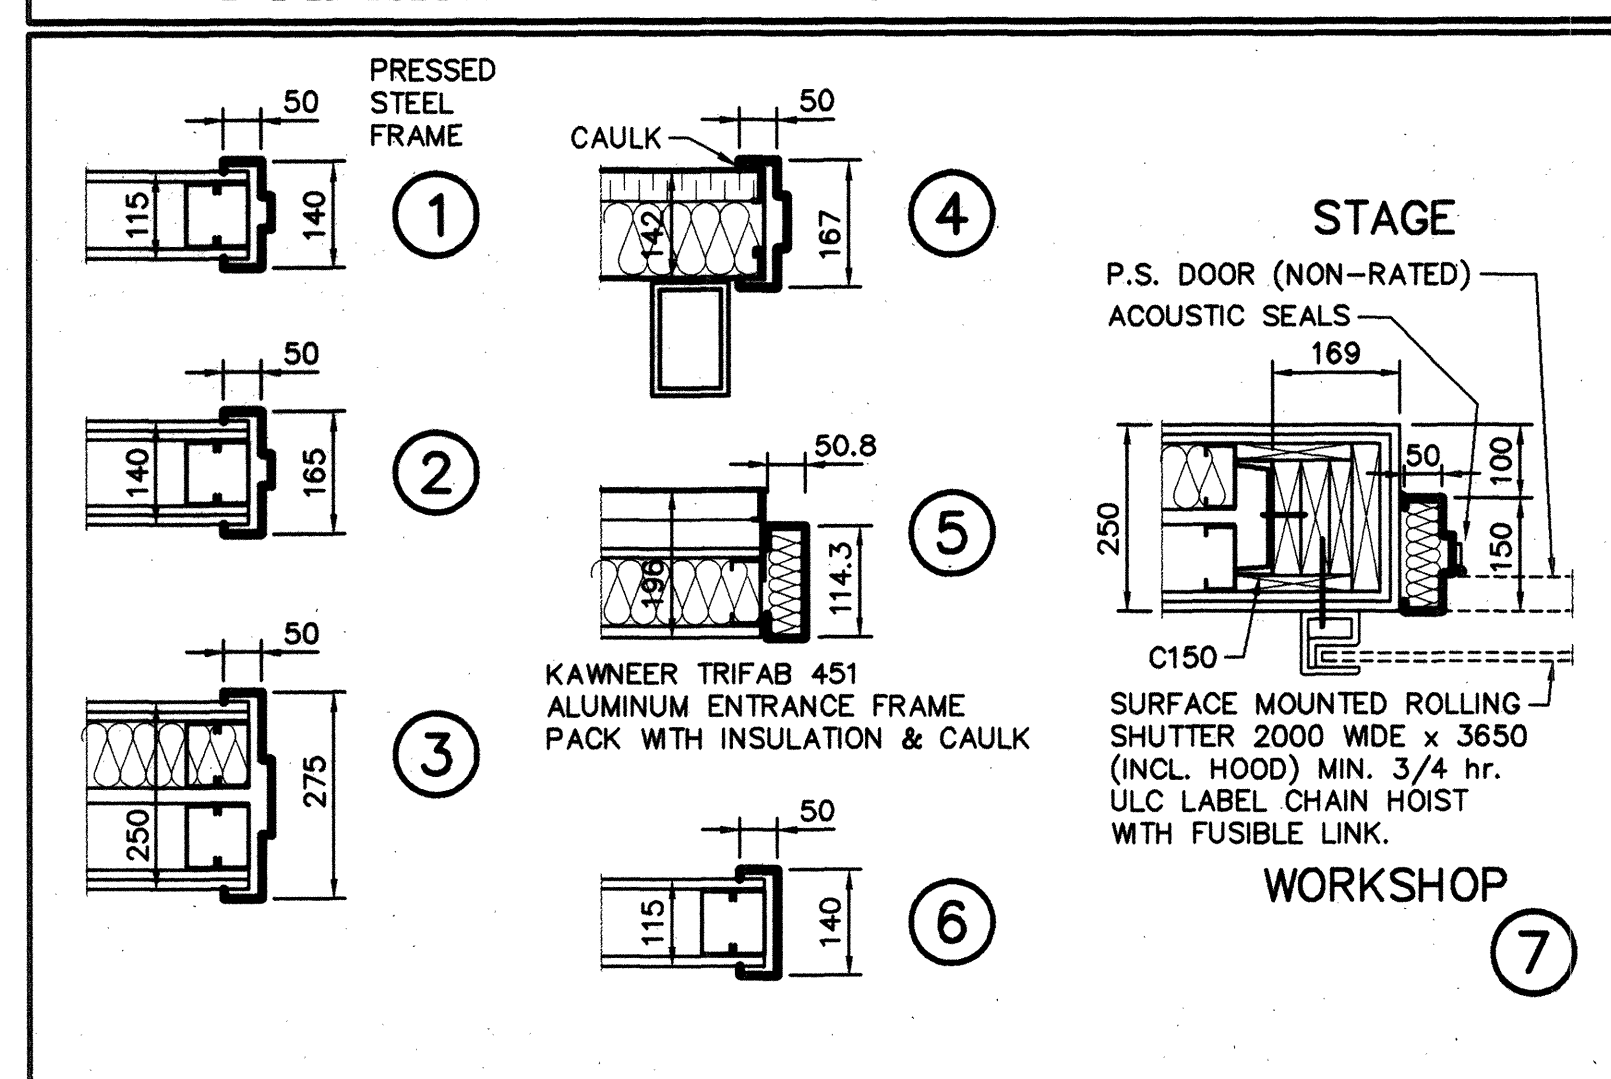

DOOR TYPES

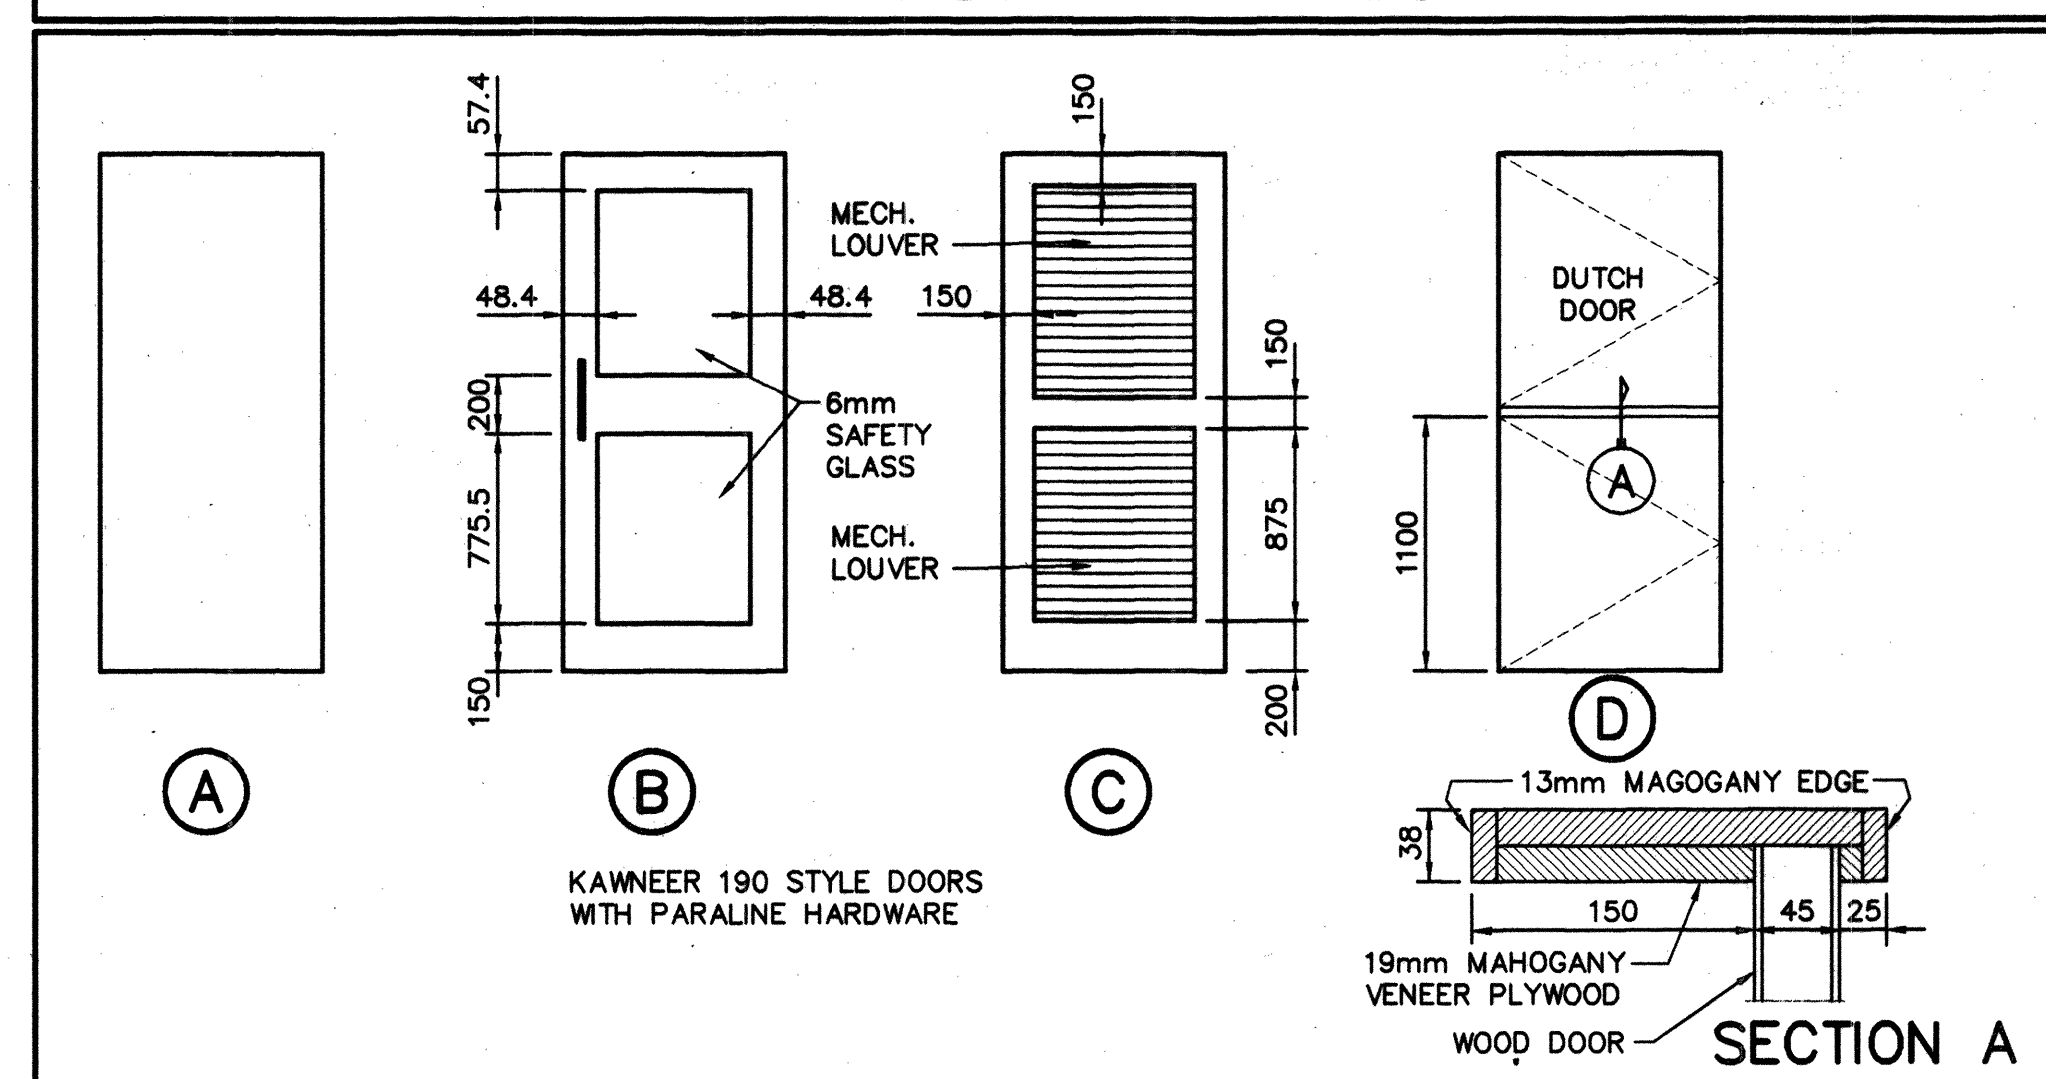

DOOR FRAME ELEVATIONS

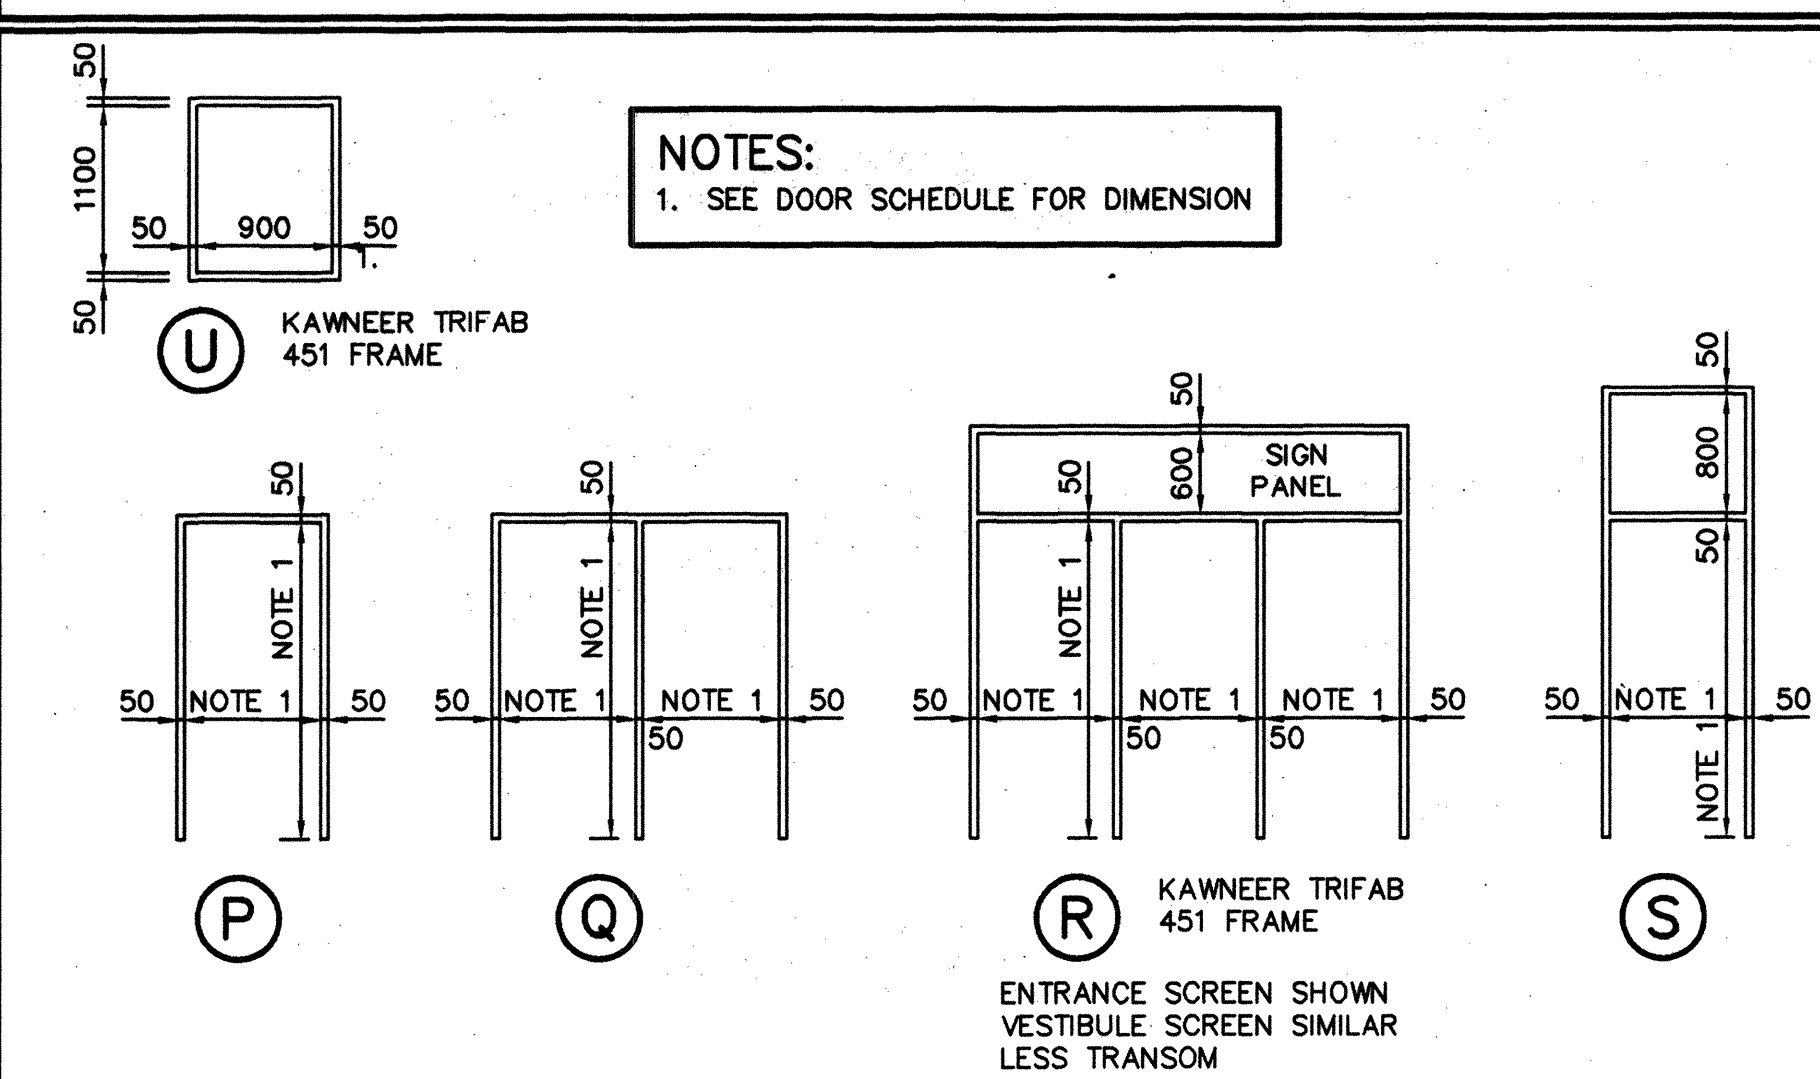


LEGEND

HM HOLLOW METAL
SC WOOD SOLID CORE WOOD
PS PRESSED STEEL
ALUM ALUMINUM
P PAINT
F FACTORY FINISH
V VARNISH FINISH



NO.	REVISION	DATE
1	ISSUED FOR TENDER	15/5/95
NO.	ISSUE	DATE

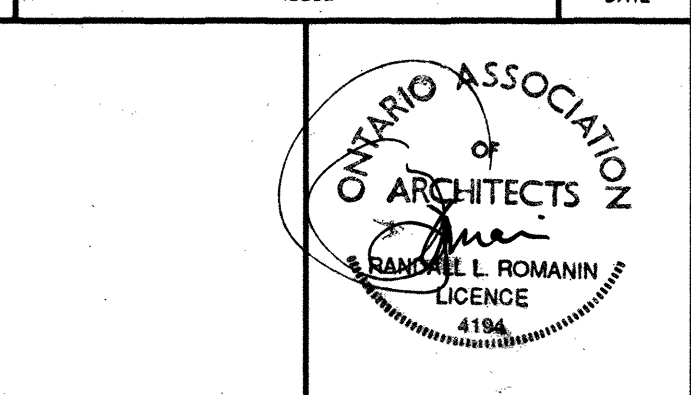

RECORD DRAWING
PRODUCED FROM INFORMATION PROVIDED BY CONTRACTOR
date: MARCH 1, 1996 TMC
J.L. RICHARDS & ASSOCIATES LIMITED

J.L. Richards & Associates Limited
Consulting Engineers, Architects & Planners
884 LADY ELLER PLACE, OTTAWA, CANADA K1Z 5M2
Lett/Smith Architects - Design Consultants

PROJECT: CITY OF KANATA
THE RON MASLIN PLAYHOUSE
Kanata, Ontario

SCHEDULES AND REFLECTED CEILING PLAN

DESIGN: STH	REVISION NO.:
DRAWN: TM	DRAWING NO.:
CHECKED: STH	DATE: MAY 1995
SCALE: NTS	JOB NO.: 14456