




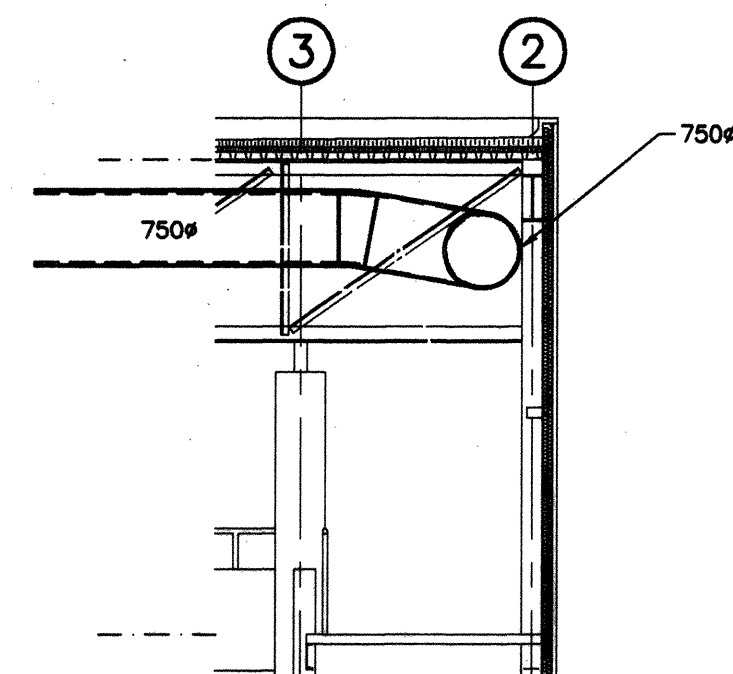

3 SECTION
M3

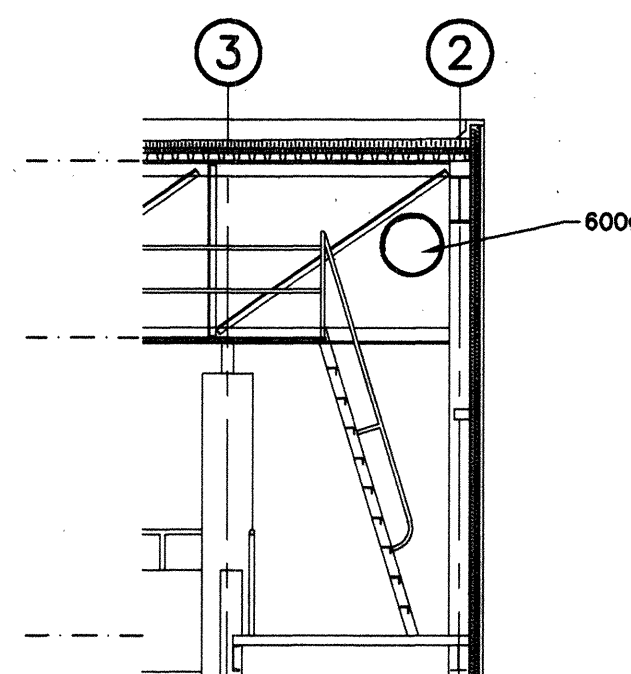

4 SECTION
M3

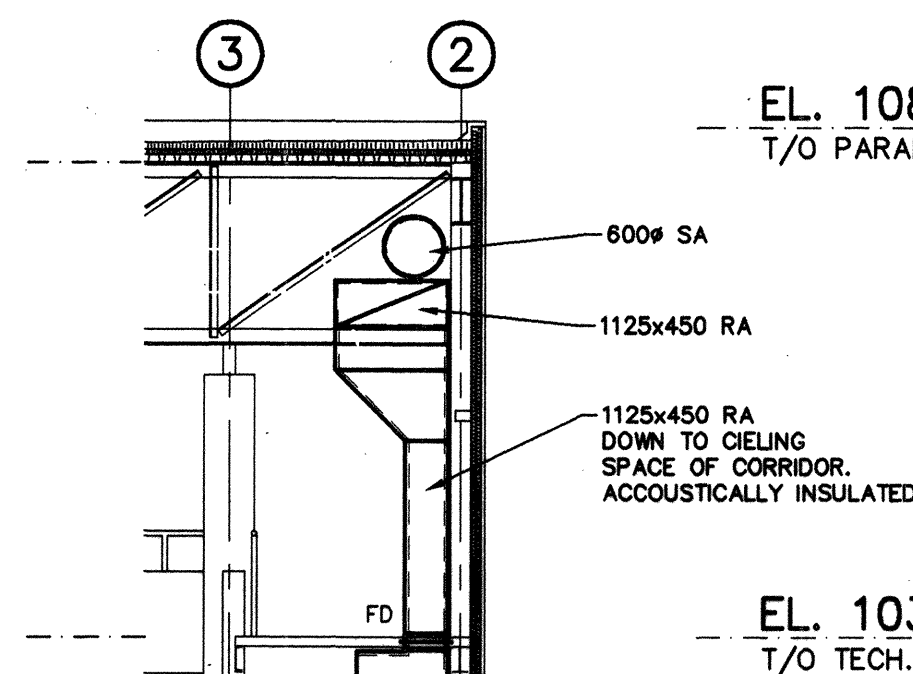


5 SECTION
M3


EL. 108.50
T/O PARAPET

EL. 103.45
T/O TECH. GALLERY SLAB


EL. 100.40
T/O FLOOR SLAB

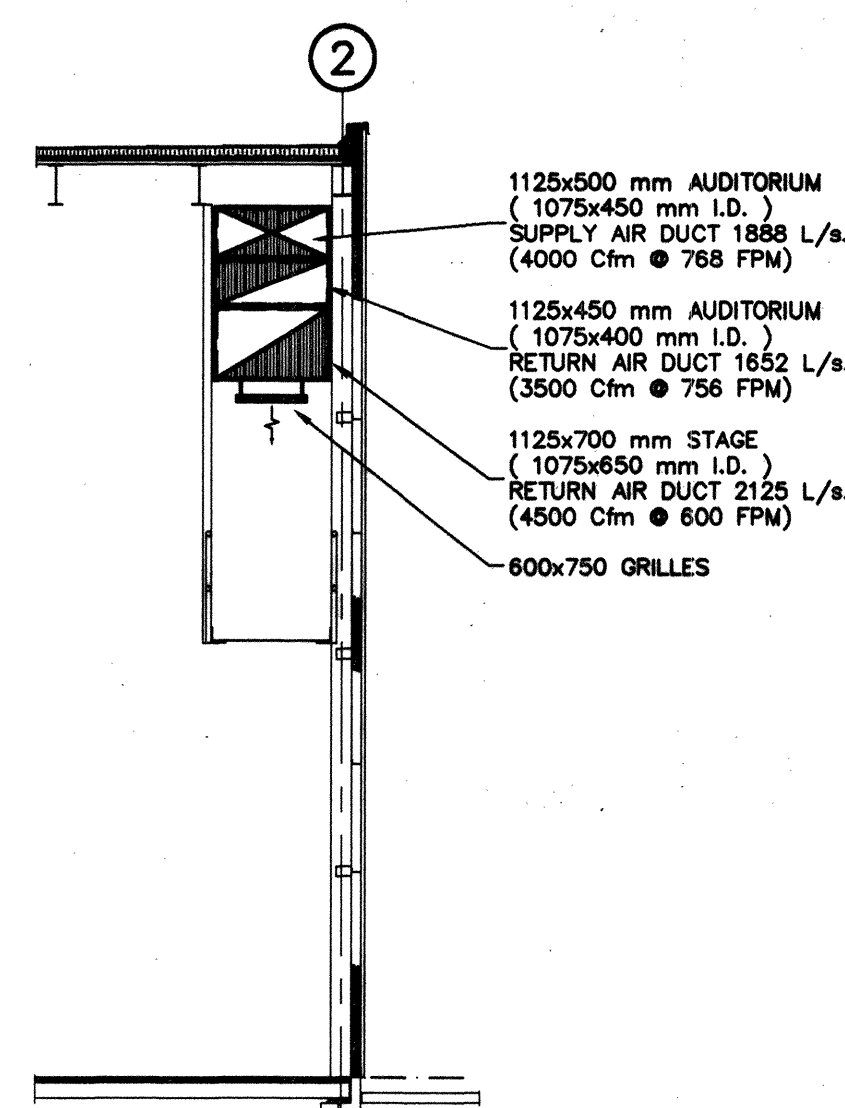



6 SECTION
M3

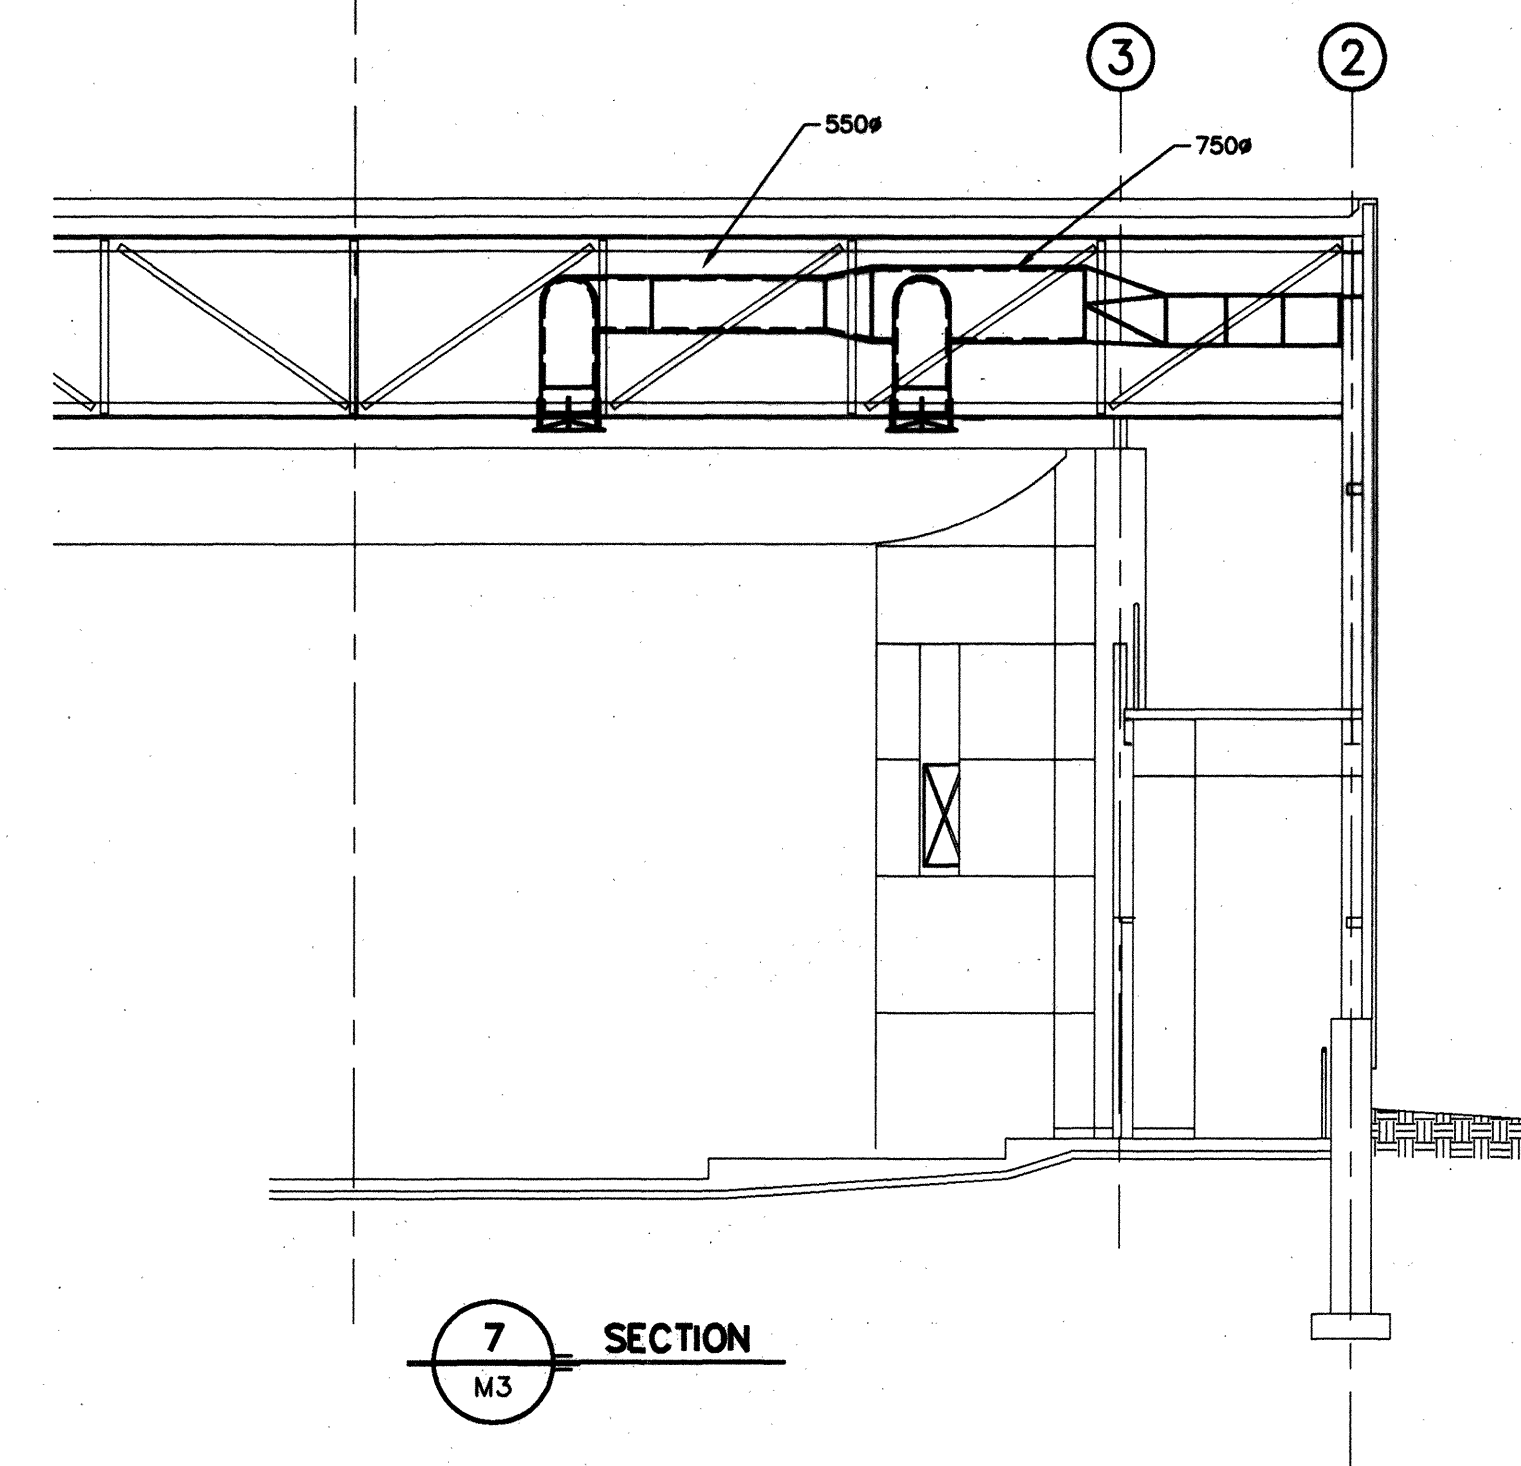

7 SECTION
M3

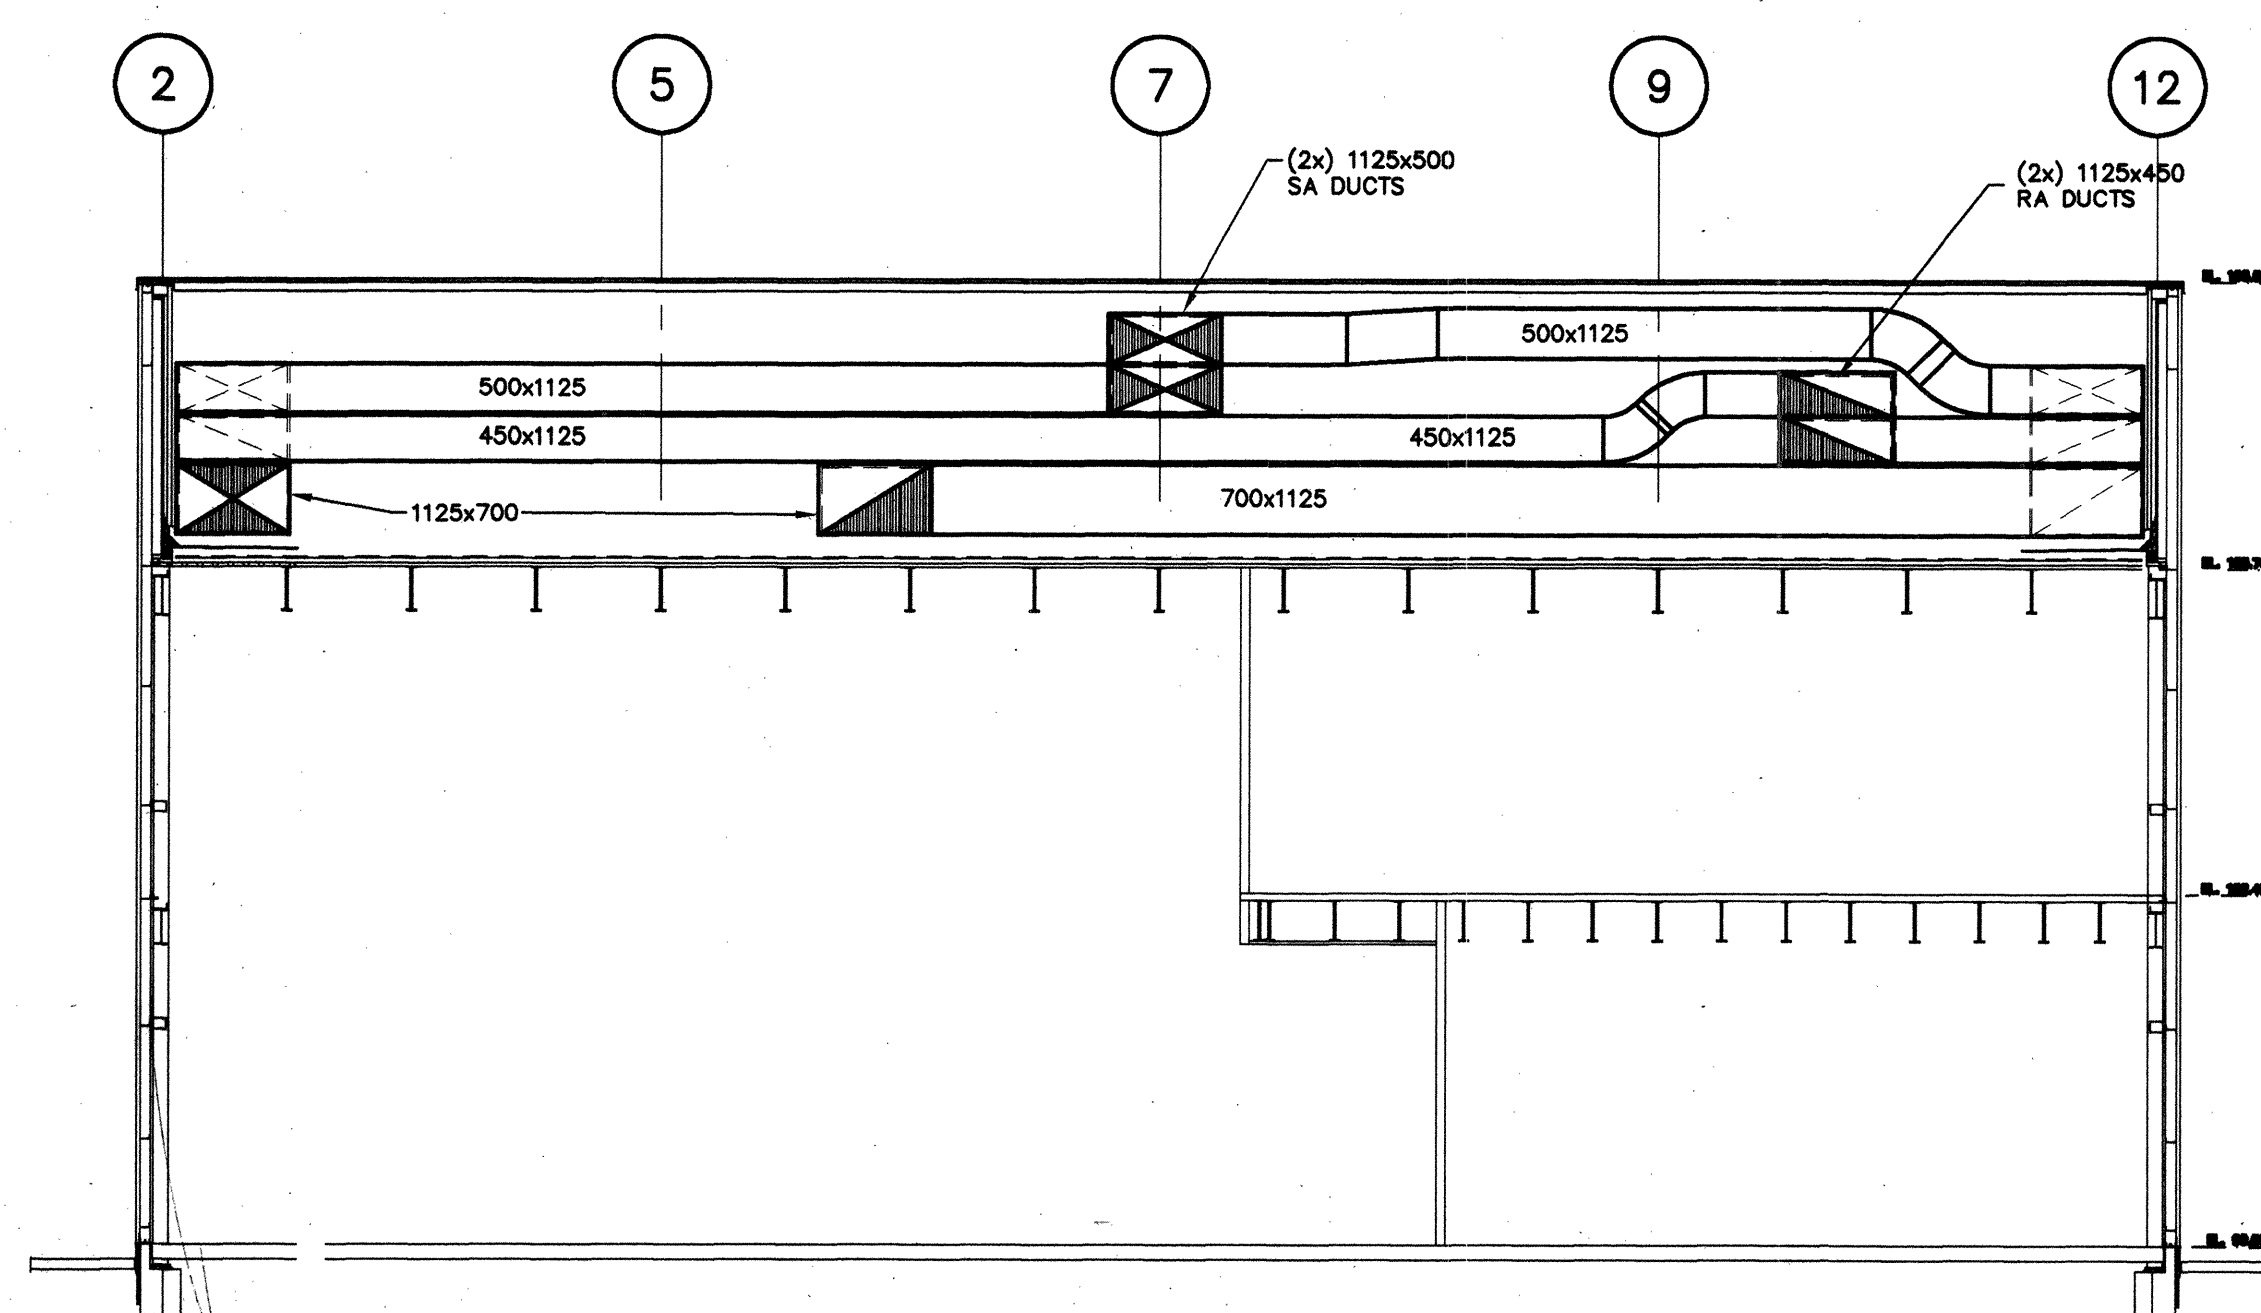


2 SECTION
M1

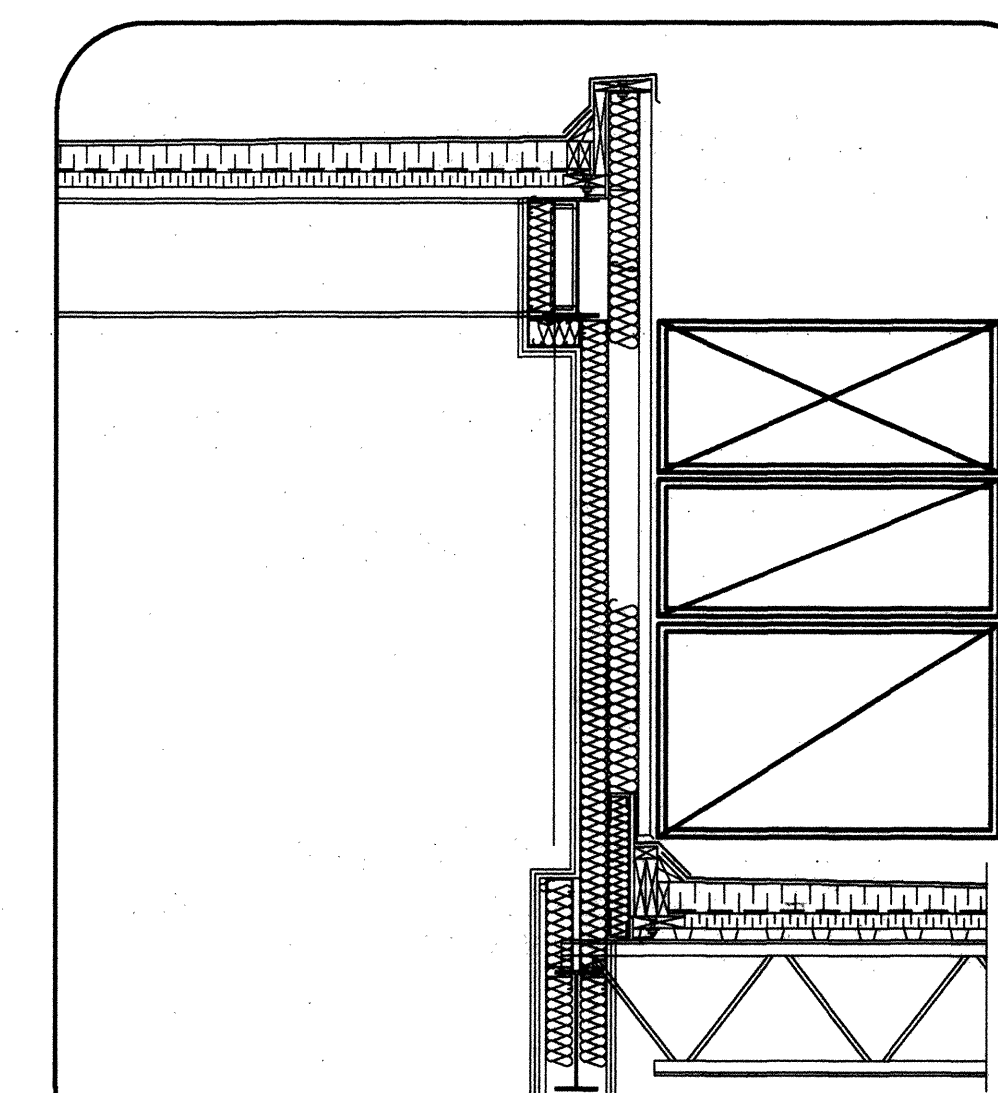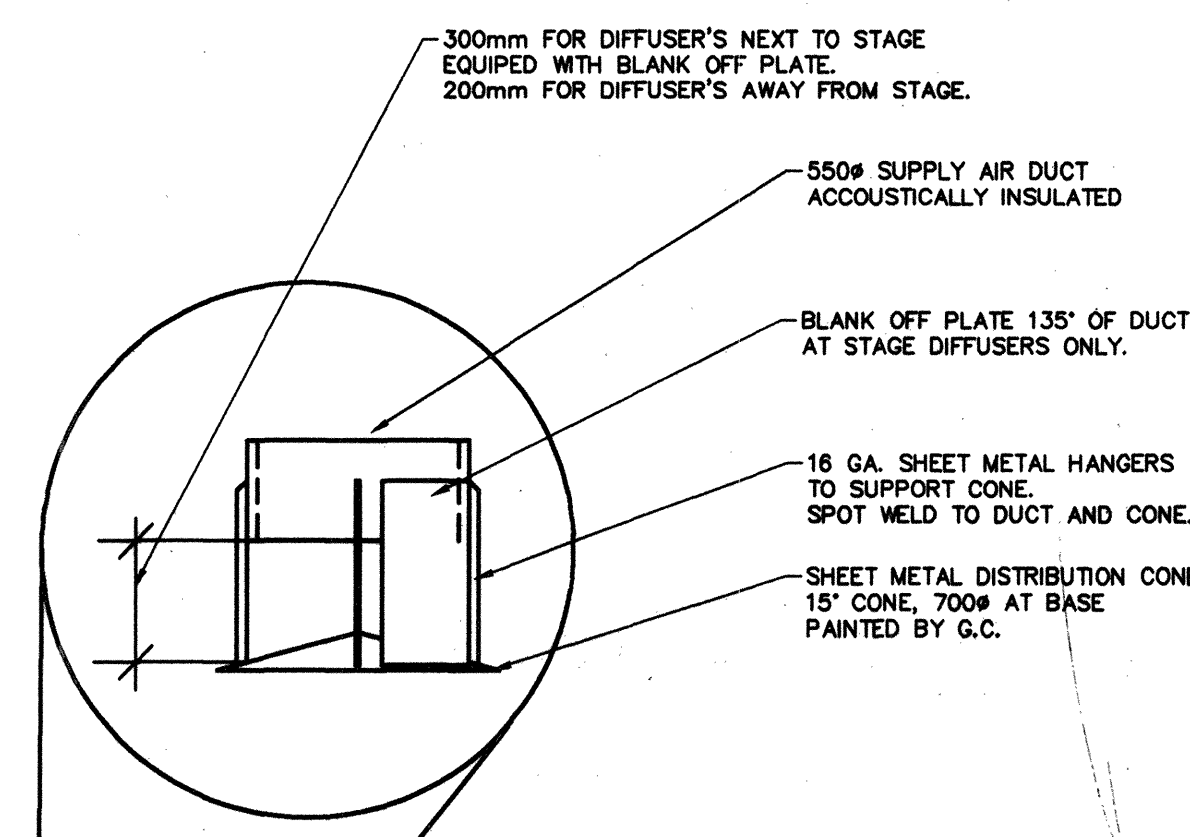

EL. 104.45
T/O PARAPET

EL. 103.20
U/S CANOPY

EL. 100.40
T/O LOBBY FL. SLAB

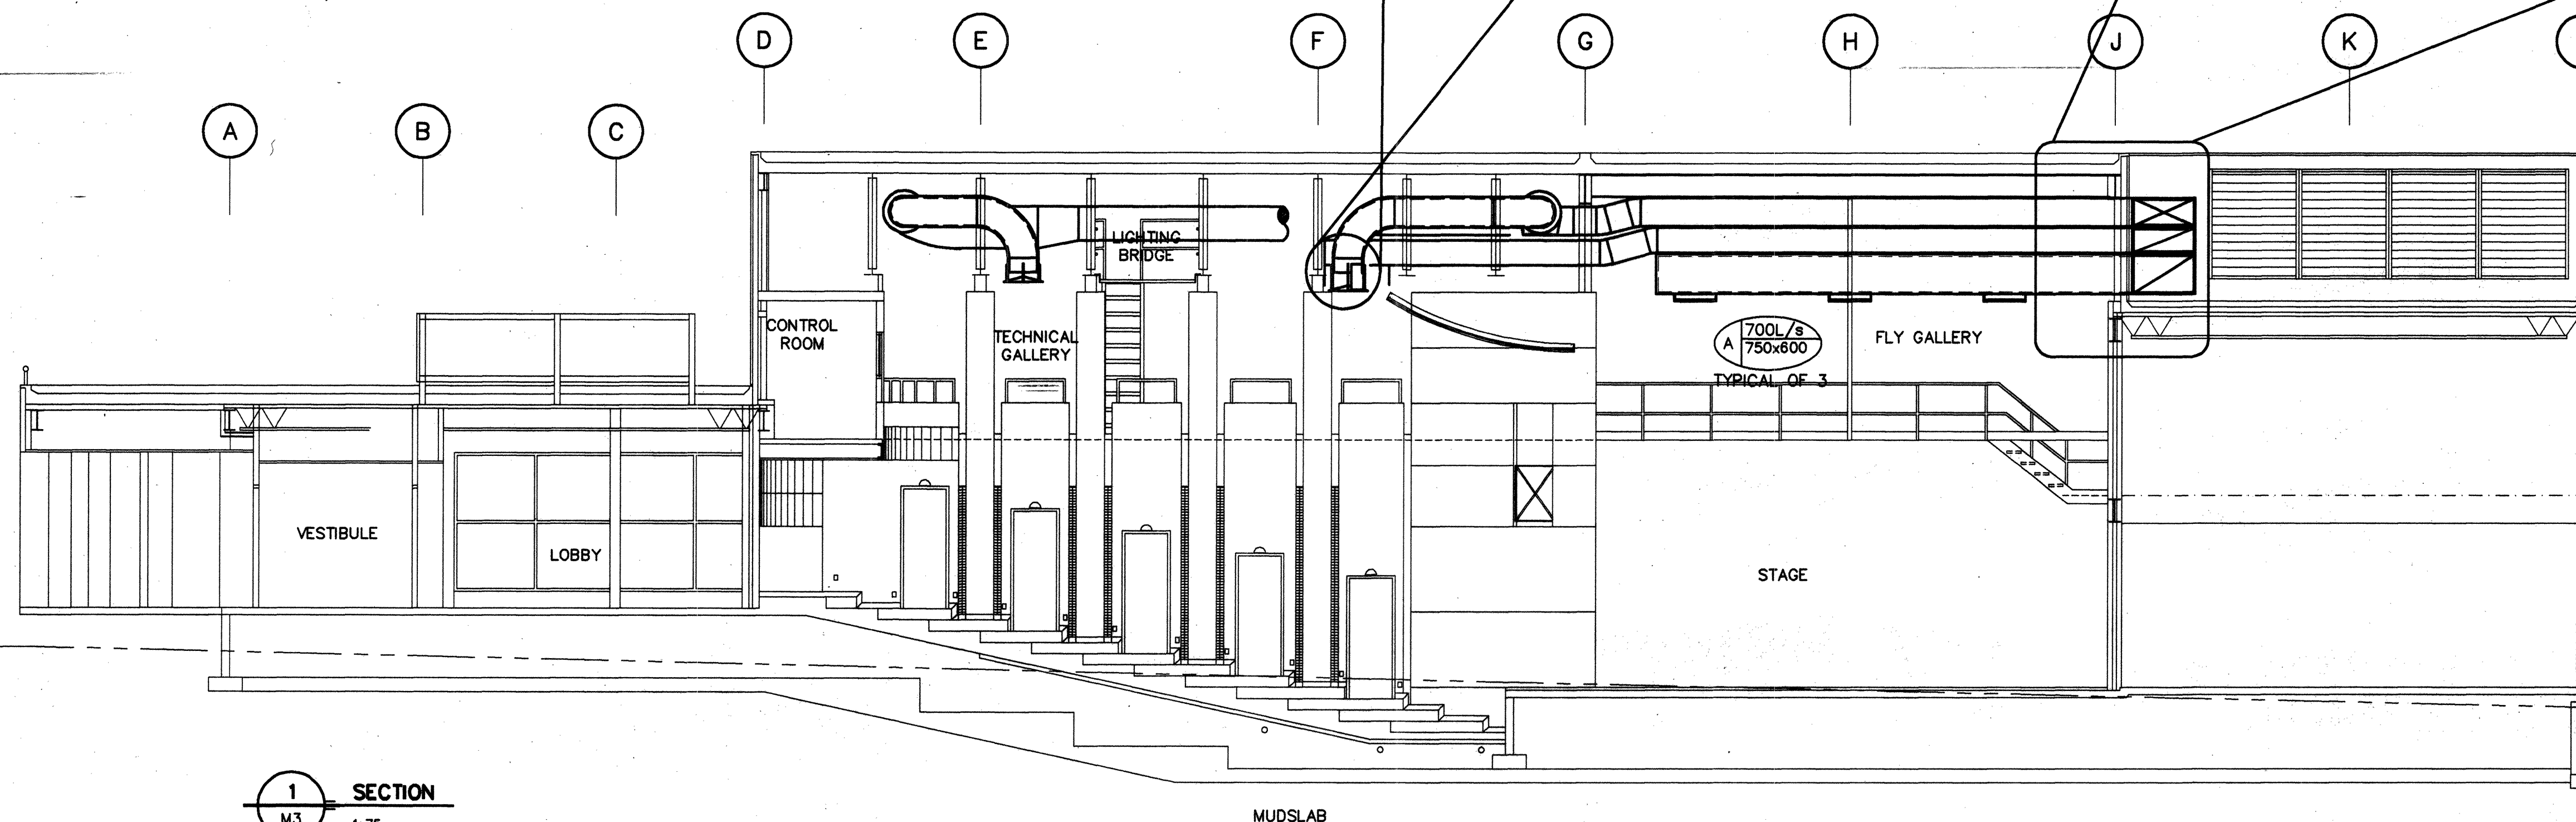

1 SECTION
M3
1:75

EL. 108.50
T/O PARAPET

EL. 103.45
T/O TECH. GALLERY SLAB

EL. 102.45
T/O SECOND FLOOR SLAB

EL. 99.00
T/O FLOOR SLAB

APPROX. EXISTING GRADE

RECORD DRAWING

PRODUCED FROM INFORMATION PROVIDED BY
CONTRACTOR. DRAWINGS ARE DIAGRAMATIC.
FIELD VERIFICATION IS REQUIRED.

date: MAR, 01, 96 P.G.

J.L. RICHARDS & ASSOCIATES LIMITED

NO.	REVISION	DATE
1	ISSUED FOR TENDER	15/5/95
NO.	ISSUE	DATE

J.L. Richards & Associates Limited
Consulting Engineers, Architects & Planners
864 LADY ELLEN PLACE, OTTAWA, CANADA K1Z 5M2
Lett/Smith Architects - Design Consultants

PROJECT: CITY OF KANATA
THE
RON MASLIN
PLAYHOUSE
Kanata, Ontario

DRAWING: MECHANICAL
SECTIONS

DESIGN: R. SNOW	REVISION NO.:
DRAWN:	DRAWING NO.:
CHECKED: R. SNOW	M4 of 5
DATE: MAY 1995	JOB NO.: 14456
SCALE: 1:100	

