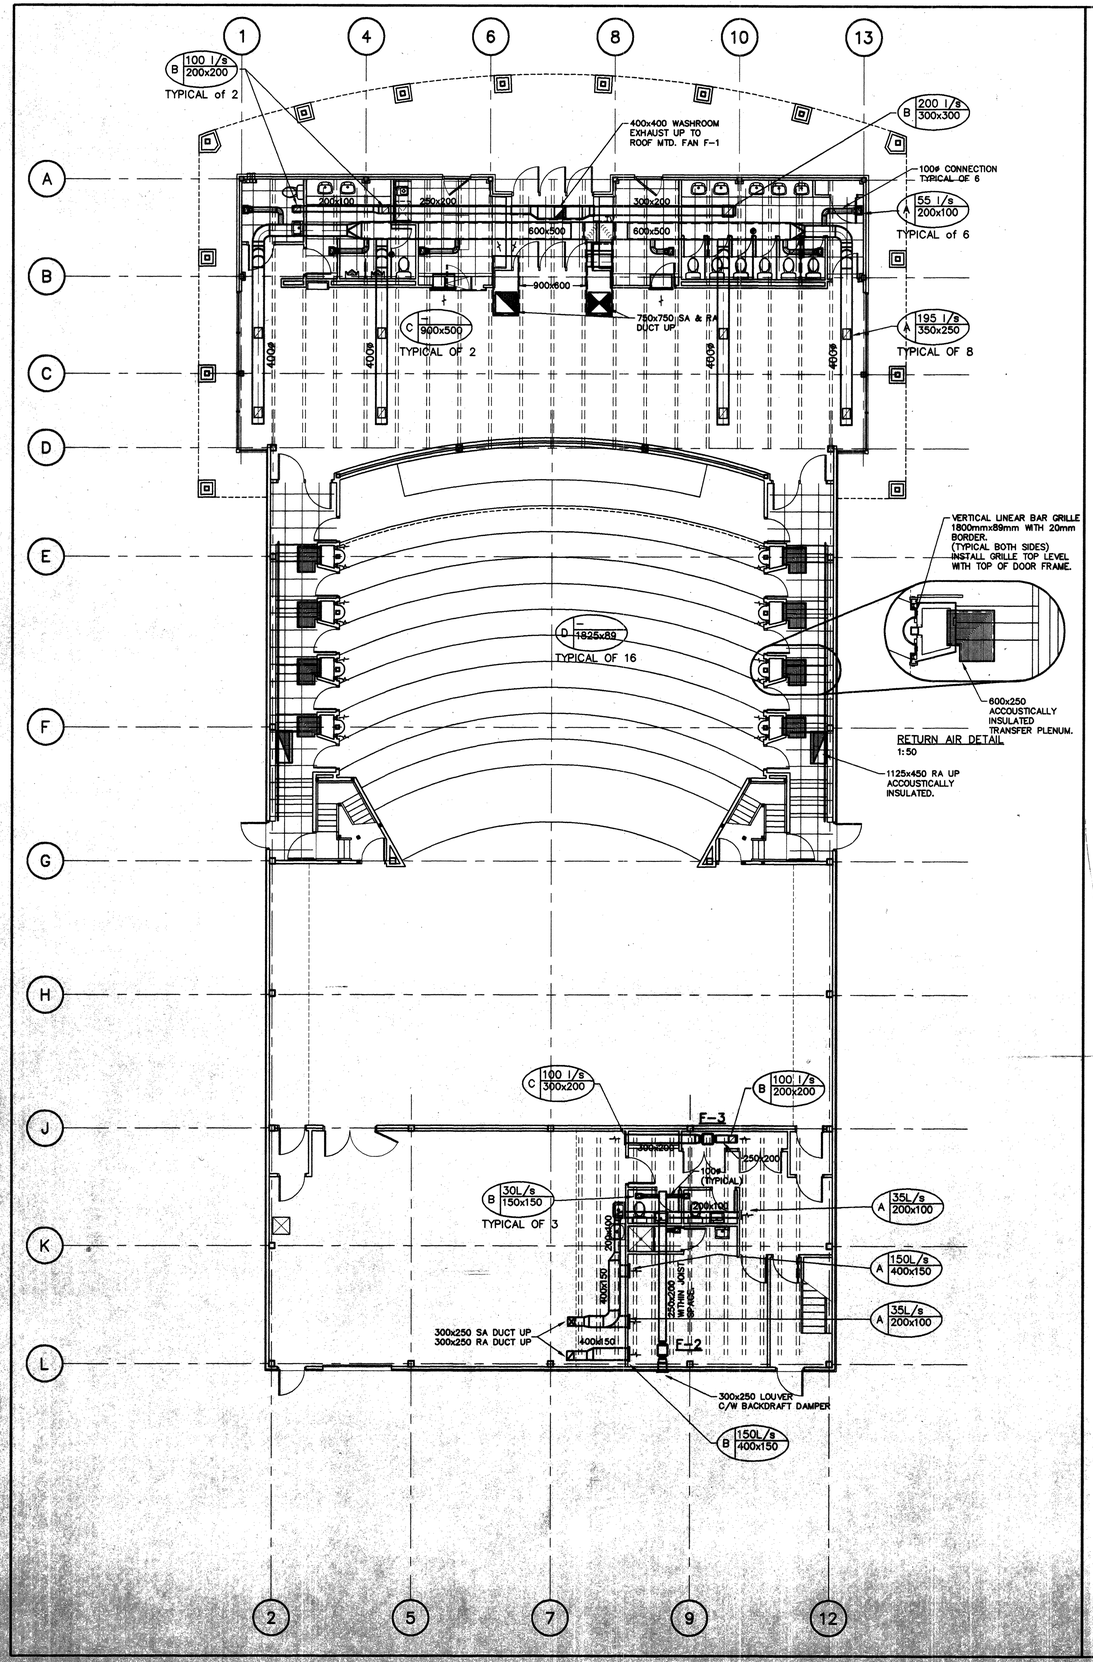

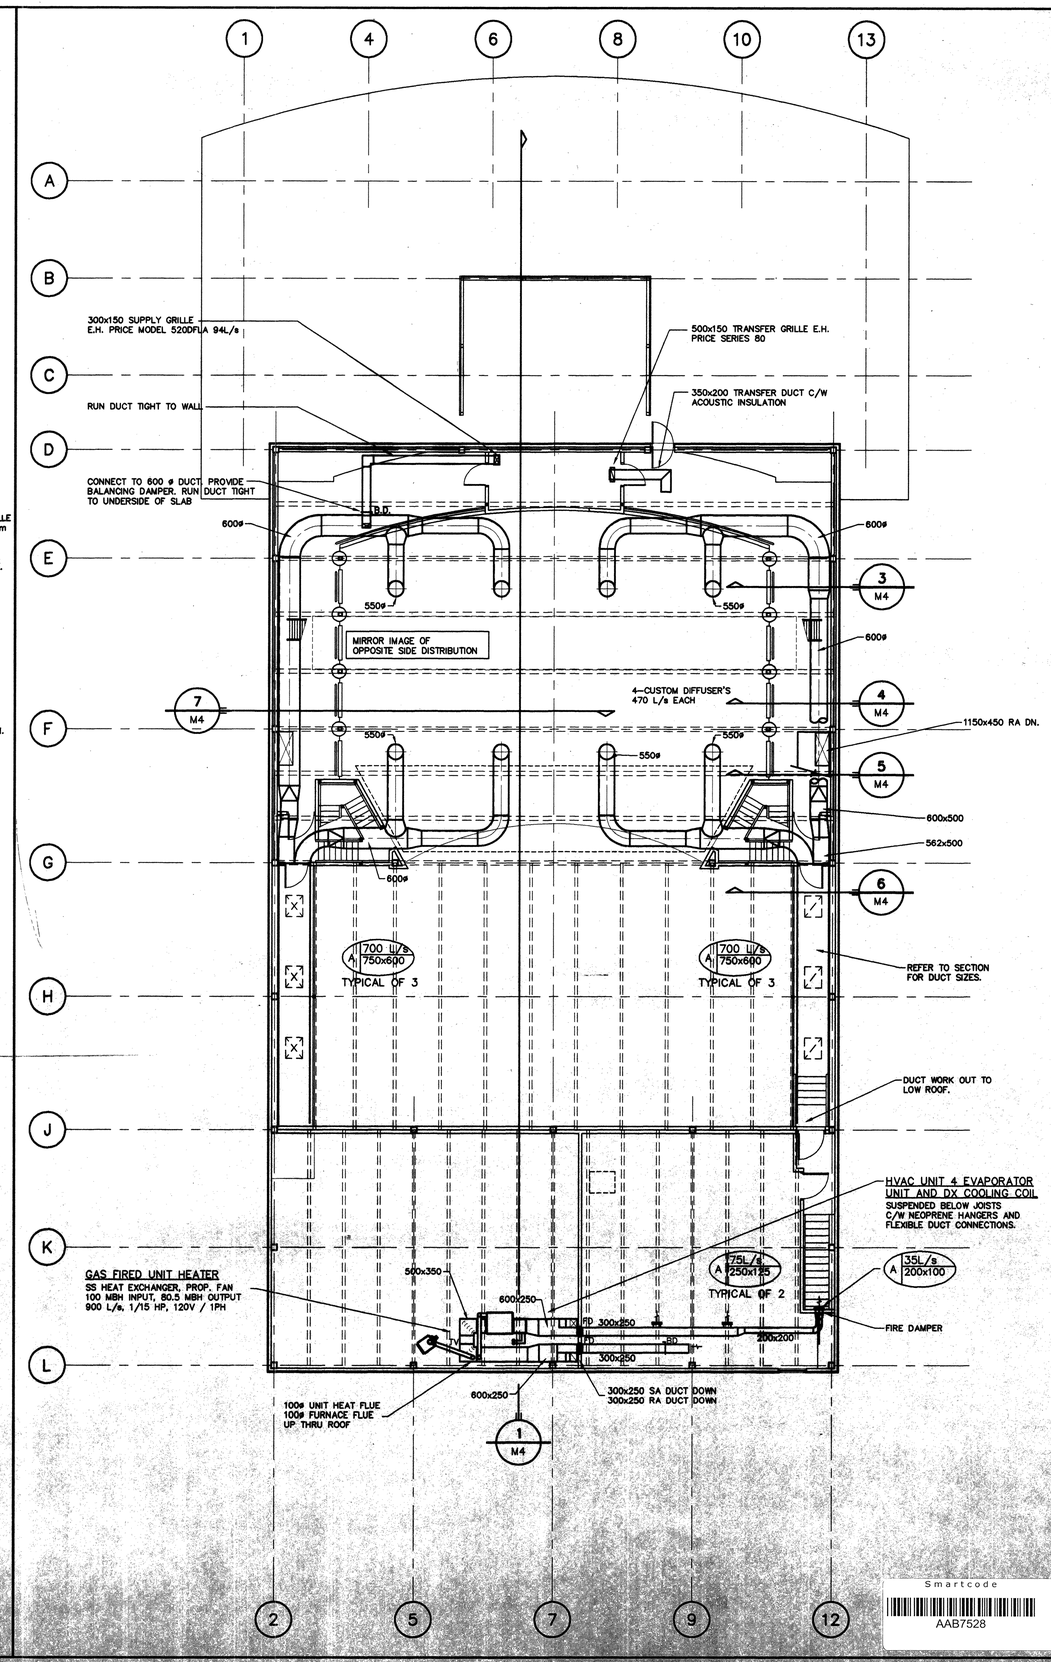

RECORD DRAWING

PRODUCED FROM INFORMATION PROVIDED BY CONTRACTOR. DRAWINGS ARE DIAGRAMATIC. FIELD VERIFICATION IS REQUIRED.

date: MAR., 01, 96 P.G.

J.L. RICHARDS & ASSOCIATES LIMITED

NO.	REVISION	DATE

NO.	ISSUE	DATE
1	ISSUED FOR TENDER	15/5/95

J.L.Richards & Associates Limited
Consulting Engineers, Architects & Planners
864 LADY ELLEN PLACE, OTTAWA, CANADA K1Z 5M2

Lett/Smith Architects - Design Consultants

PROJECT:

CITY OF KANATA THE RON MASLIN PLAYHOUSE

Kanata, Ontario

DRAWING:

MECHANICAL VENTILATION

DESIGN: R. SNOW	REVISION NO.:
DRAWN:	DRAWING NO.: M3 of 5
CHECKED: R.SNOW	
DATE: MAY 1995	
SCALE: 1:100	JOB NO.: 14456

Smartcode AAB7528